


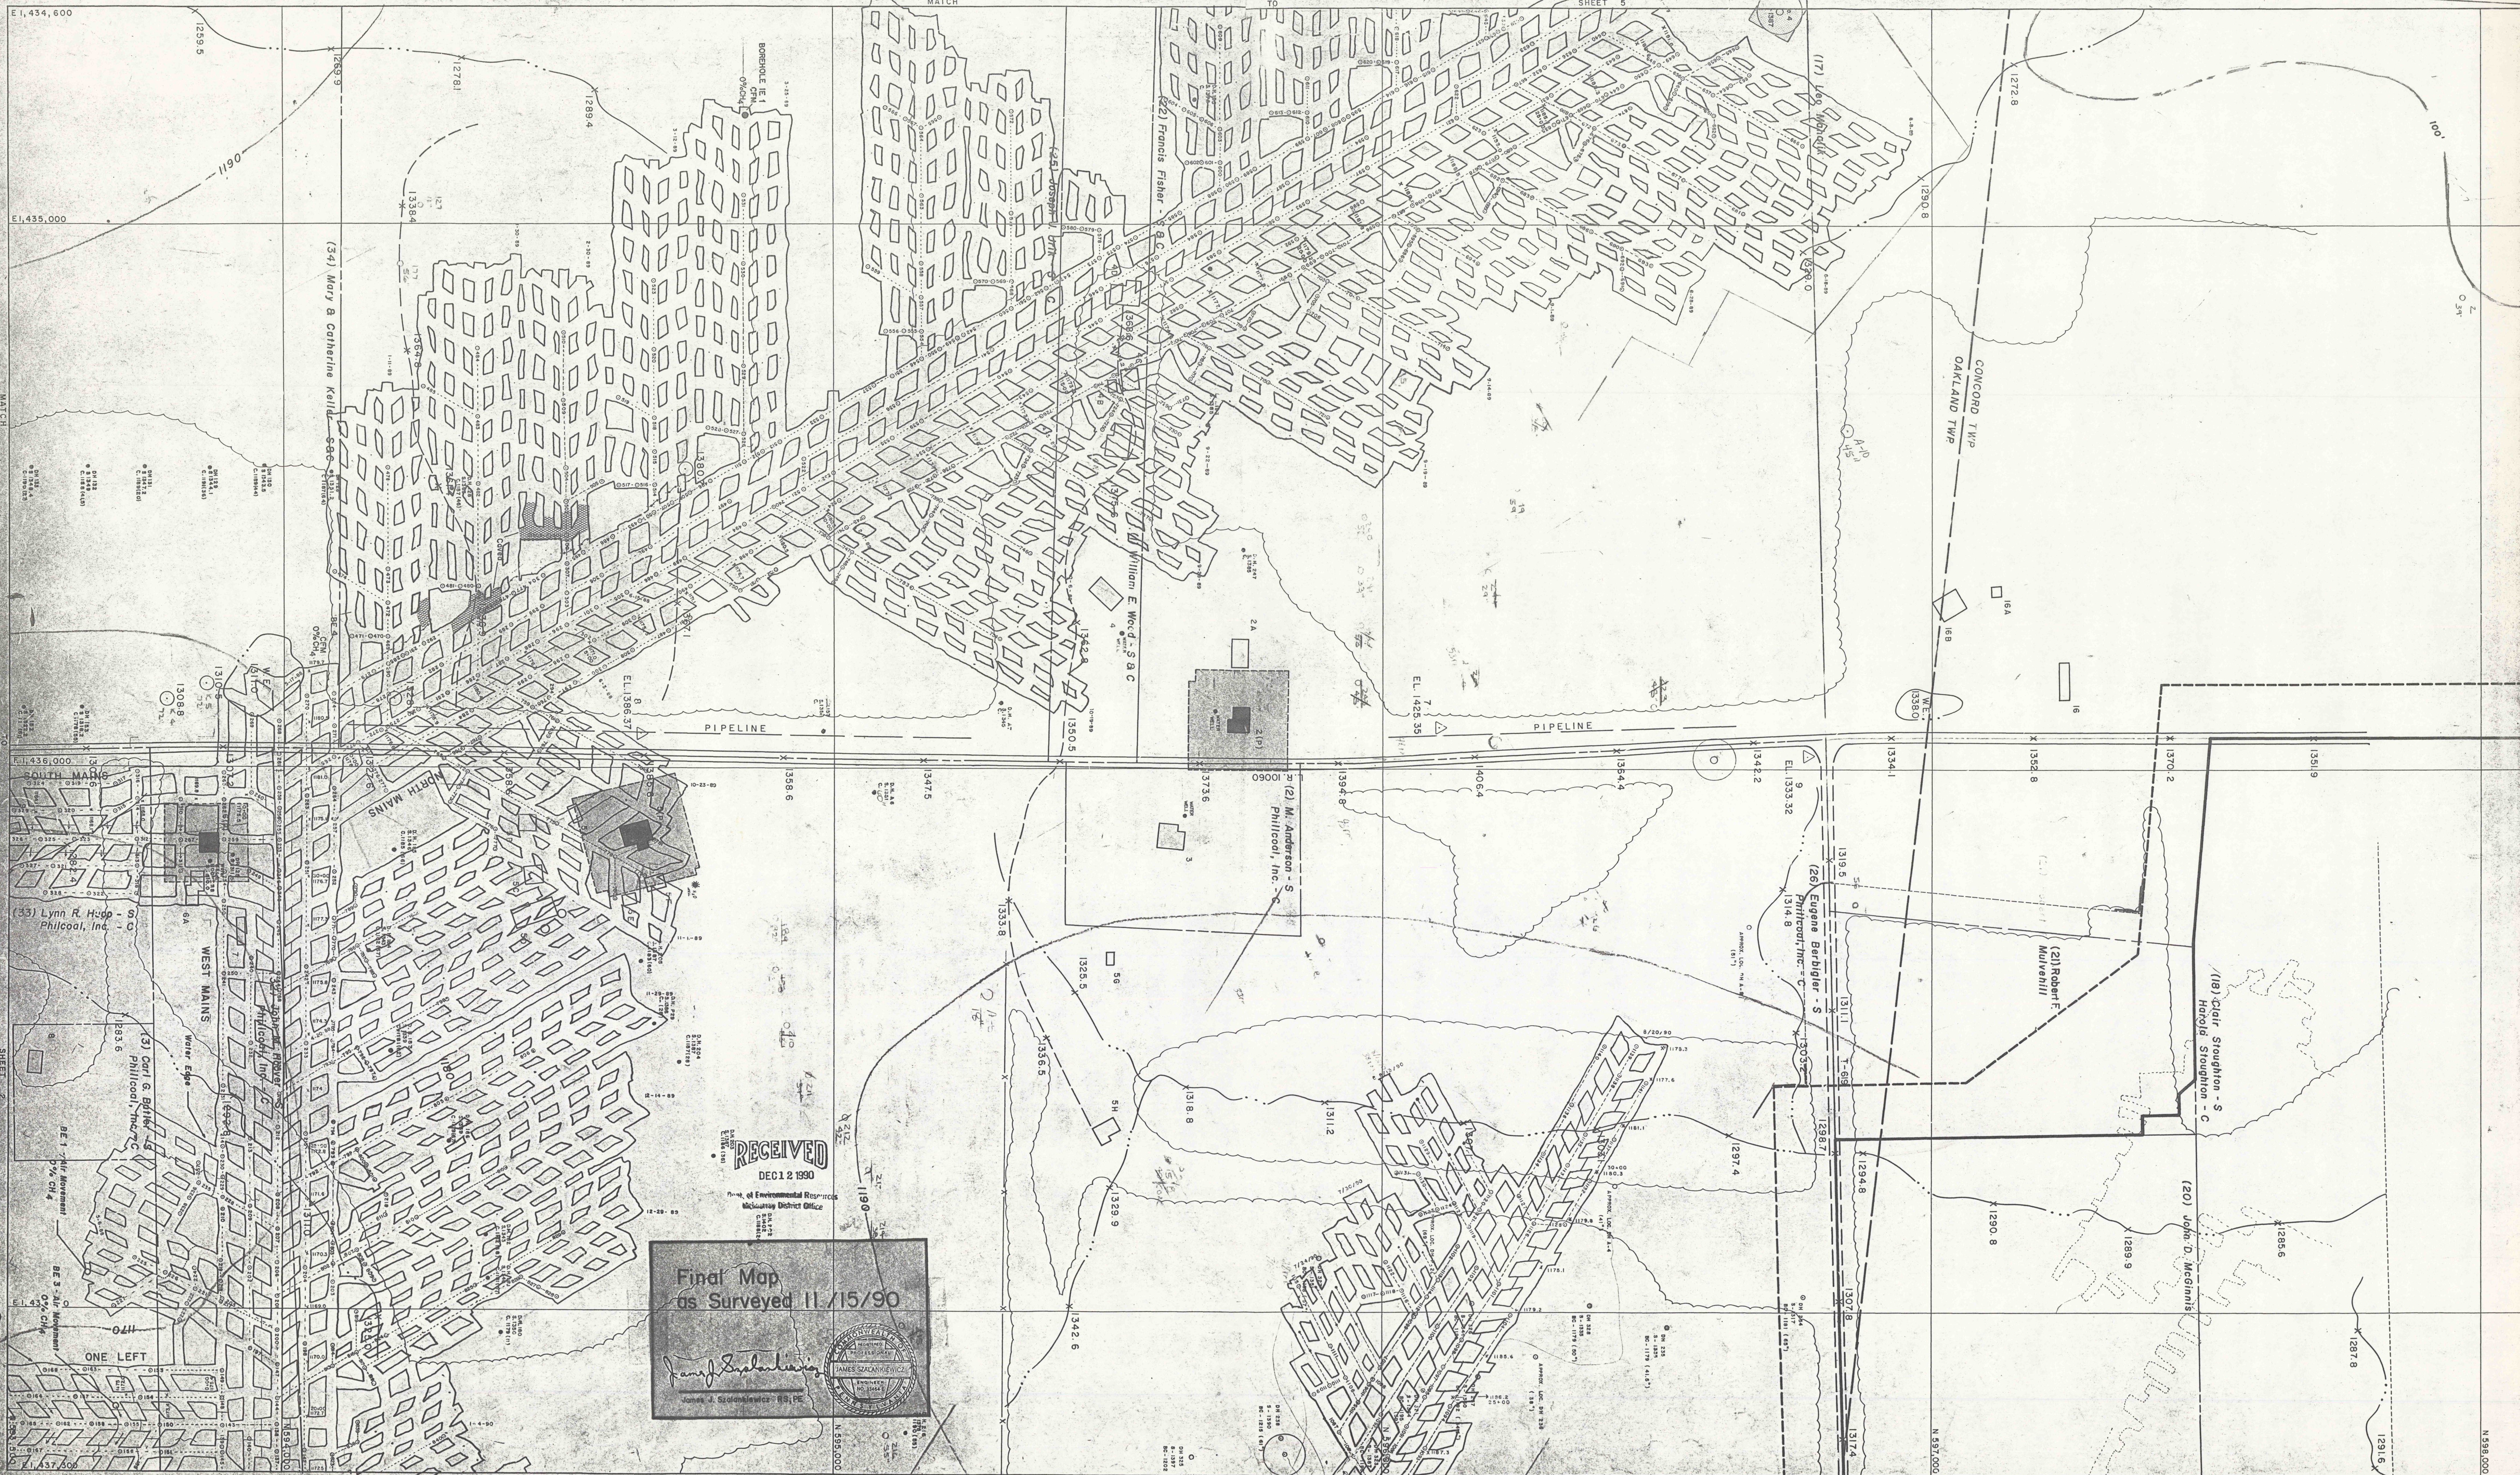

CHICORA NO. 1 MINE
DARMAC ASSOCIATES CORP.
Oakland, Donagel, & Concord Townships
Butler County

MINING PERIOD : 4-1-90 to 10-1-90
PROJECTION No. : 7
SURVEY DATE : 8-20-90

MAPS 19125