


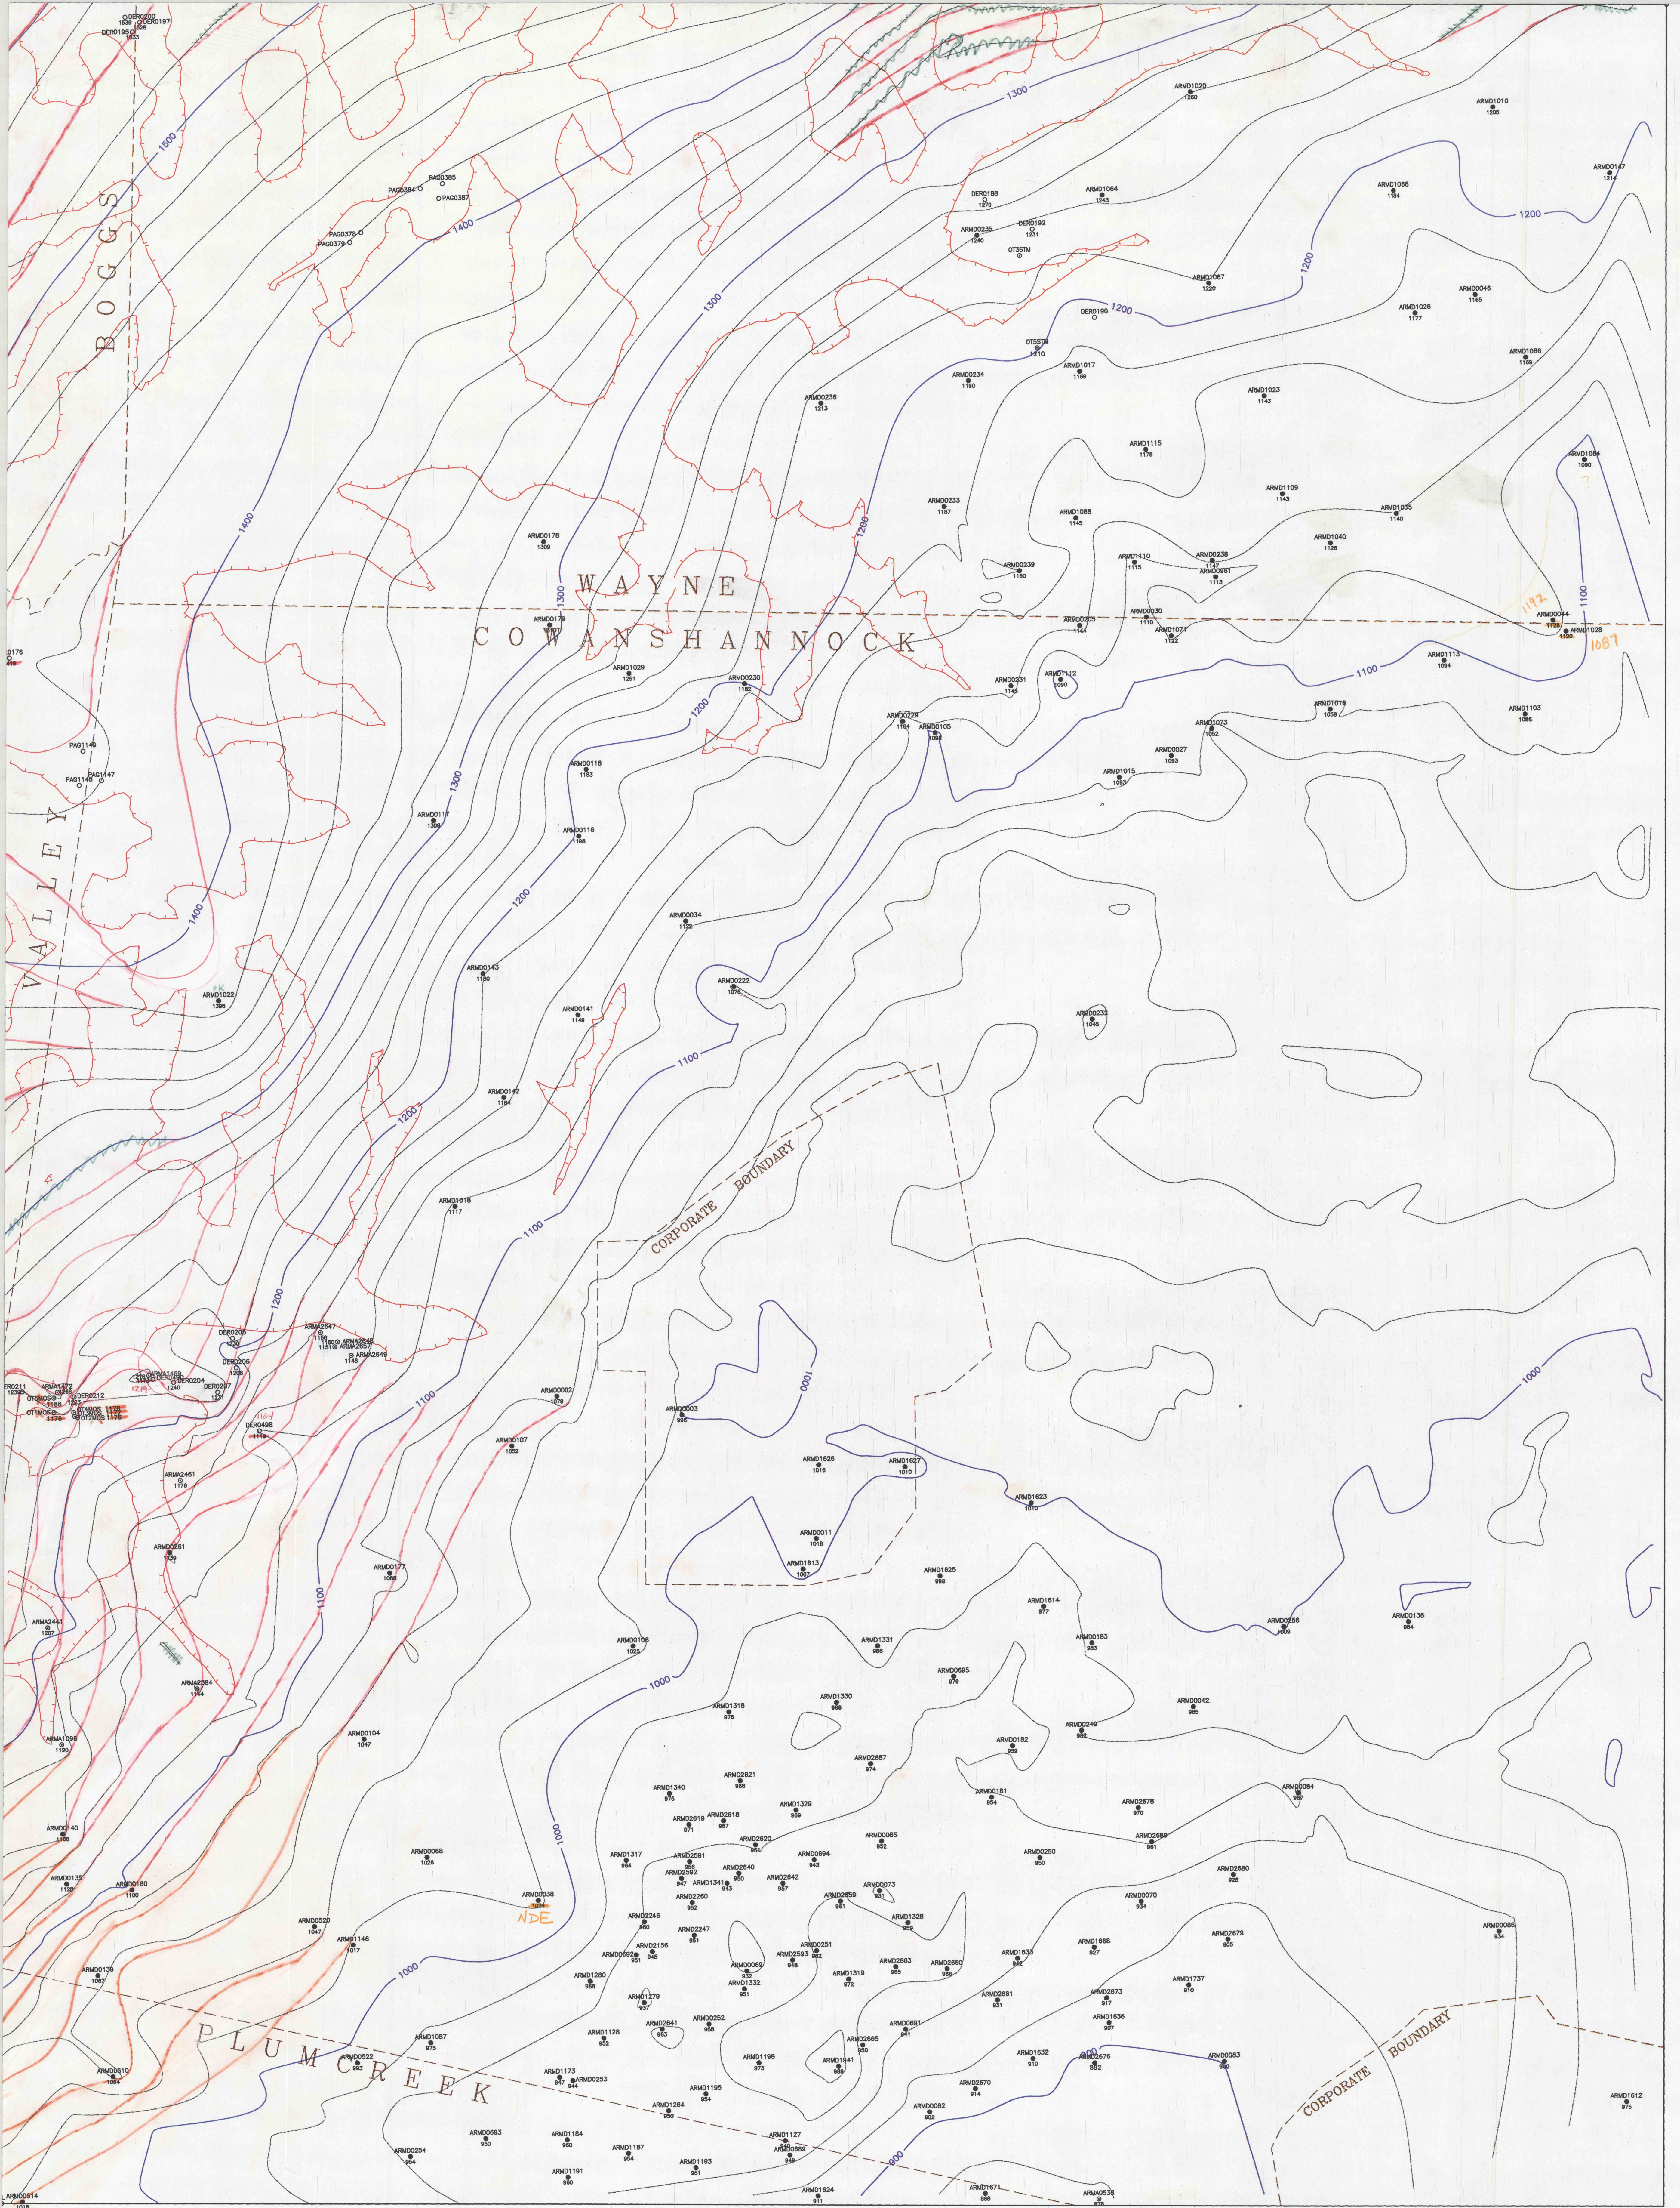

DATE : WED DEC 11 21:41:54 1991
PROJECT : K:\ARM\RV.NEW
TITLE : LOWER FREEPORT STRUCTURE

GRAPHIC SCALE 1"=1200'
0 1200 2400 3600

Rochester & Pittsburgh Coal Co.
Armstrong County
Reserve Evaluation
Project

LOWER FREEPORT STRUCTURE MAP
for the
RURAL VALLEY QUADRANGLE
Scale 1 inch = 1200 feet
DECEMBER 1991

IMAPS 19126