
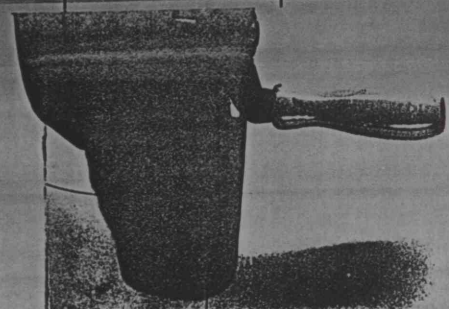
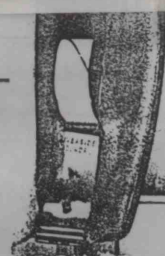
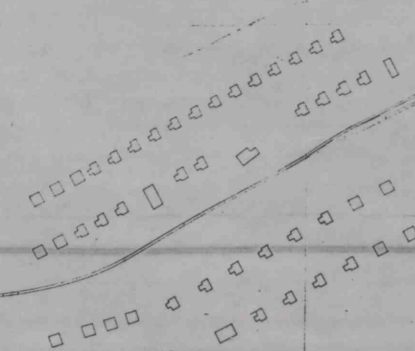
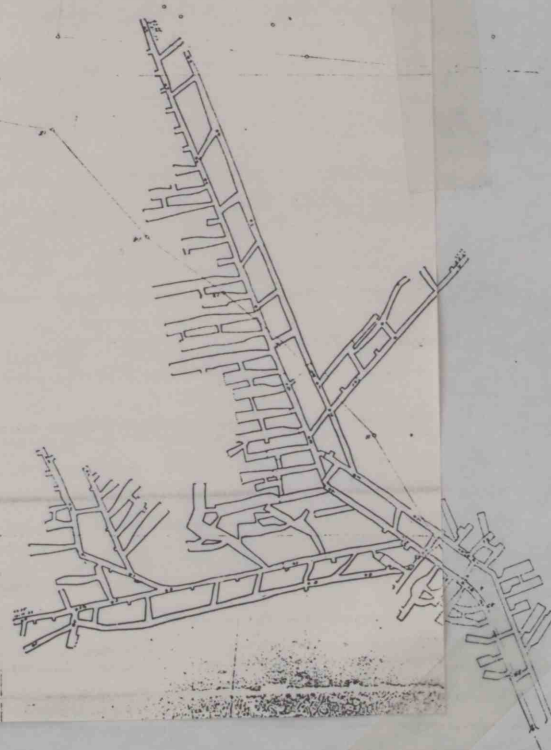
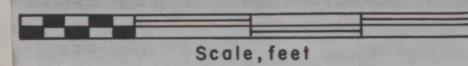


3

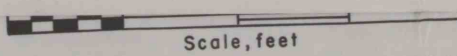

GDF
ENGINEERS

03186 318 14.5X 368147

IMAPS 19127

old copy of
Gilbert mine