


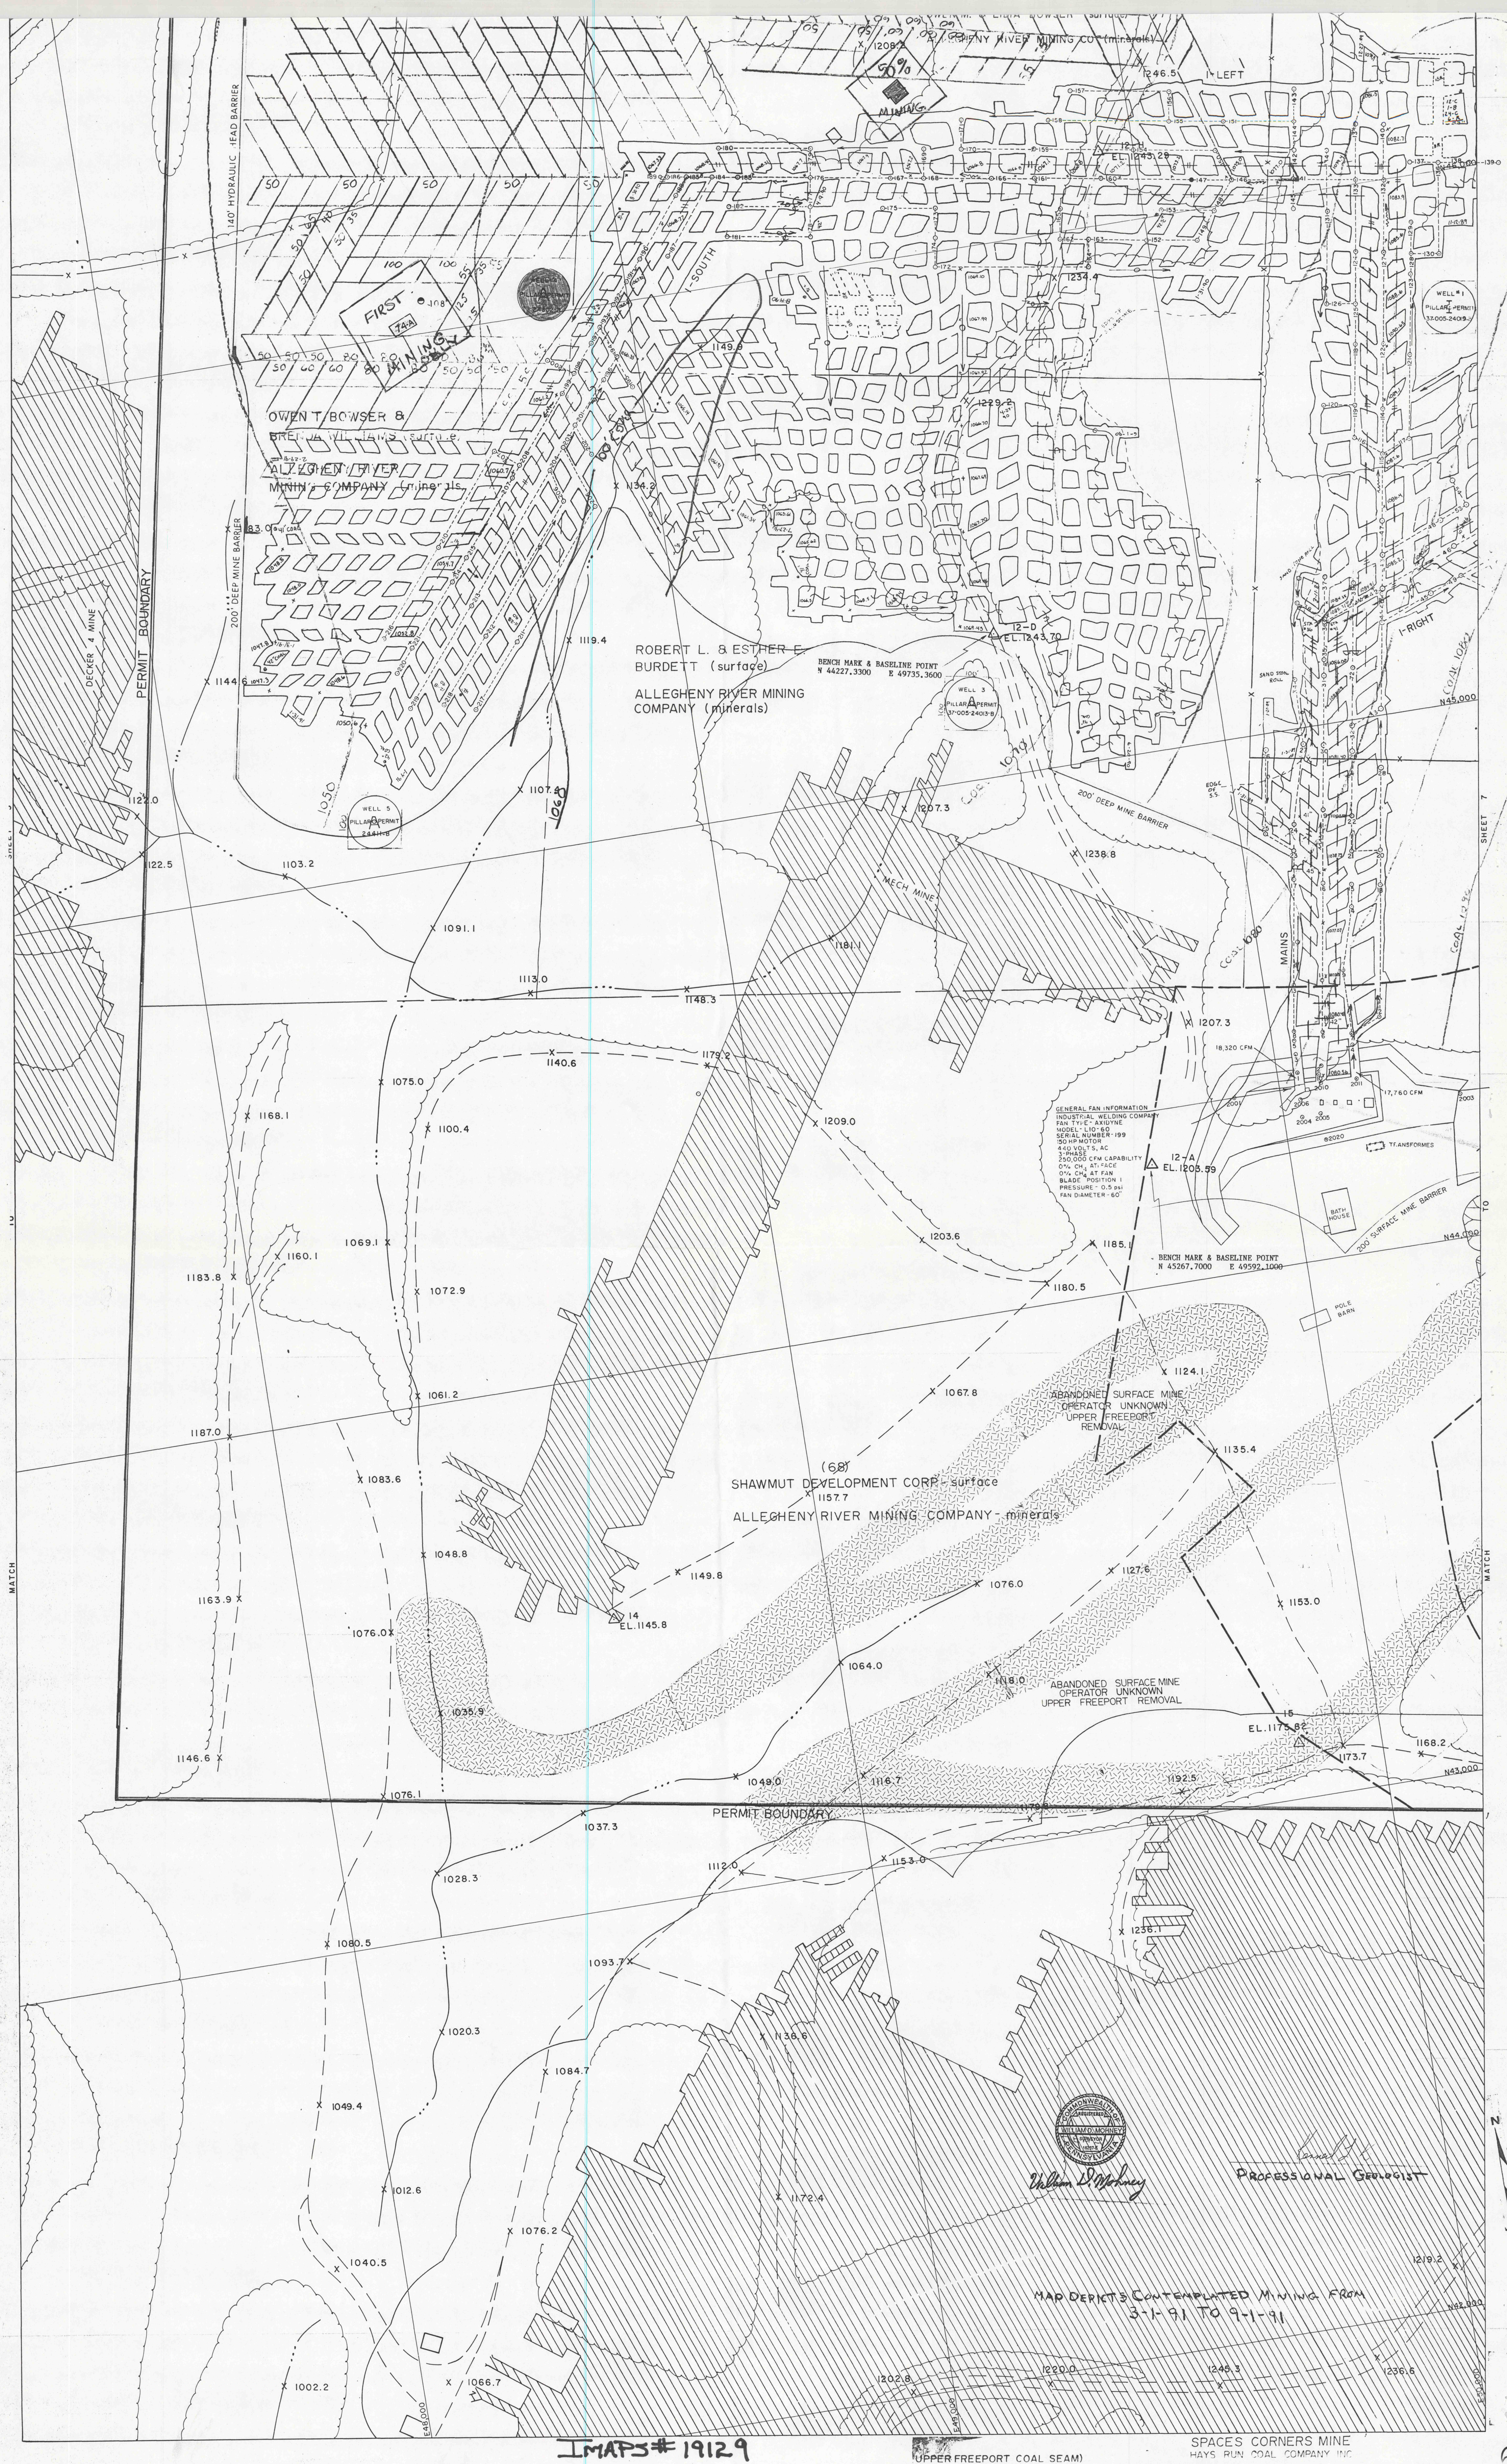

IMAPS# 19129

UPPER FREEPORT COAL SEAM

SPACES CORNERS MINE
HAYS RUN COAL COMPANY INC