


12369-77

2 Copies

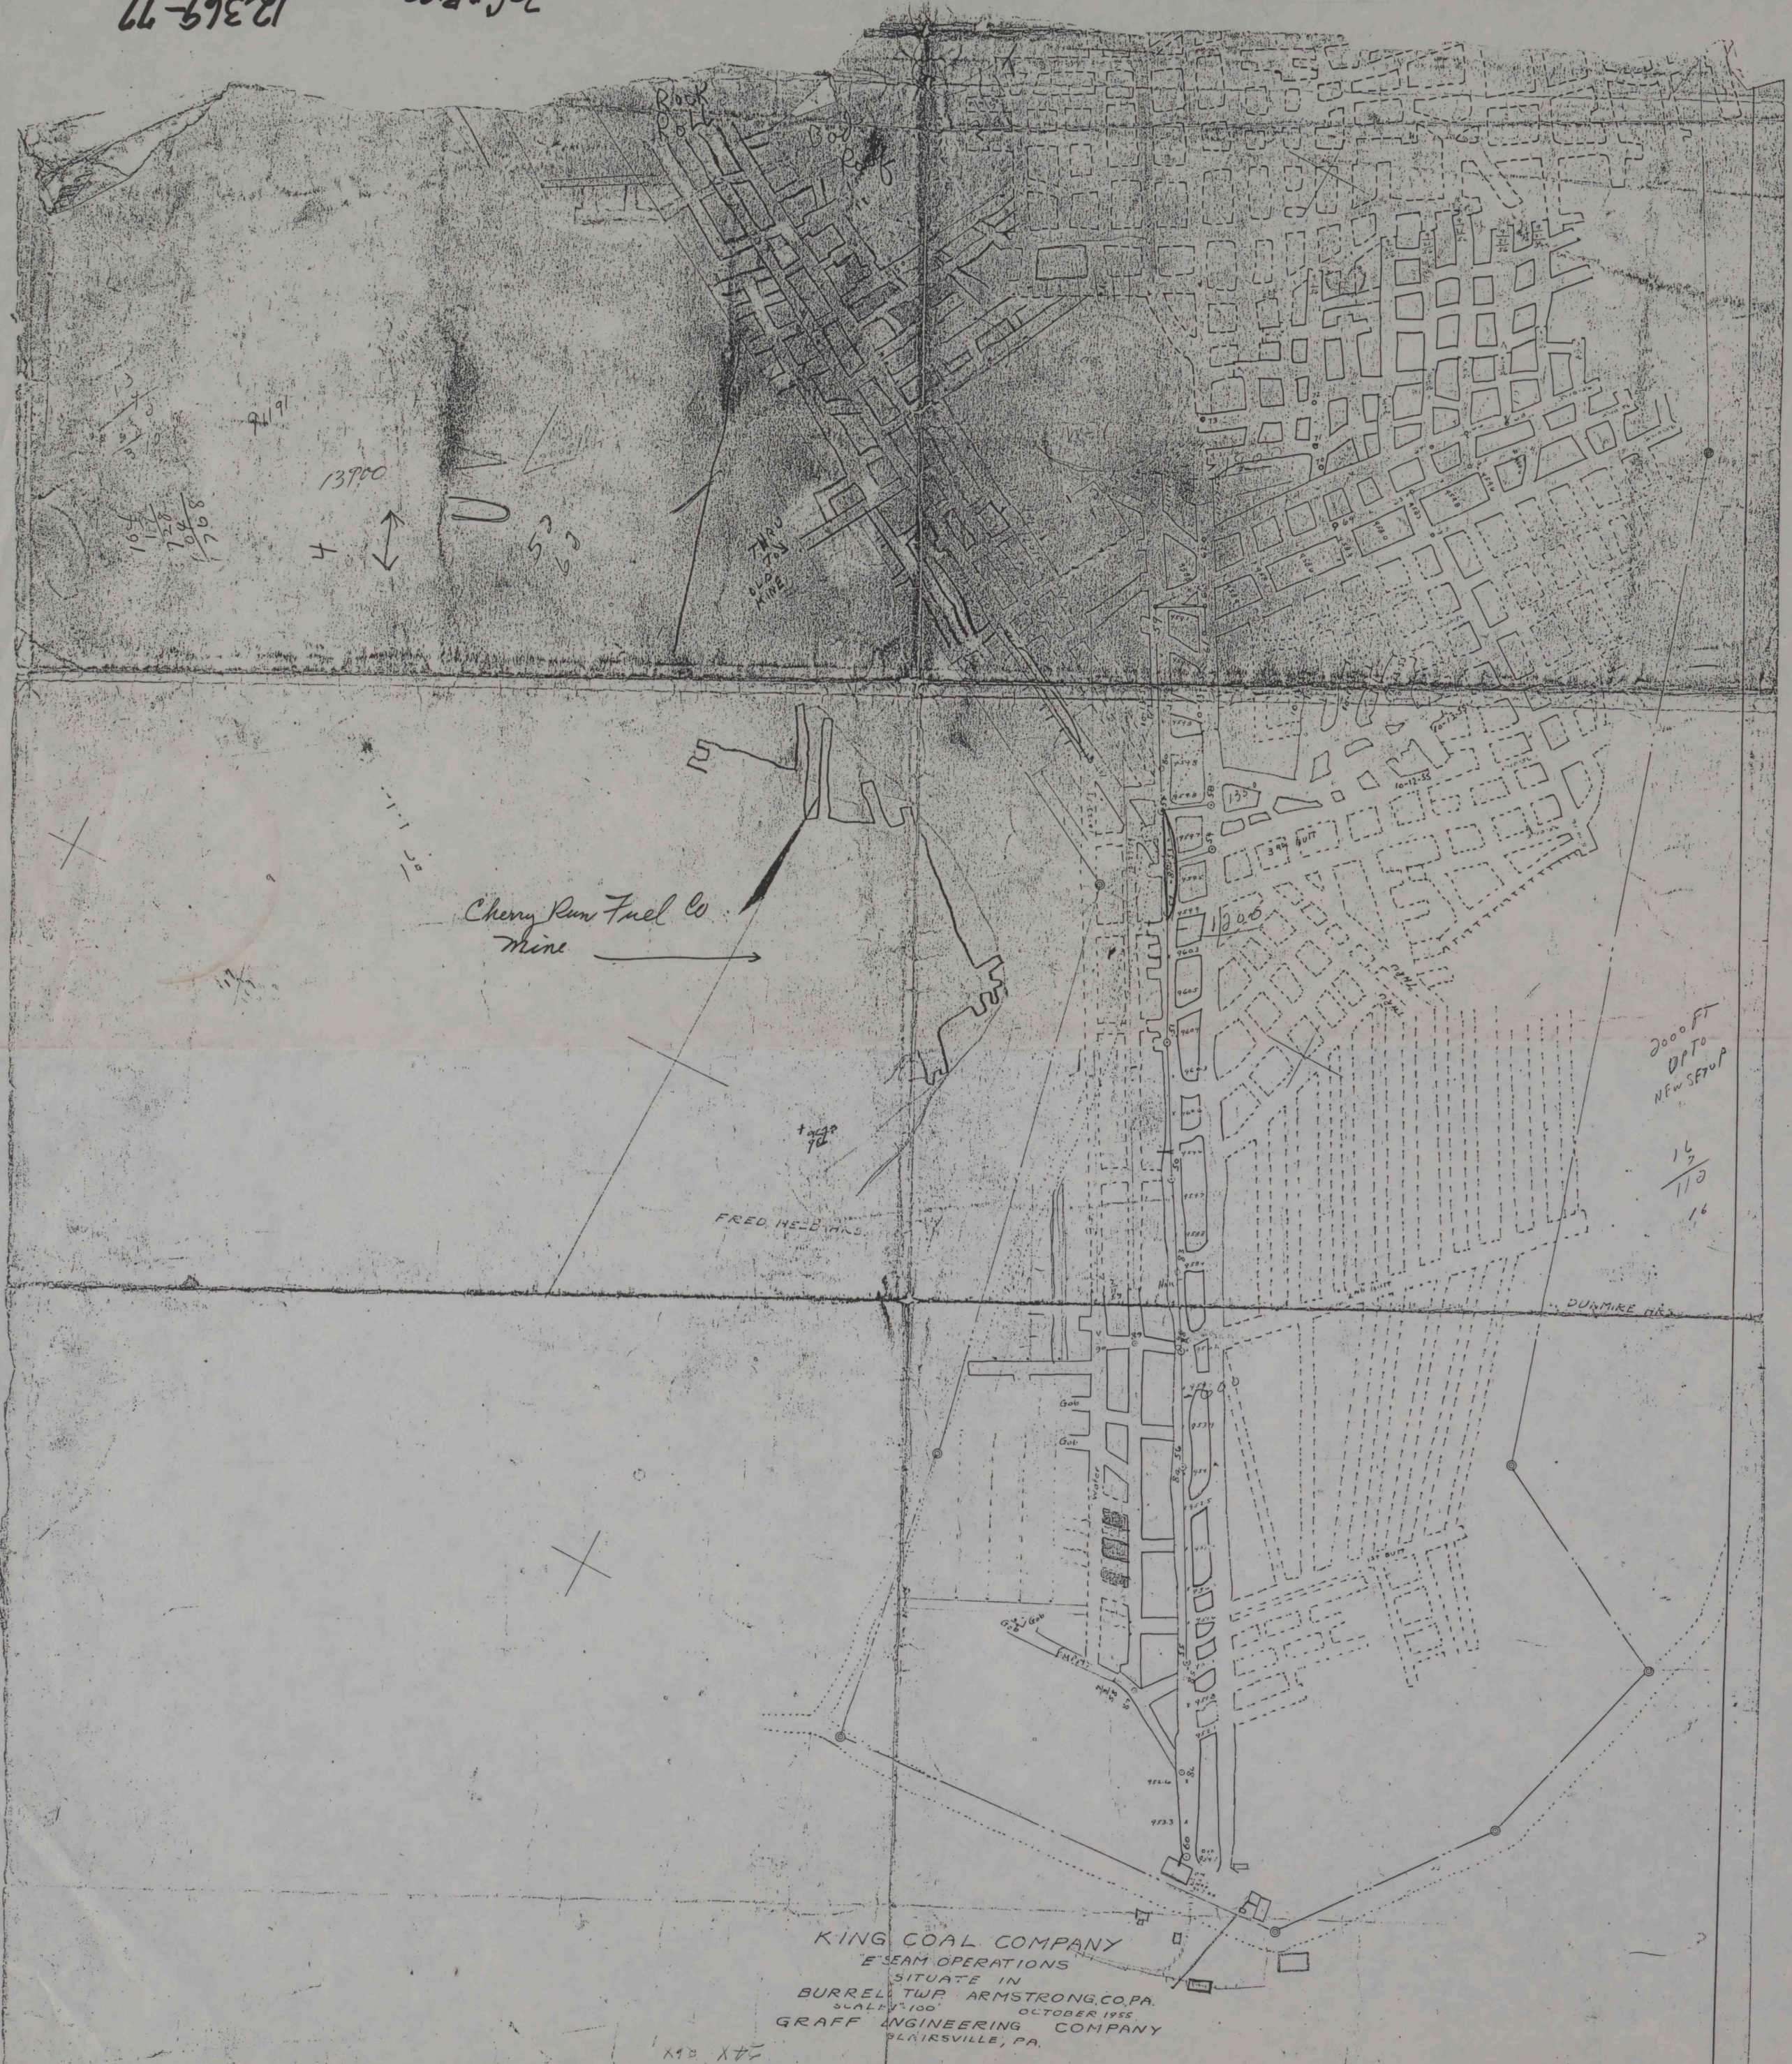

KING COAL COMPANY
E SEAM OPERATIONS
SITUATE IN
BURRELL TWP. ARMSTRONG CO. PA.
SCALE 1"=100' OCTOBER 1955
GRAFF ENGINEERING COMPANY
BLAIRSVILLE, PA.

2000 FT
DPTO
NEW SETUP

16
11/2

12369-77

IMAPS# 14138