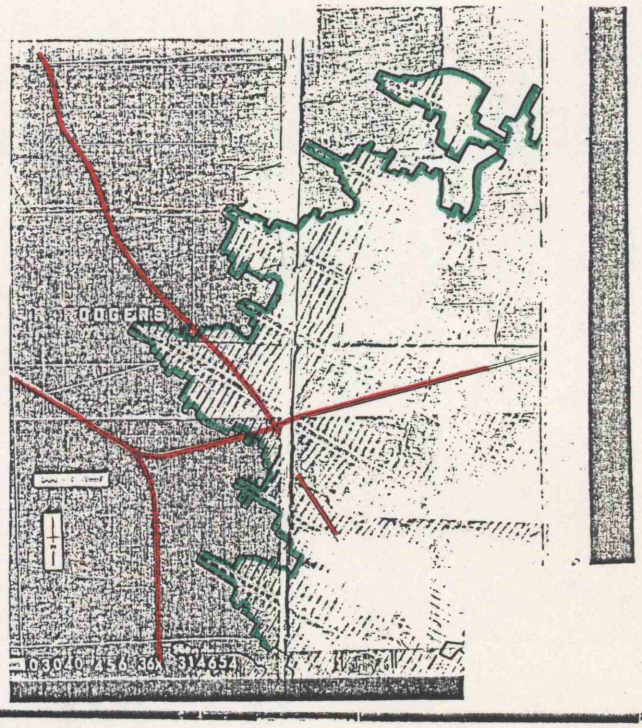

1" = 1,200"

$$\frac{1,200}{.647} = 1854.71$$

$$\frac{1854.71}{.927} =$$

IMAPS # 19139