


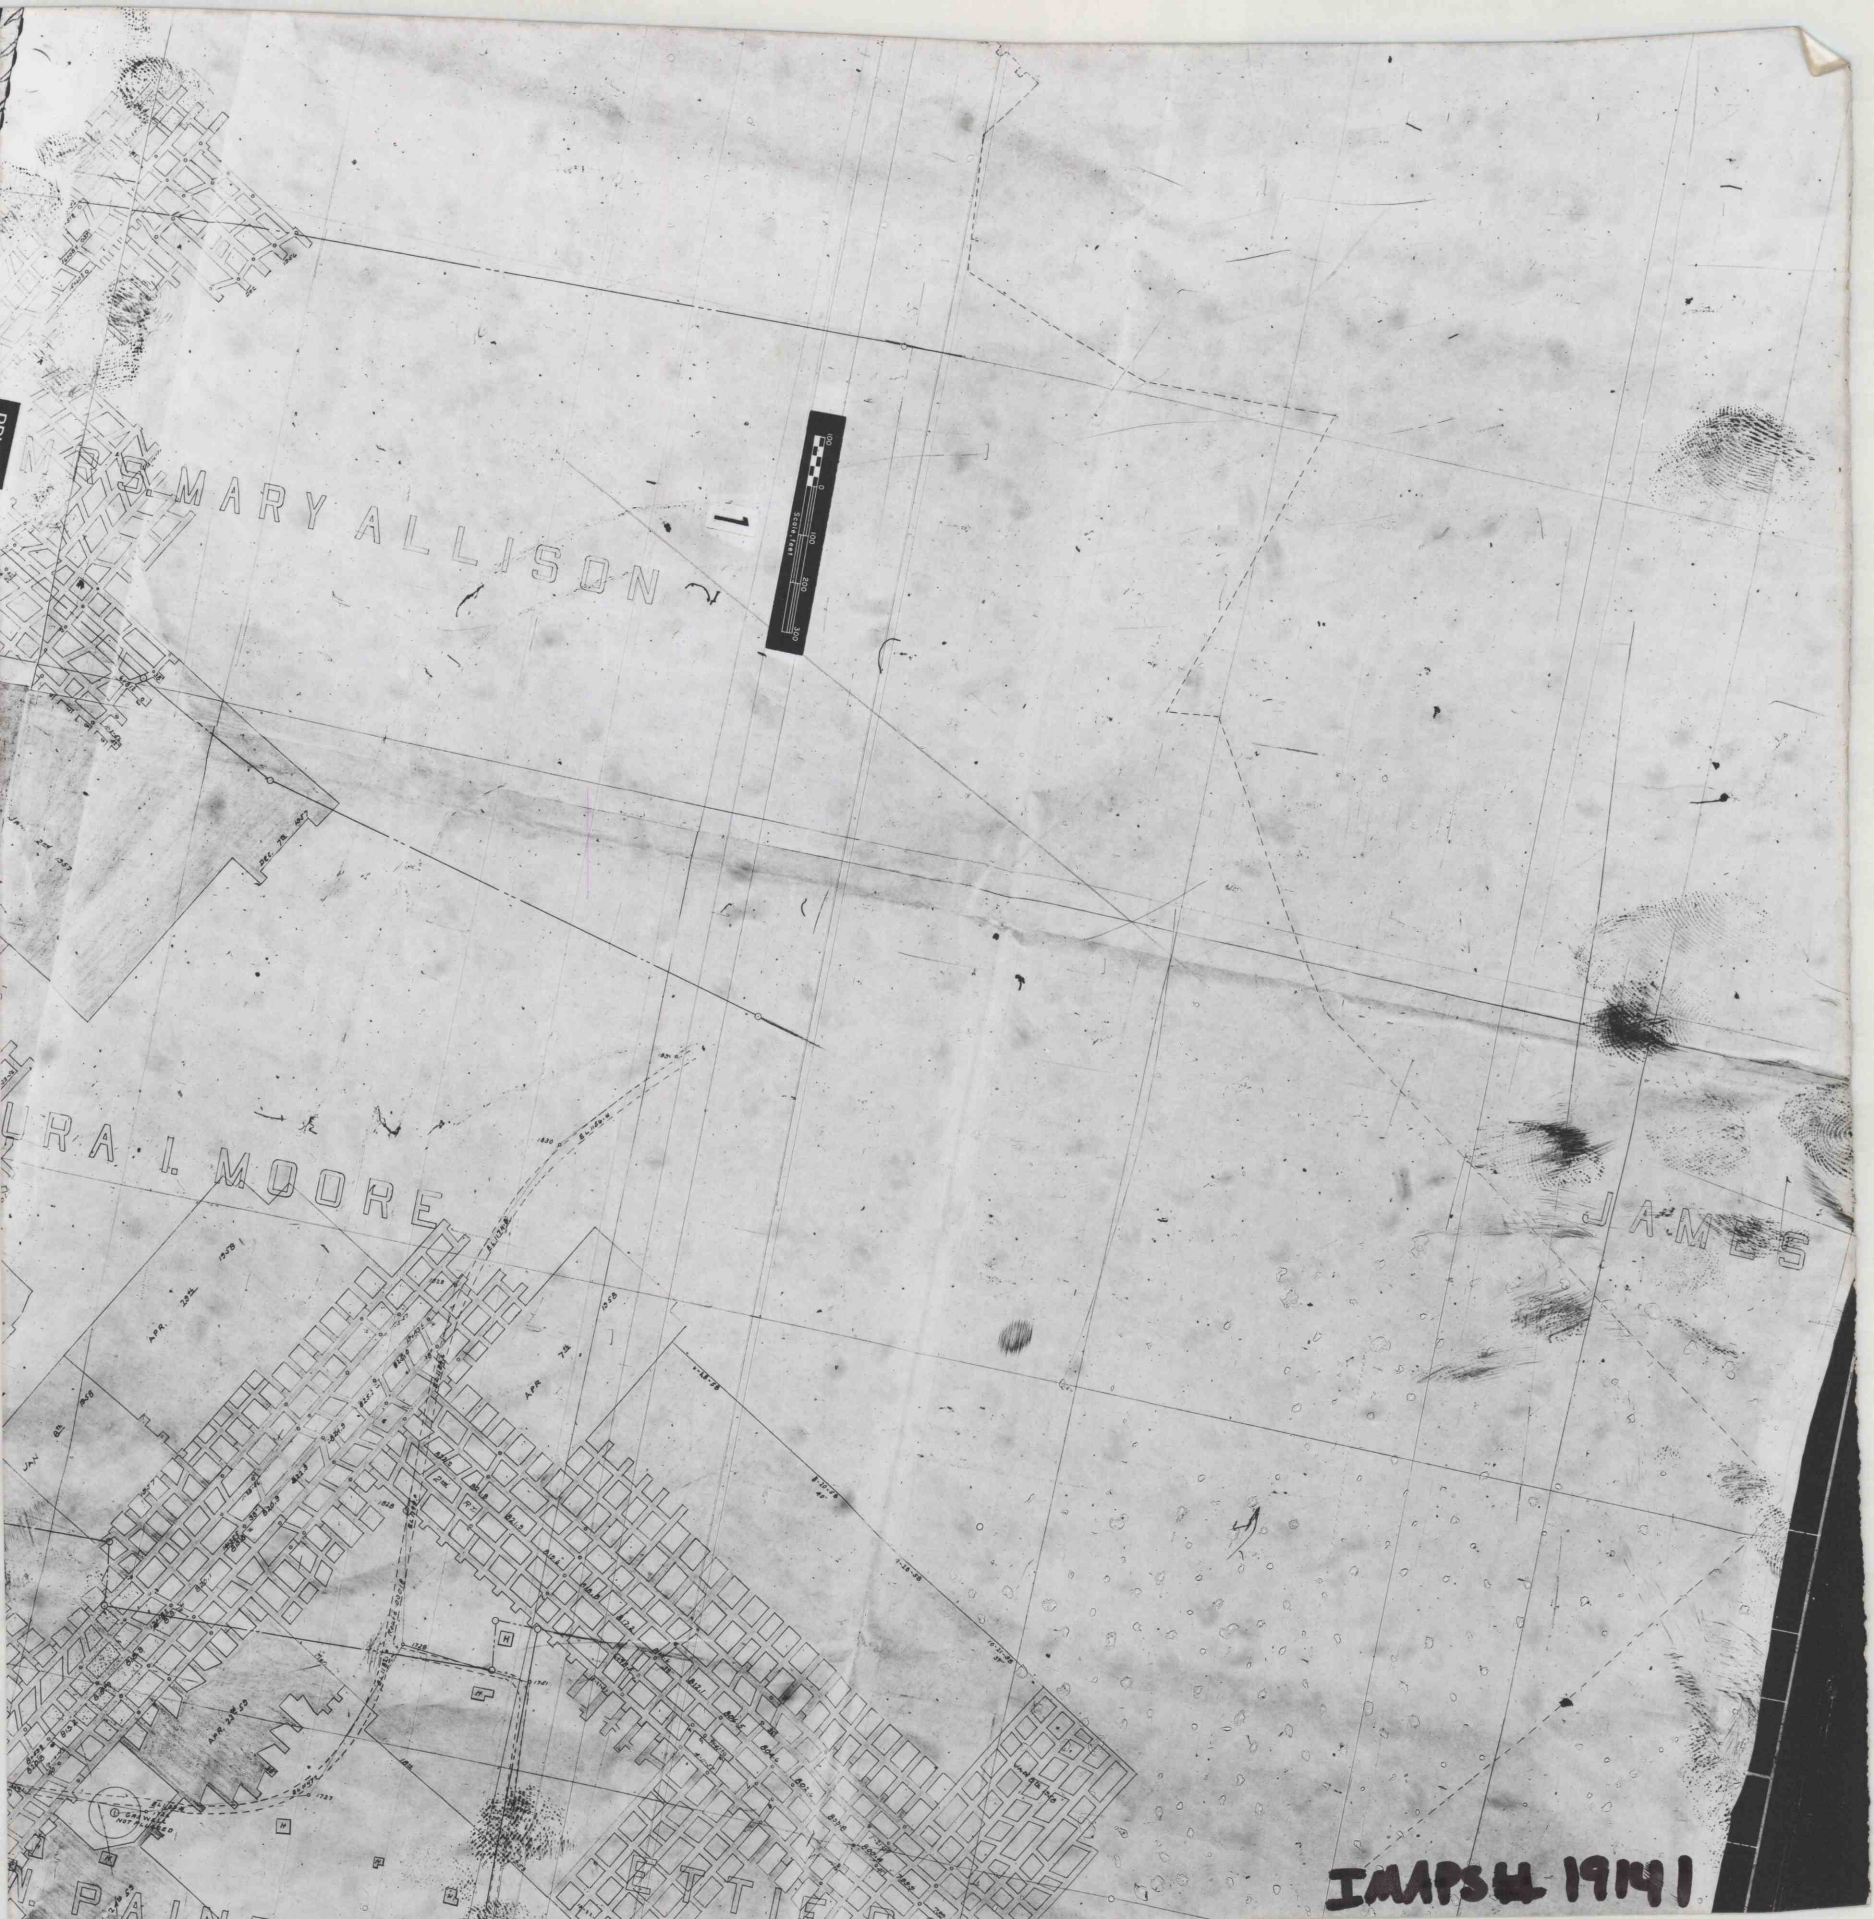

MARY ALLISON

A. I. MOORE

JAMES

PAIN

ETTIE

IMAPSH 19141