


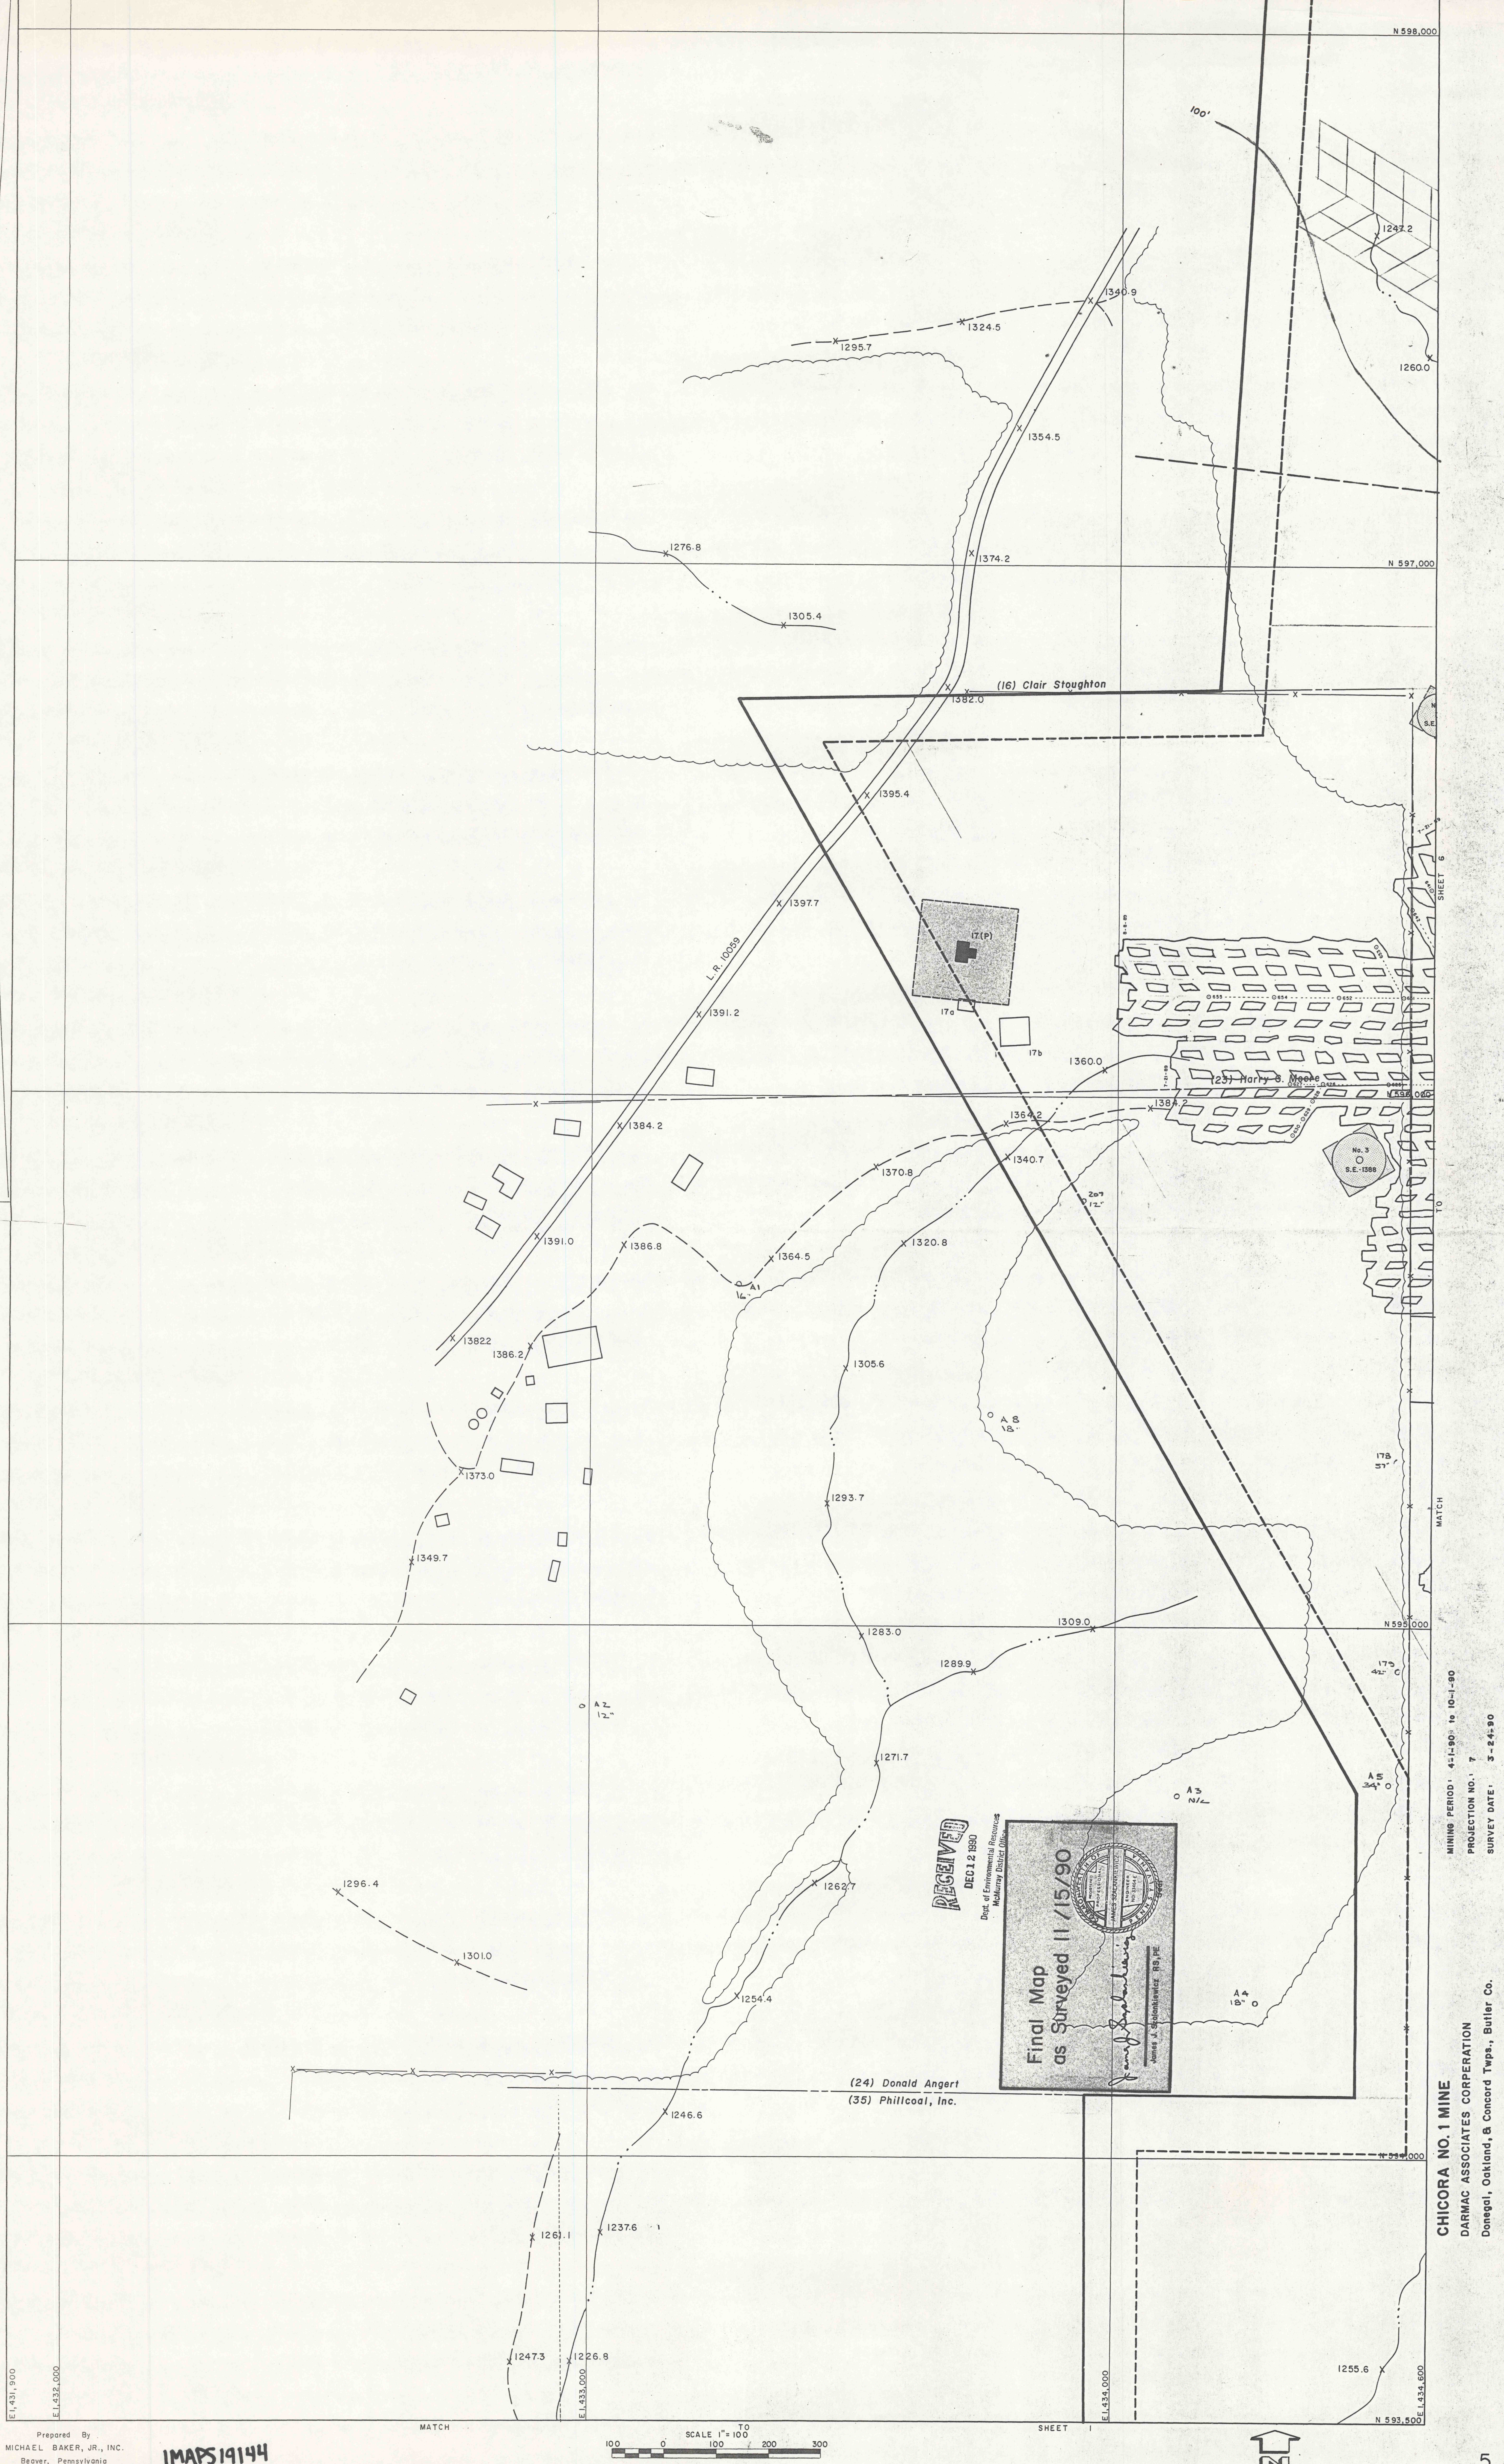

MINING PERIOD: 4-1-90 to 10-1-90
PROJECTION NO.: 7
SURVEY DATE: 3-24-90

CHICORA NO. 1 MINE
DARMAC ASSOCIATES CORPORATION
Donegal, Oakland, & Concord Twp., Butler Co.

CHICORA NO. 1 MINE

DARMAC ASSOCIATES CORPORATION

Donegal, Oakland, & Concord Twps., Butler Co.

CHICORA NO. 1 MINE