


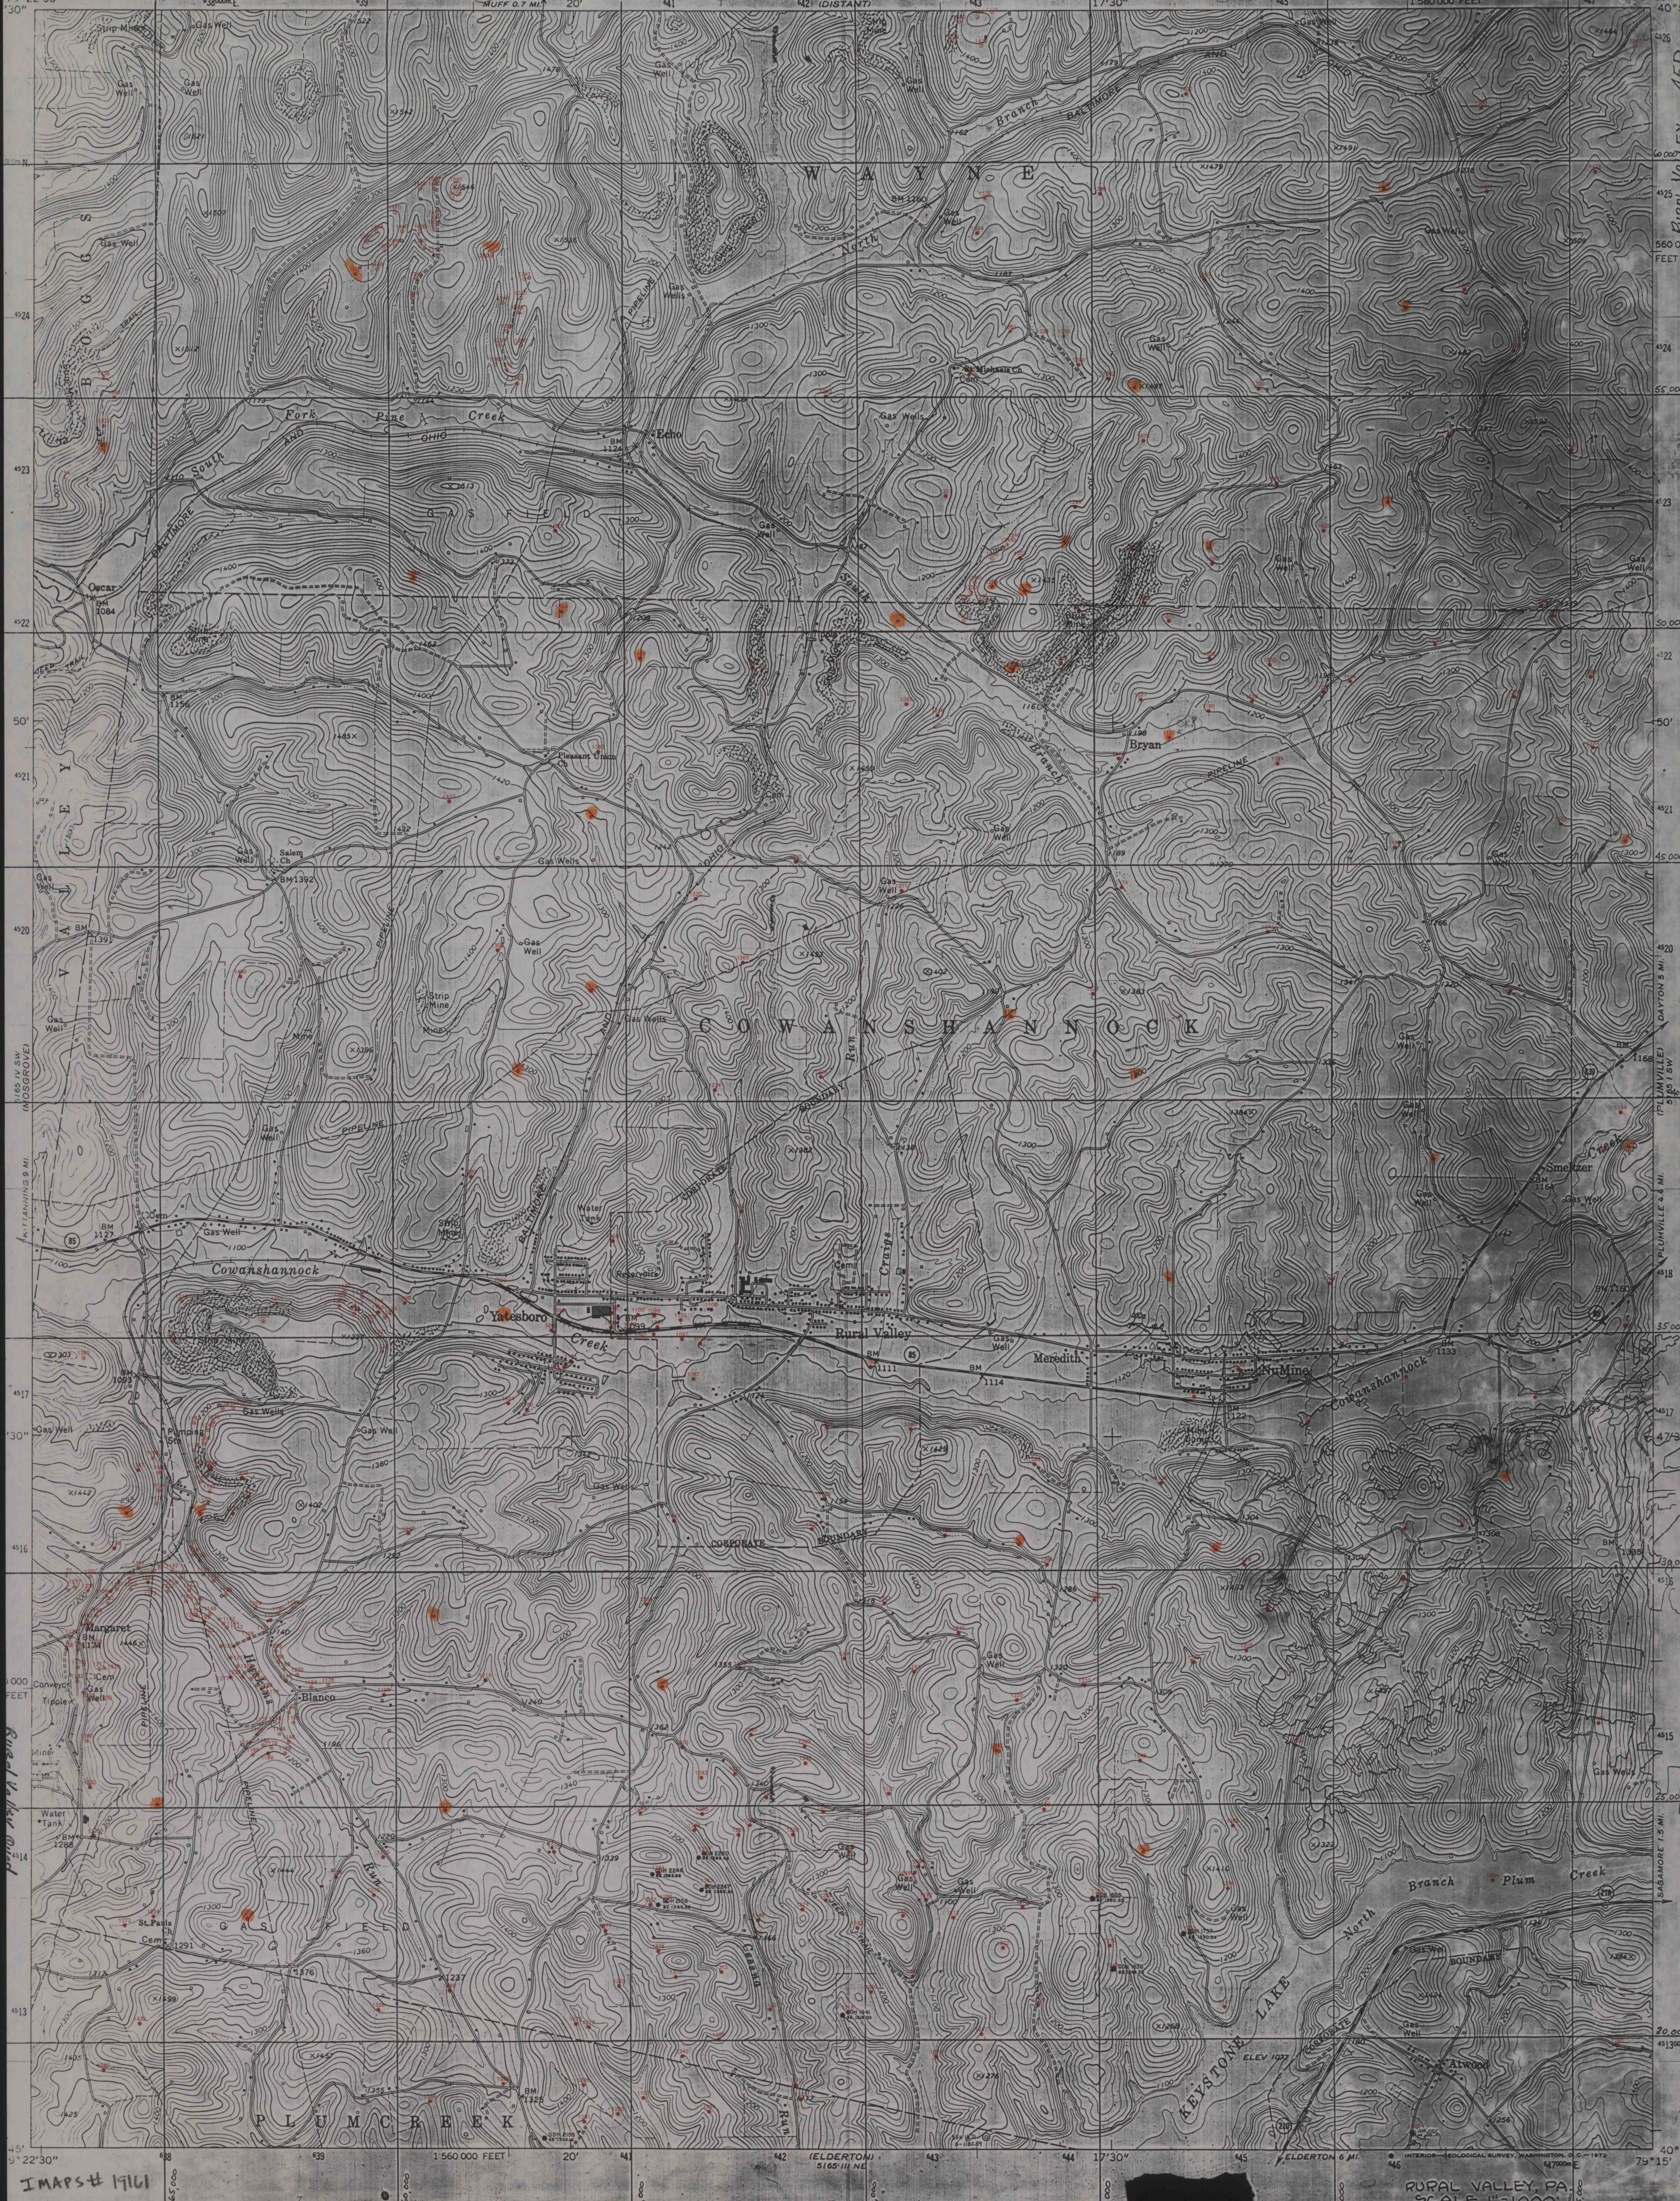


RURAL VALLEY, PA
SCALE 1"=1000'