


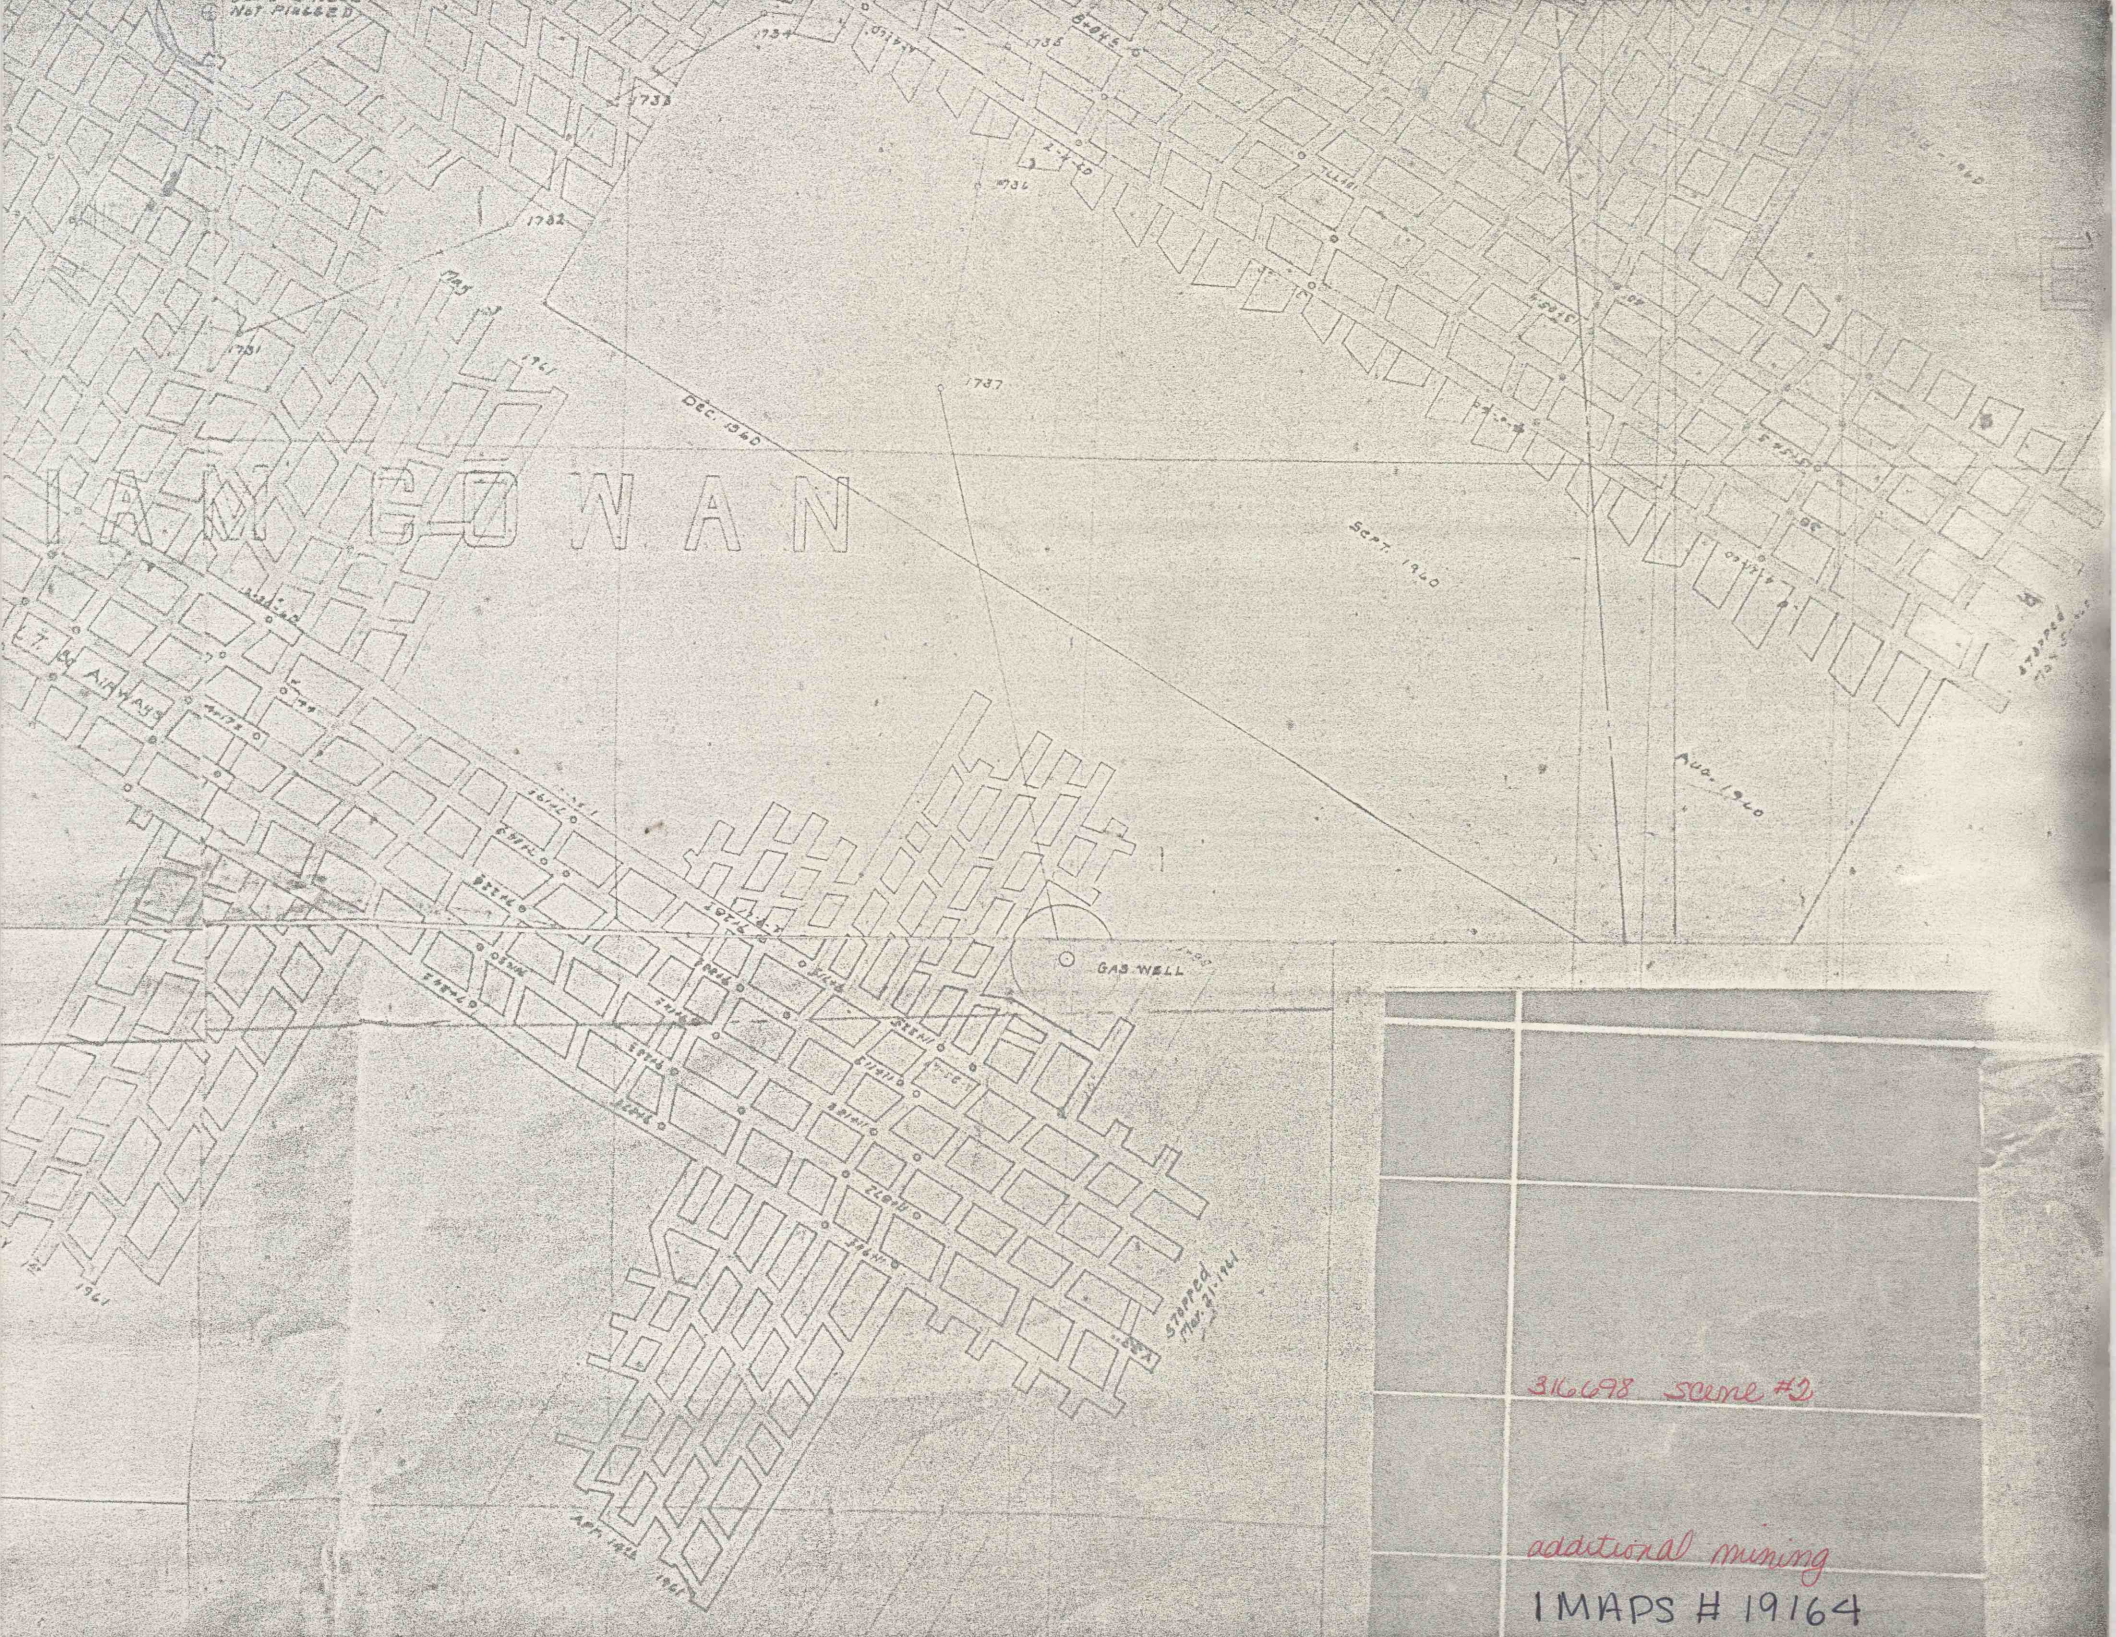

I A M E O W A N

DEC. 1940

SEPT. 1940

AUG. 1940

GAS WELL

STEEPED
MAR. 21, 1941

316698 scene #2

additional mining
IMAPS # 19164