


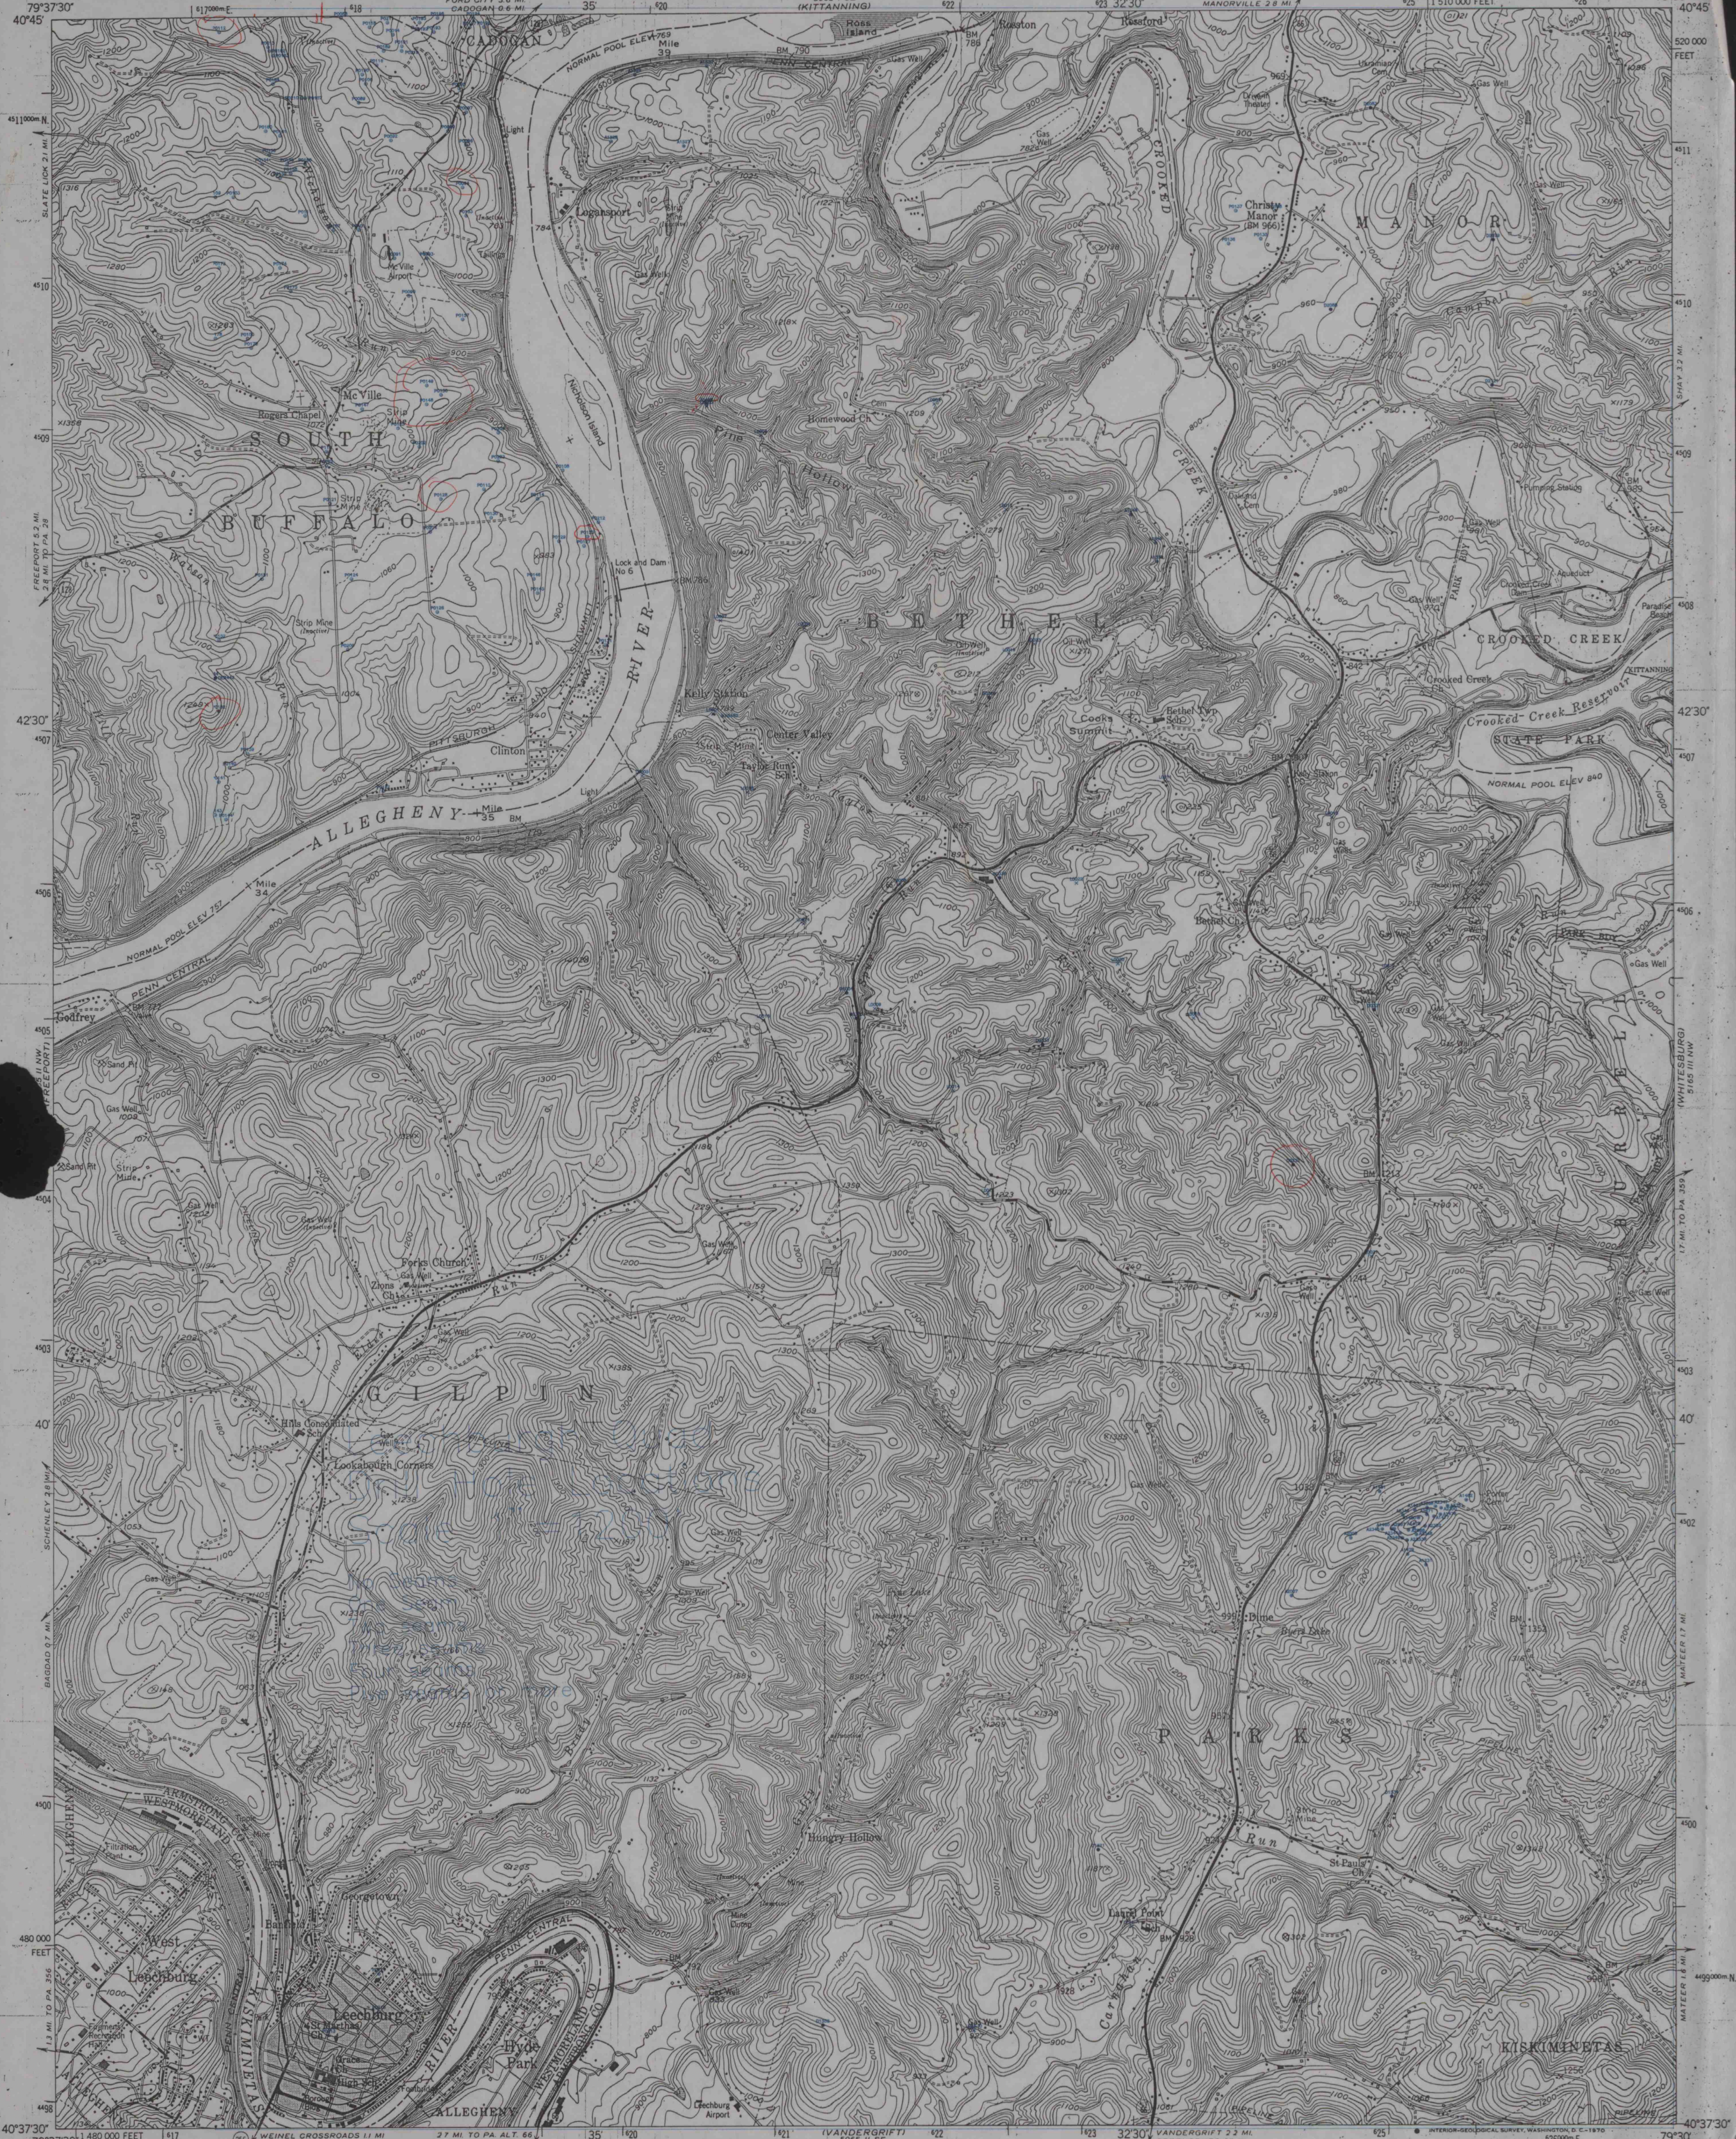

Mapped, edited, and published by the Geological Survey
Control by USGS and USC&GS
Topography from aerial photographs by multiplex methods
Aerial photographs taken 1952. Field check 1954
Polyconic projection. 1927 North American datum
10,000-foot grid based on Pennsylvania coordinate system, south zone
1000-meter Universal Transverse Mercator grid ticks, zone 17,
shown in blue
Red tint indicates area in which only landmark buildings are shown
Area covered by dashed light-blue pattern
is subject to controlled inundation
Revisions shown in purple compiled in cooperation with

IMAPS19166

SCALE 1:24000
CONTOUR INTERVAL 20 FEET
DATUM IS MEAN SEA LEVEL
THIS MAP COMPLIES WITH NATIONAL MAP ACCURACY STANDARDS
FOR SALE BY U.S. GEOLOGICAL SURVEY, WASHINGTON, D. C. 20242

ROAD CLASSIFICATION
Heavy-duty ————— Light-duty —————
Medium-duty ————— Unimproved dirt —————
○ State Route

PENNSYLVANIA
QUADRANGLE LOCATION

LEECHBURG, PA.
NE/4 FREEPORT 15' QUADRANGLE
N4037.5—W7930.7.5