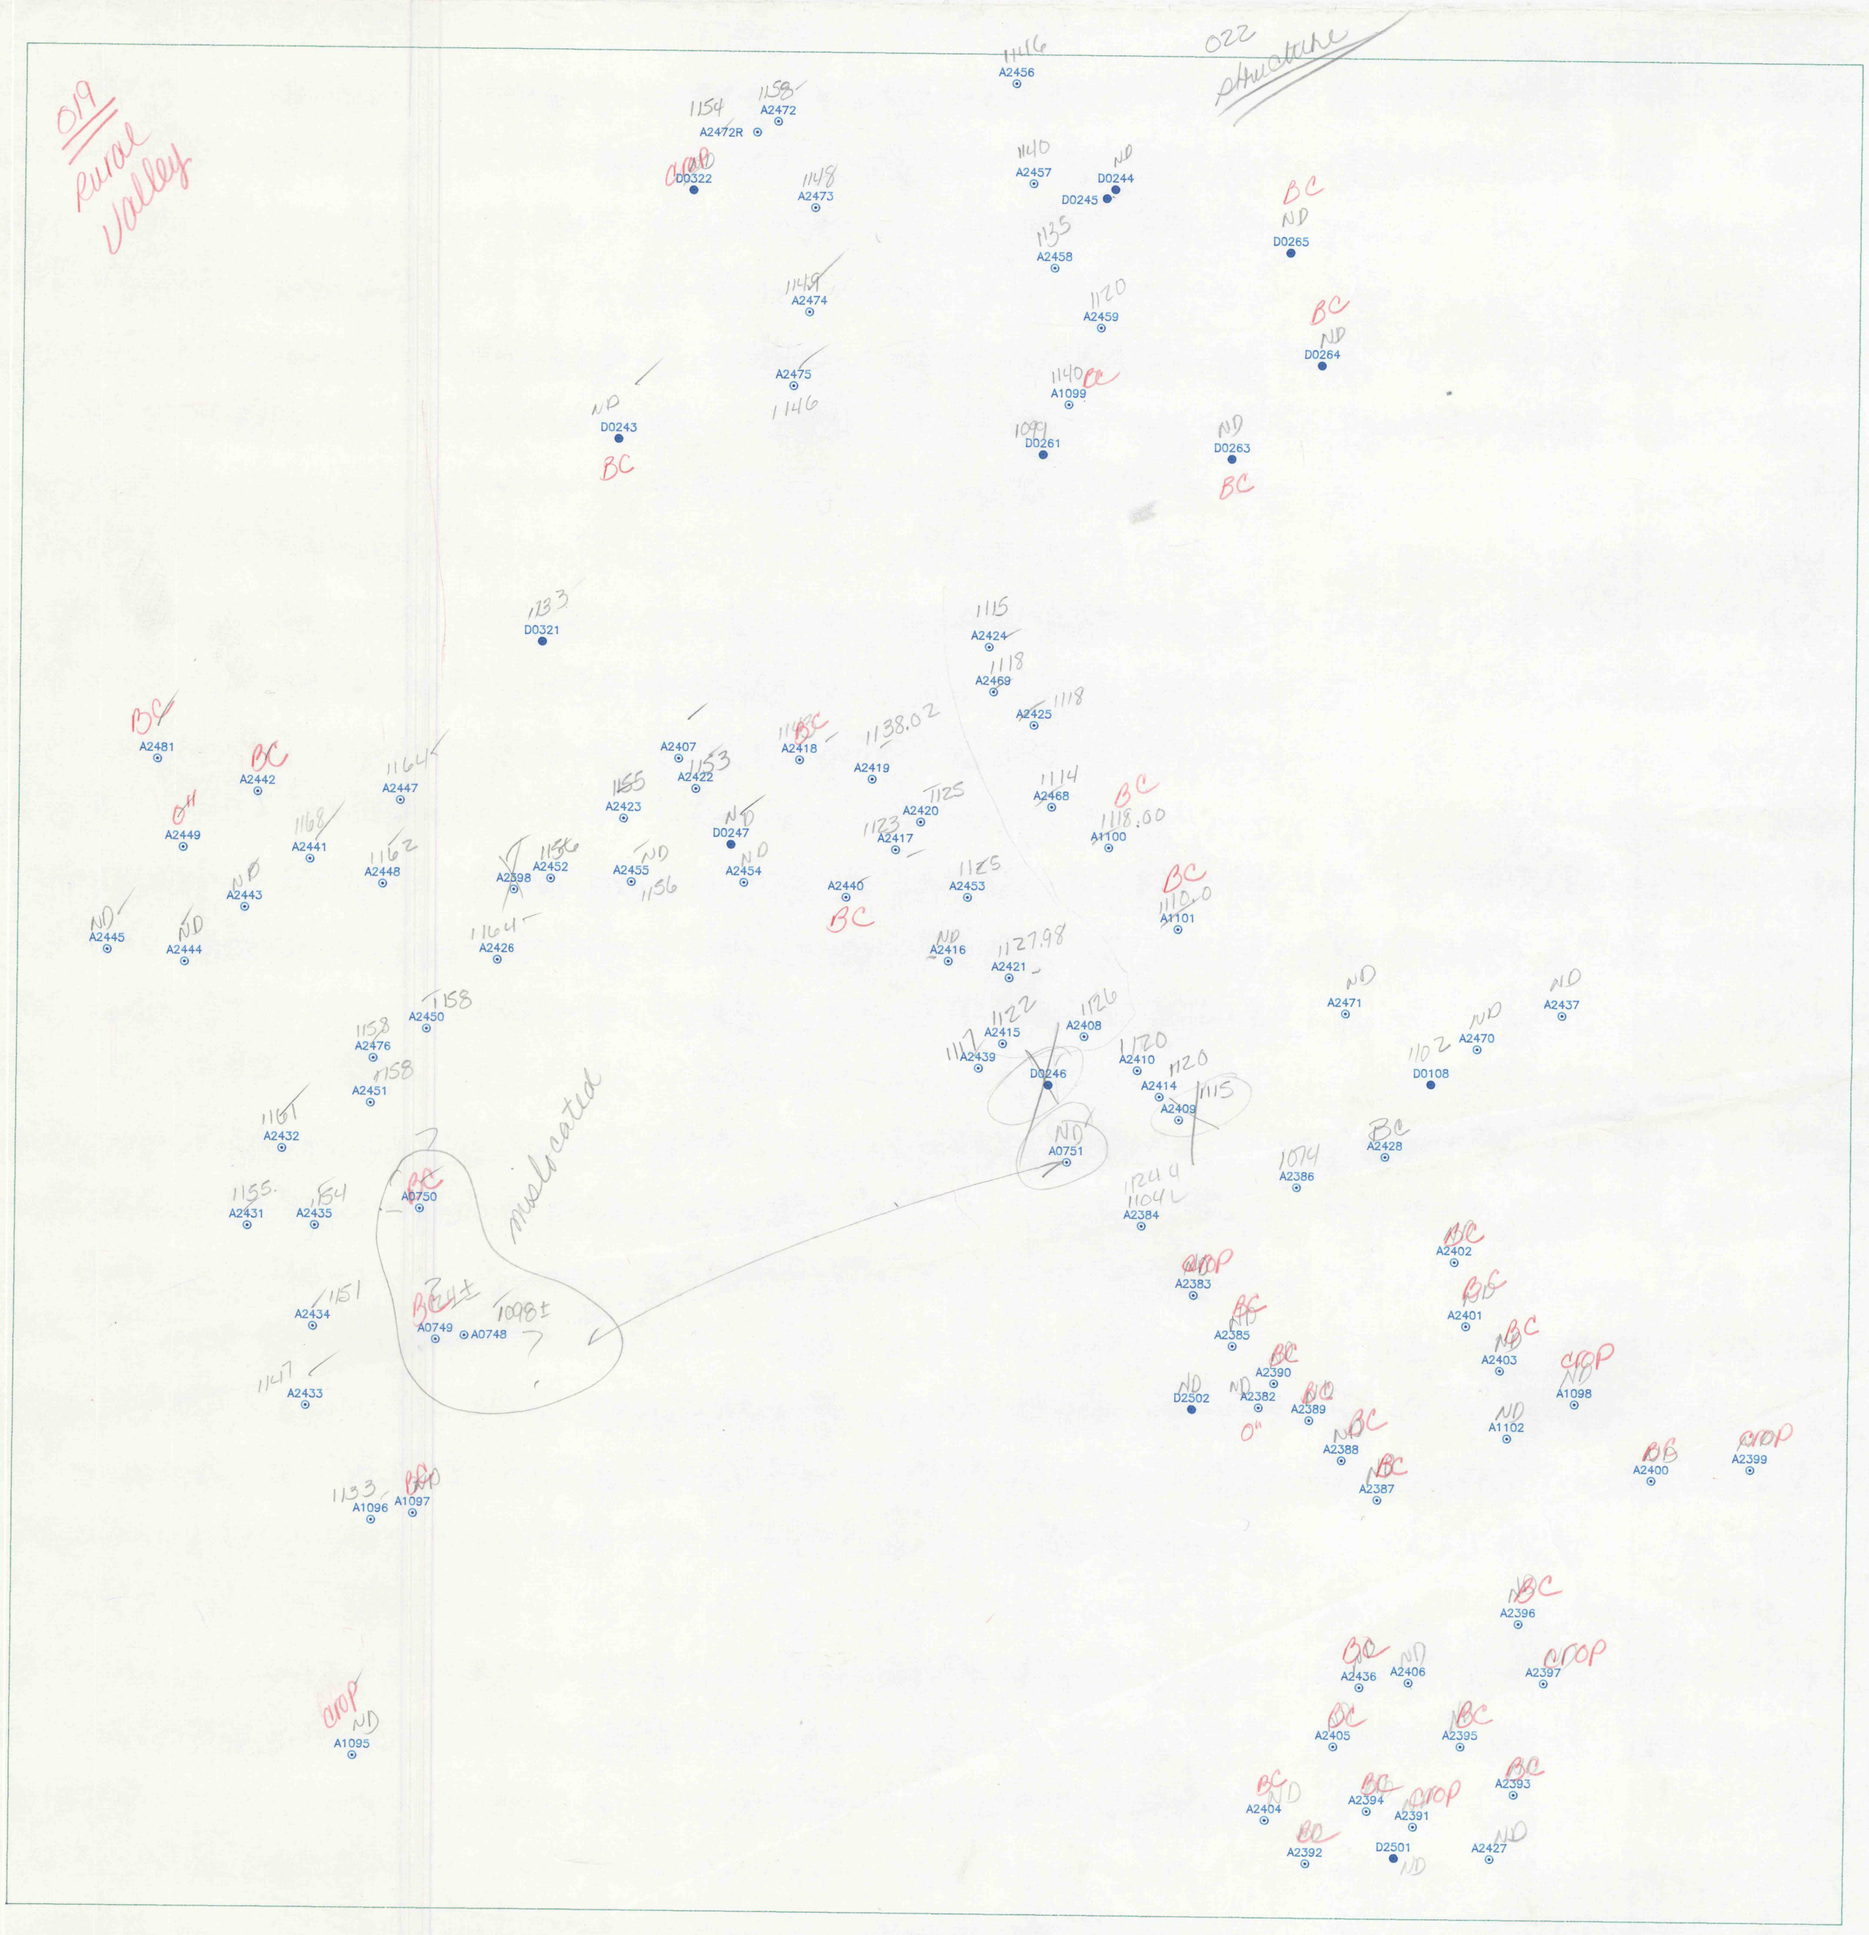
019
Rural Valley
022
structure
A2456
A2472
A2472R
D0322
A2473
A2457
D0244
D0245
D0265
A2458
A2474
A2459
D0264
A2475
A1099
D0243
D0261
D0263
D0321
A2424
A2469
A2425
A2481
A2442
A2407
A2422
A2418
A2419
A2468
A2449
A2441
A2447
A2423
A2420
A2417
A1100
A2448
A2452
A2398
A2455
D0247
A2454
A2440
A2453
A1101
A2443
A2445
A2444
A2426
A2416
A2421
A2471
A2437
A2470
A2450
A2476
A2415
A2408
A2439
D0246
A2410
A2414
A2409
D0108
A2451
A2432
A0751
A2428
A2386
A2431
A2435
A0750
A2384
A2402
A2383
A2434
A0749
A0748
A2401
A2385
A2403
A2390
A2433
D2502
A2382
A2389
A1098
A1102
A2388
A2400
A2399
A2387
A1096
A1097
A2396
A2436
A2406
A2397
A2405
A2395
A2404
A2394
A2391
A2393
A2392
D2501
A2427
A1095
multicated

IMAPS# 19167