




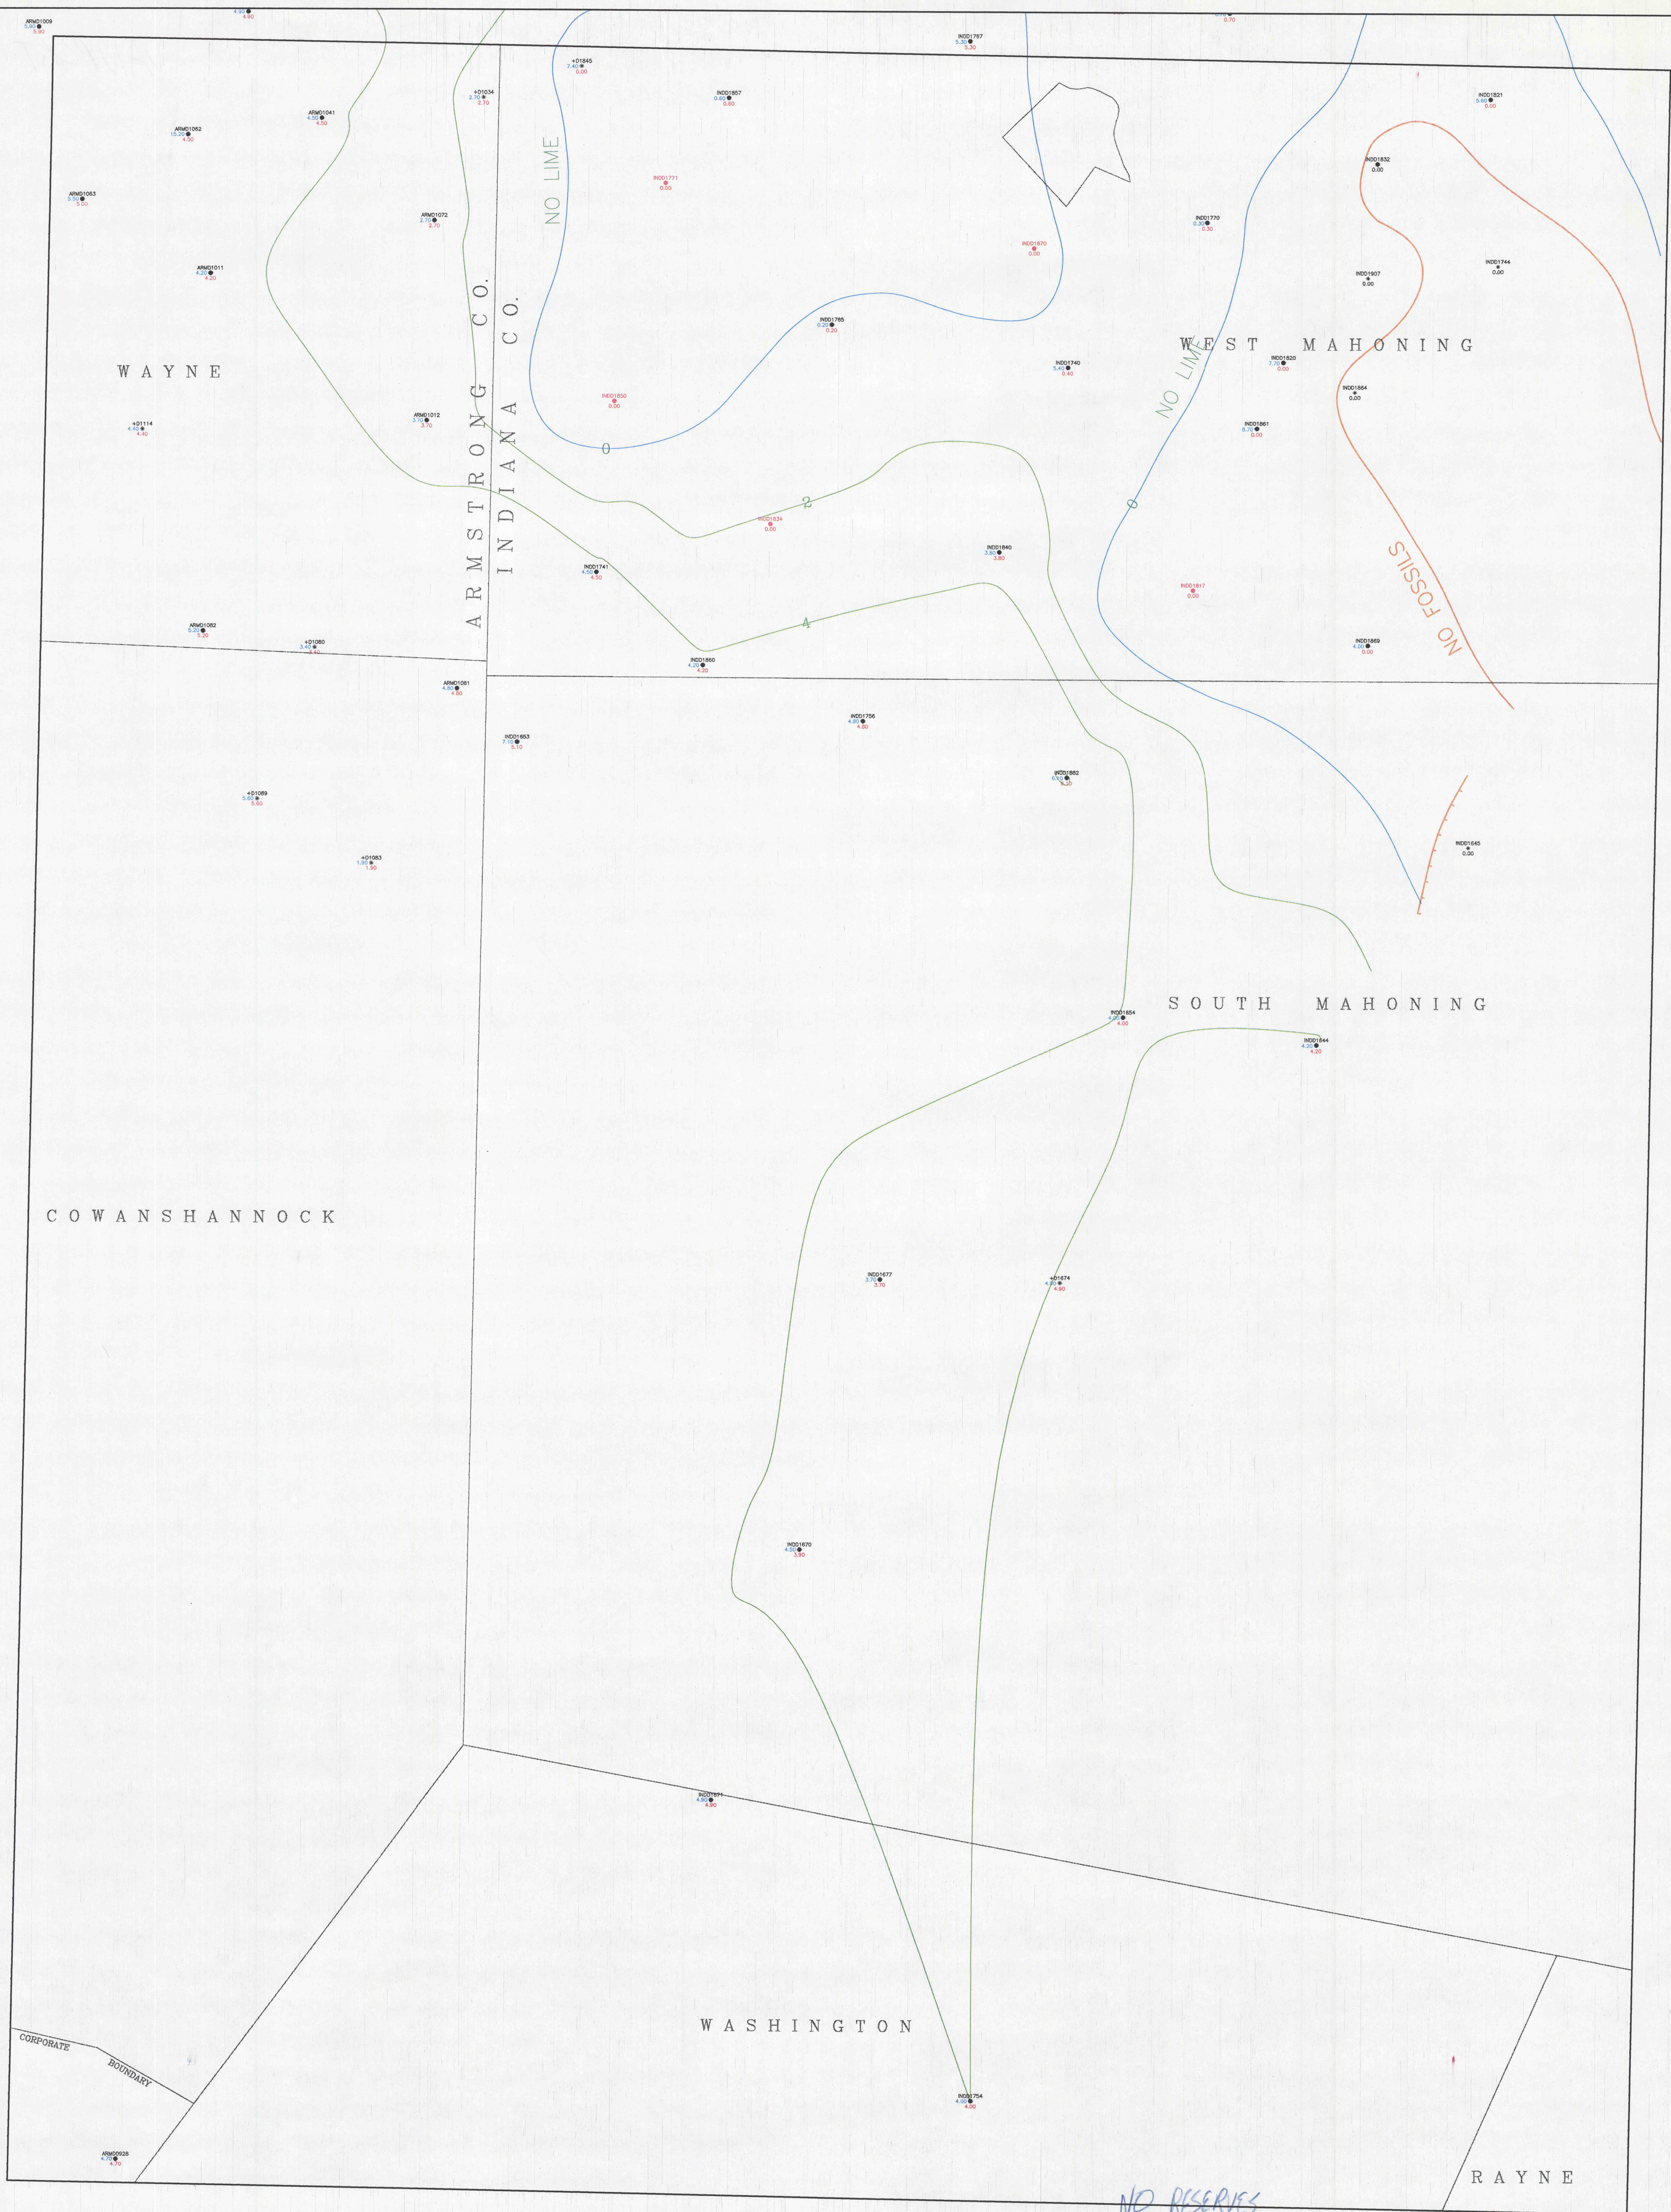

NO RESERVES
JHM
1/29/92

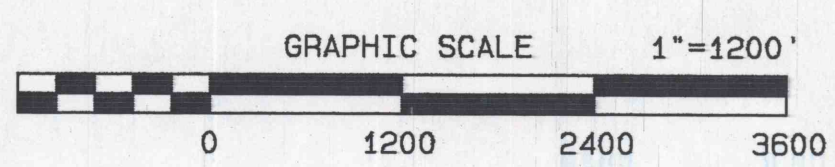

DATE : MON JAN 20 16:26:25 1992
PROJECT : K:\ARM\BIGMAP.

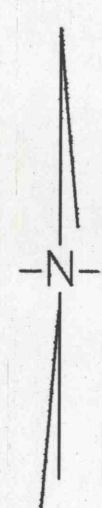

Rochester & Pittsburgh Coal Co.
Armstrong County Reserve Evaluation Project

VANPORT LIMESTONE RESERVE MAP
for the
PLUMVILLE QUADRANGLE

1MAPS19170