


Copy of E. Central Portion
of Dayton 7½' quad.

Ported Location
Fairview #5

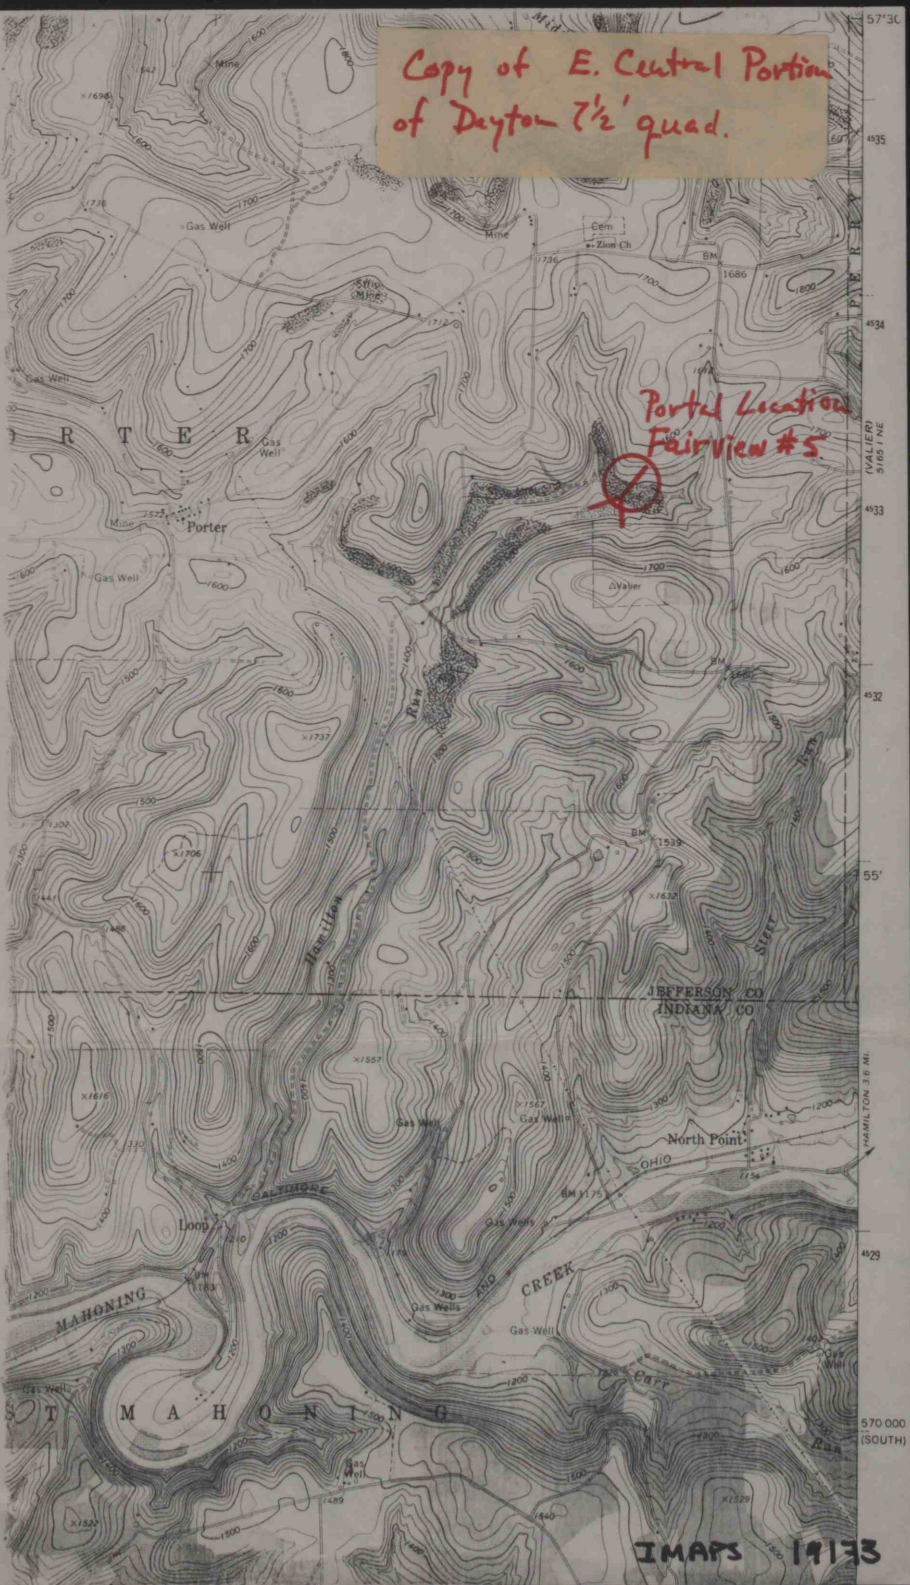

