


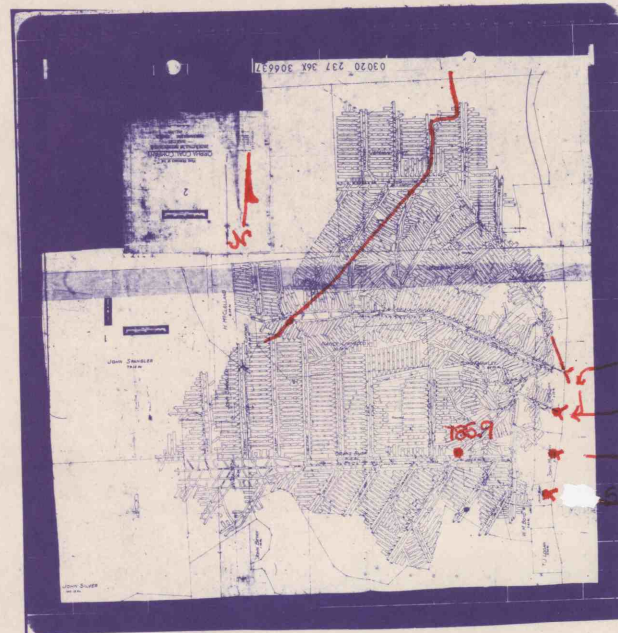

LEECHBURG QUAD

1 MAPS 19174