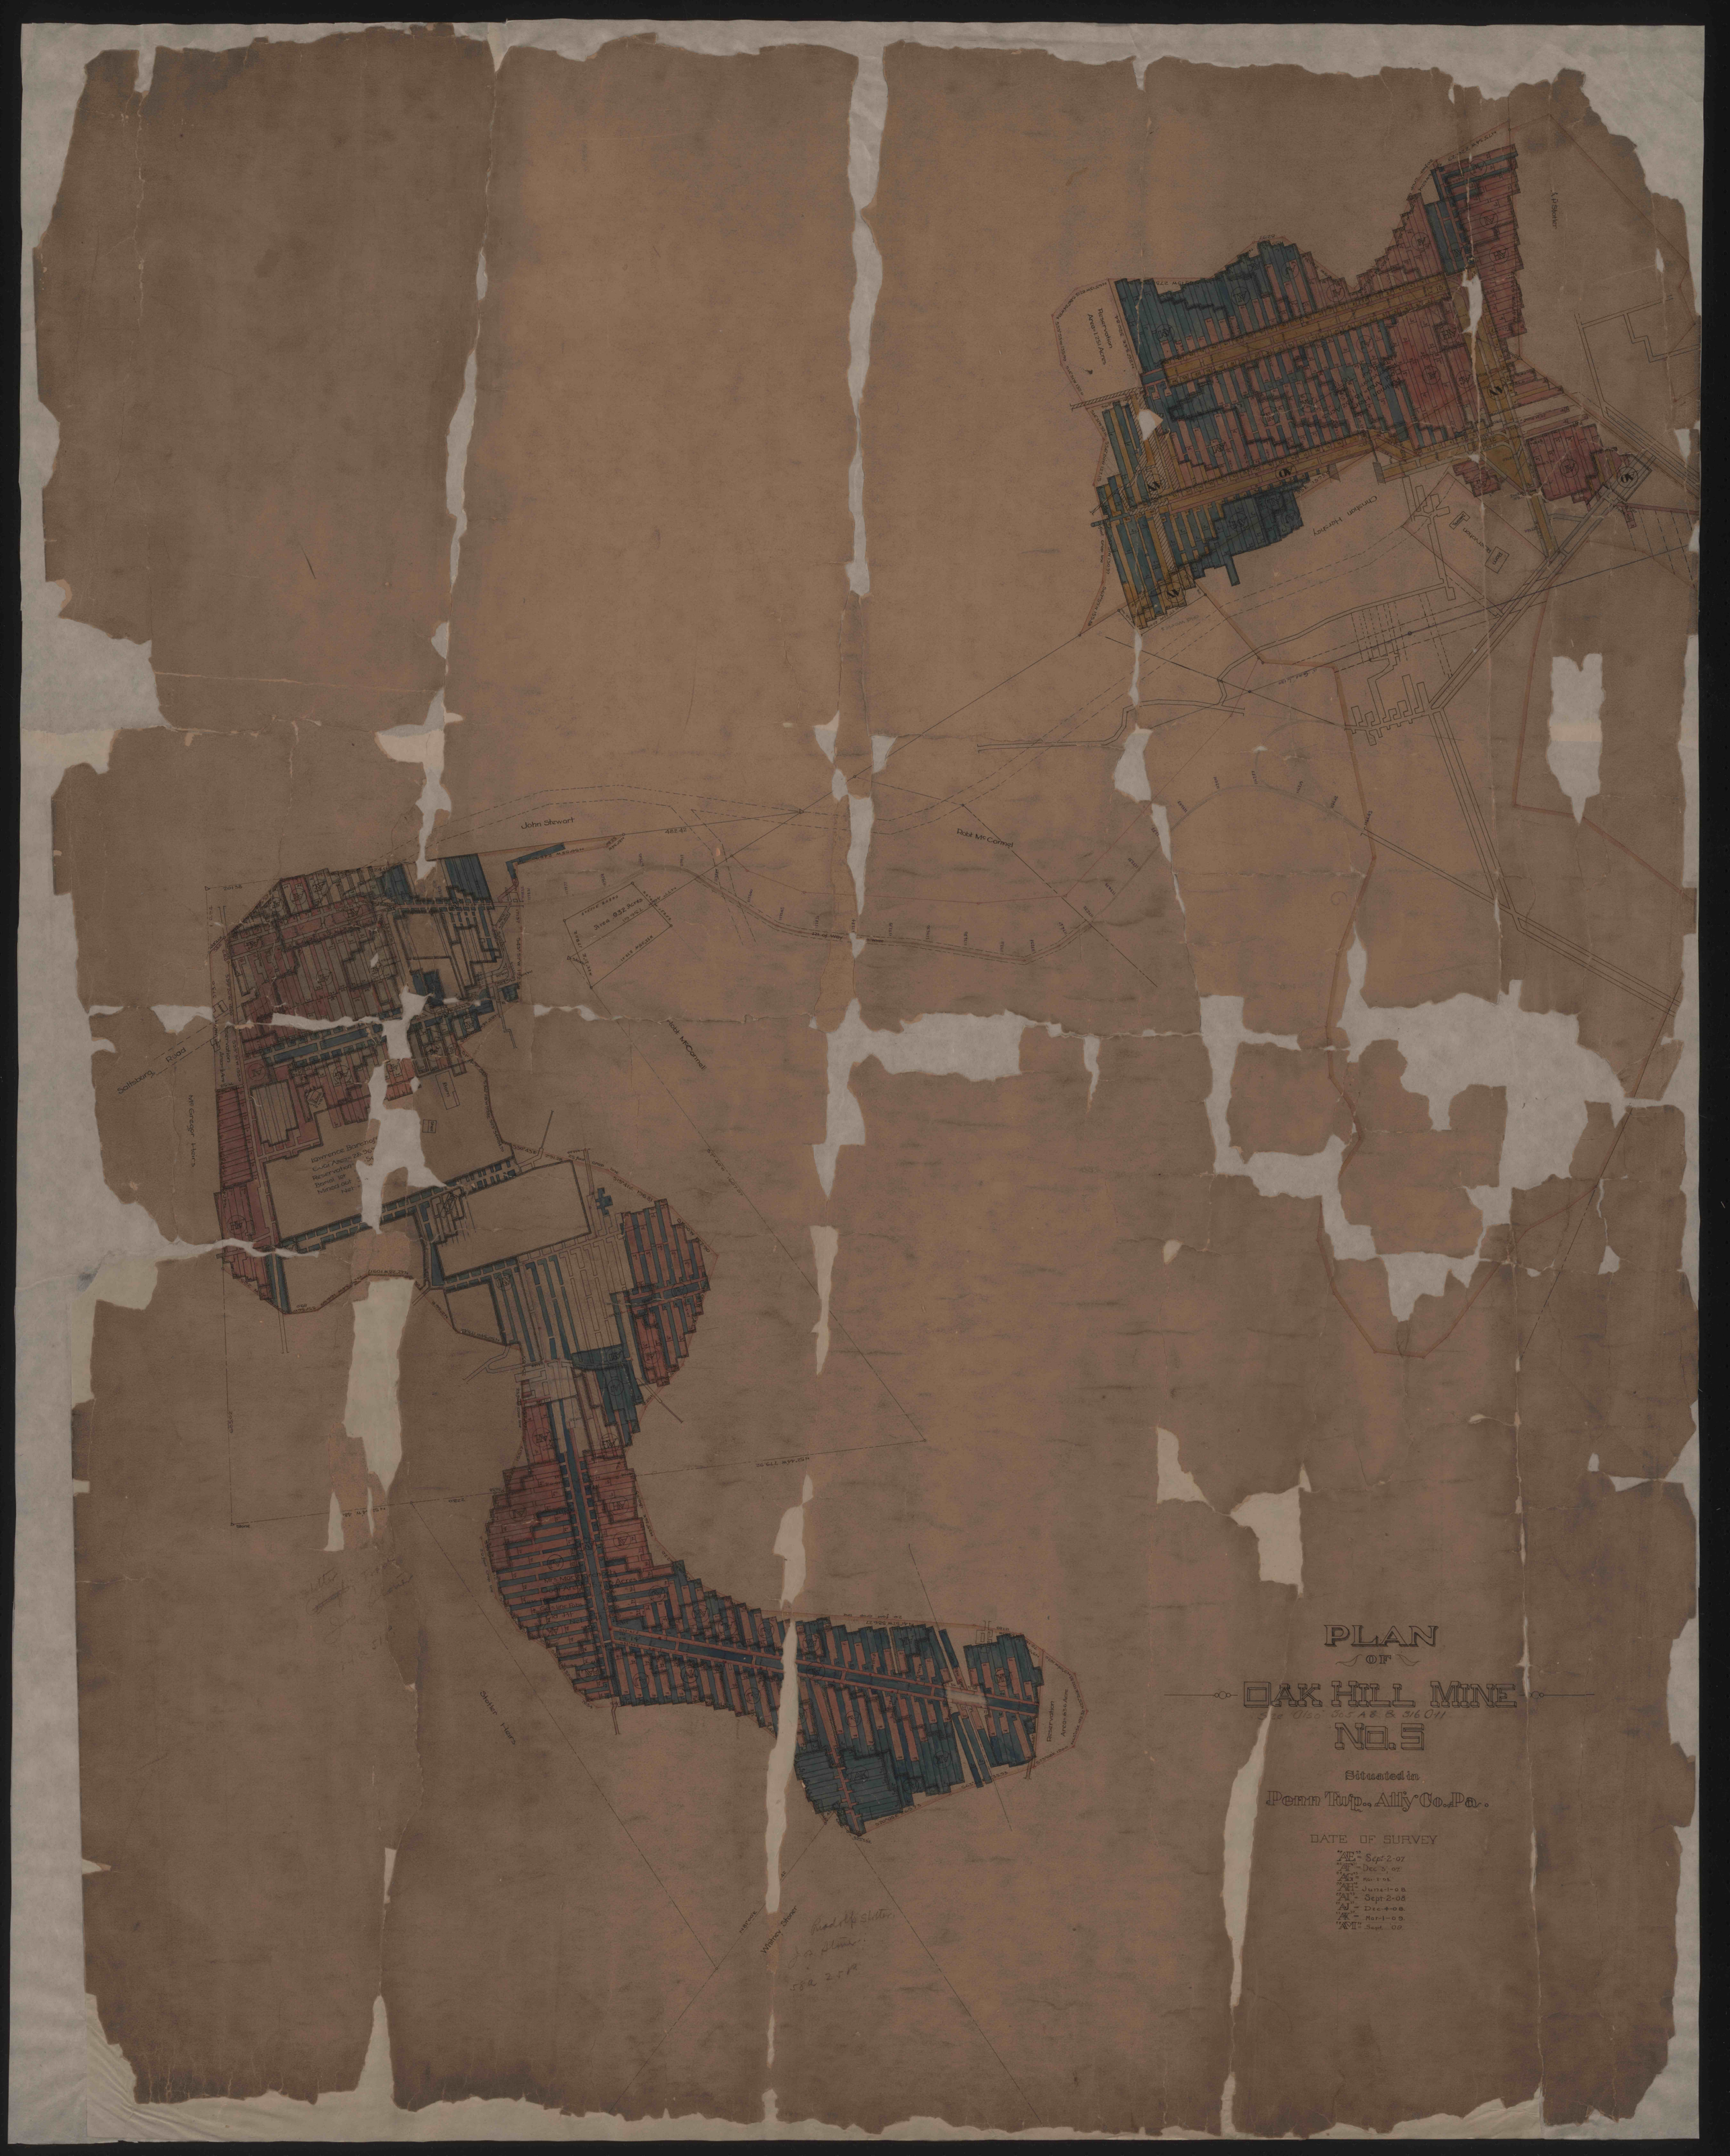
PLAN
OF
OAK HILL MINE
No. 5
Situated in
Penn Twp., Ally Co., Pa.
DATE OF SURVEY
"AE" - Sept-2-07
"AF" - Dec 3, 07
"AG" - Mar-1-08
"AH" - June-1-08
"AI" - Sept-2-08
"AJ" - Dec-4-08
"AK" - Mar-1-09
"AM" - Sept 09
John Stewart
Robt McCormel
Saltsburg Road
McGregor Heirs
Shelter Heirs
Whitney Stover
Reservation
Area 6.5 Acre
Stover Cemetery
Barn
Chrisman Heirs
Lot of Way