


L-28-A


FIT TO L-29-A

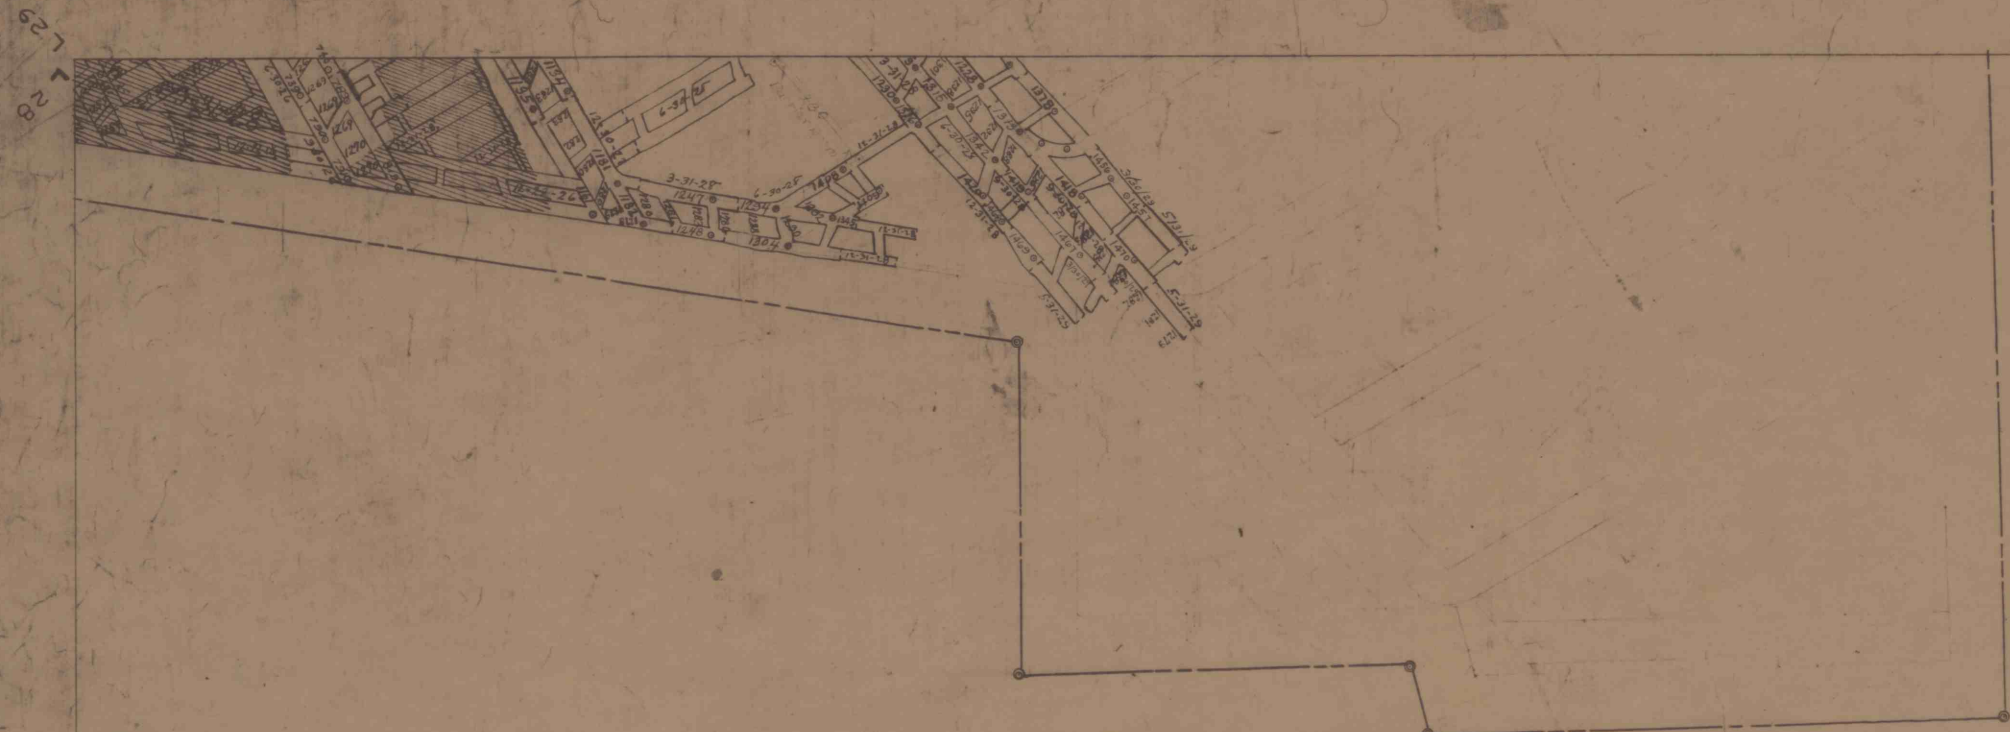

Magnetic North

MAP
OF THE
No 78 and 79 Mine Workings
BETHLEHEM CUBA IRON MINES Co.
OPERATED BY
BETHLEHEM MINES CORPORATION
Wehrum, Indiana County, Pa.

Scale 1" = 200ft

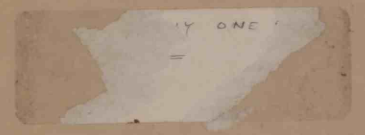

BARNES & TUCKER COMPANY
An Also Standard Company
The Corporate Partnership
BARNES & TUCKER COMPANY
R. & P. Coal Company
335 Church Street
Indiana, PA 15701
Attn: Bill Young

HOLDERS OF THE
ORIGINALS OF THESE
PRINTS

0	L-33	L-30	
L-36	L-32	L-29	L-29A
0	L-31	L-28	L-28A

IMAPS 19199

L-28-A