


62-7

62-7

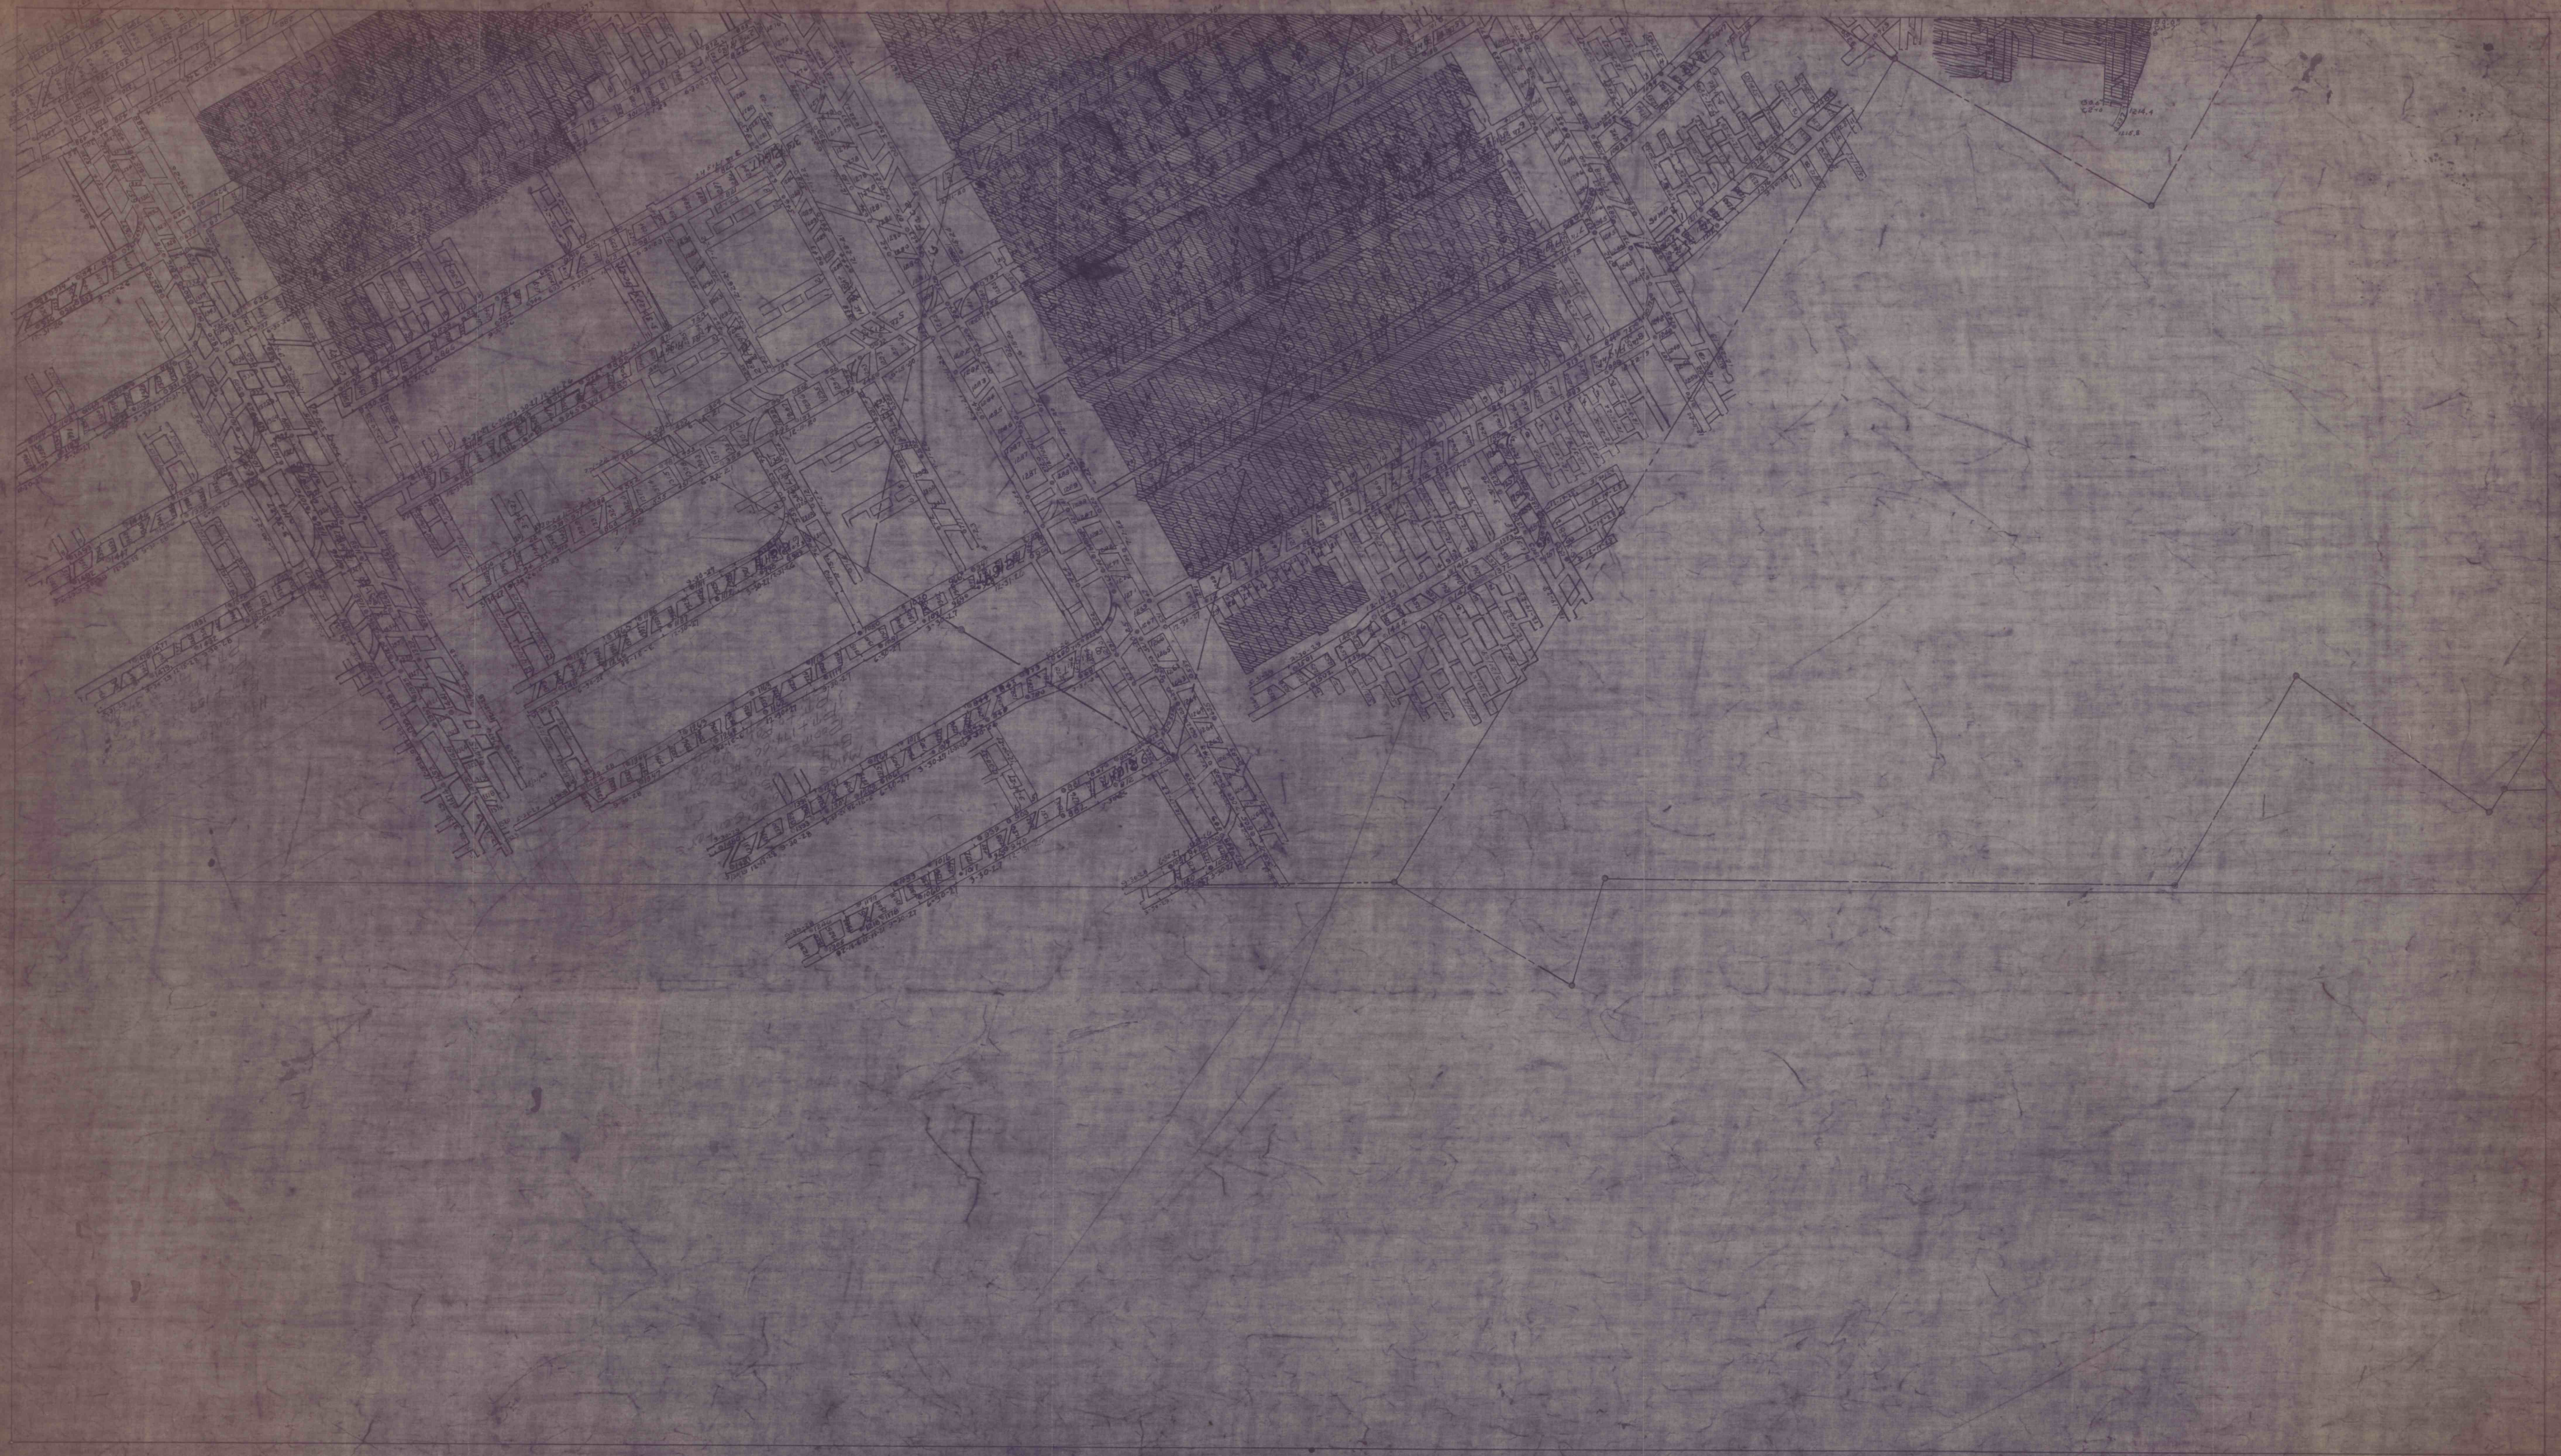

L 33