


L-30-A

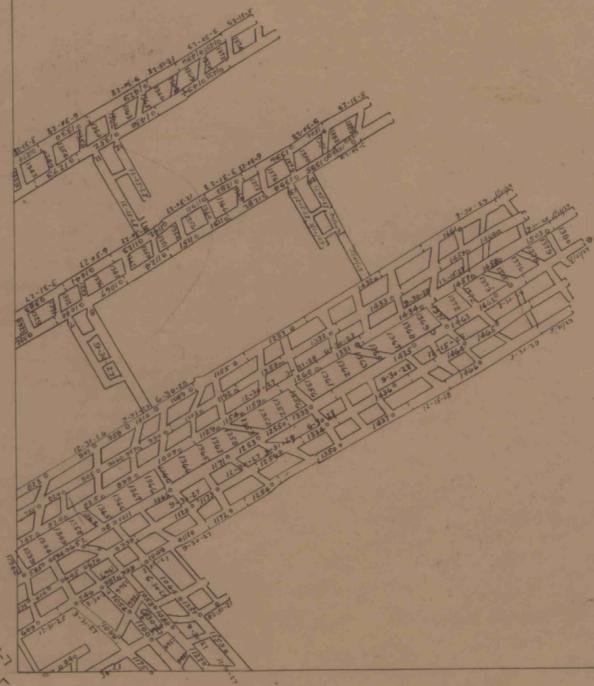

L-30  
L-29

IMAPS 19204

L-30-A