


L-29-A

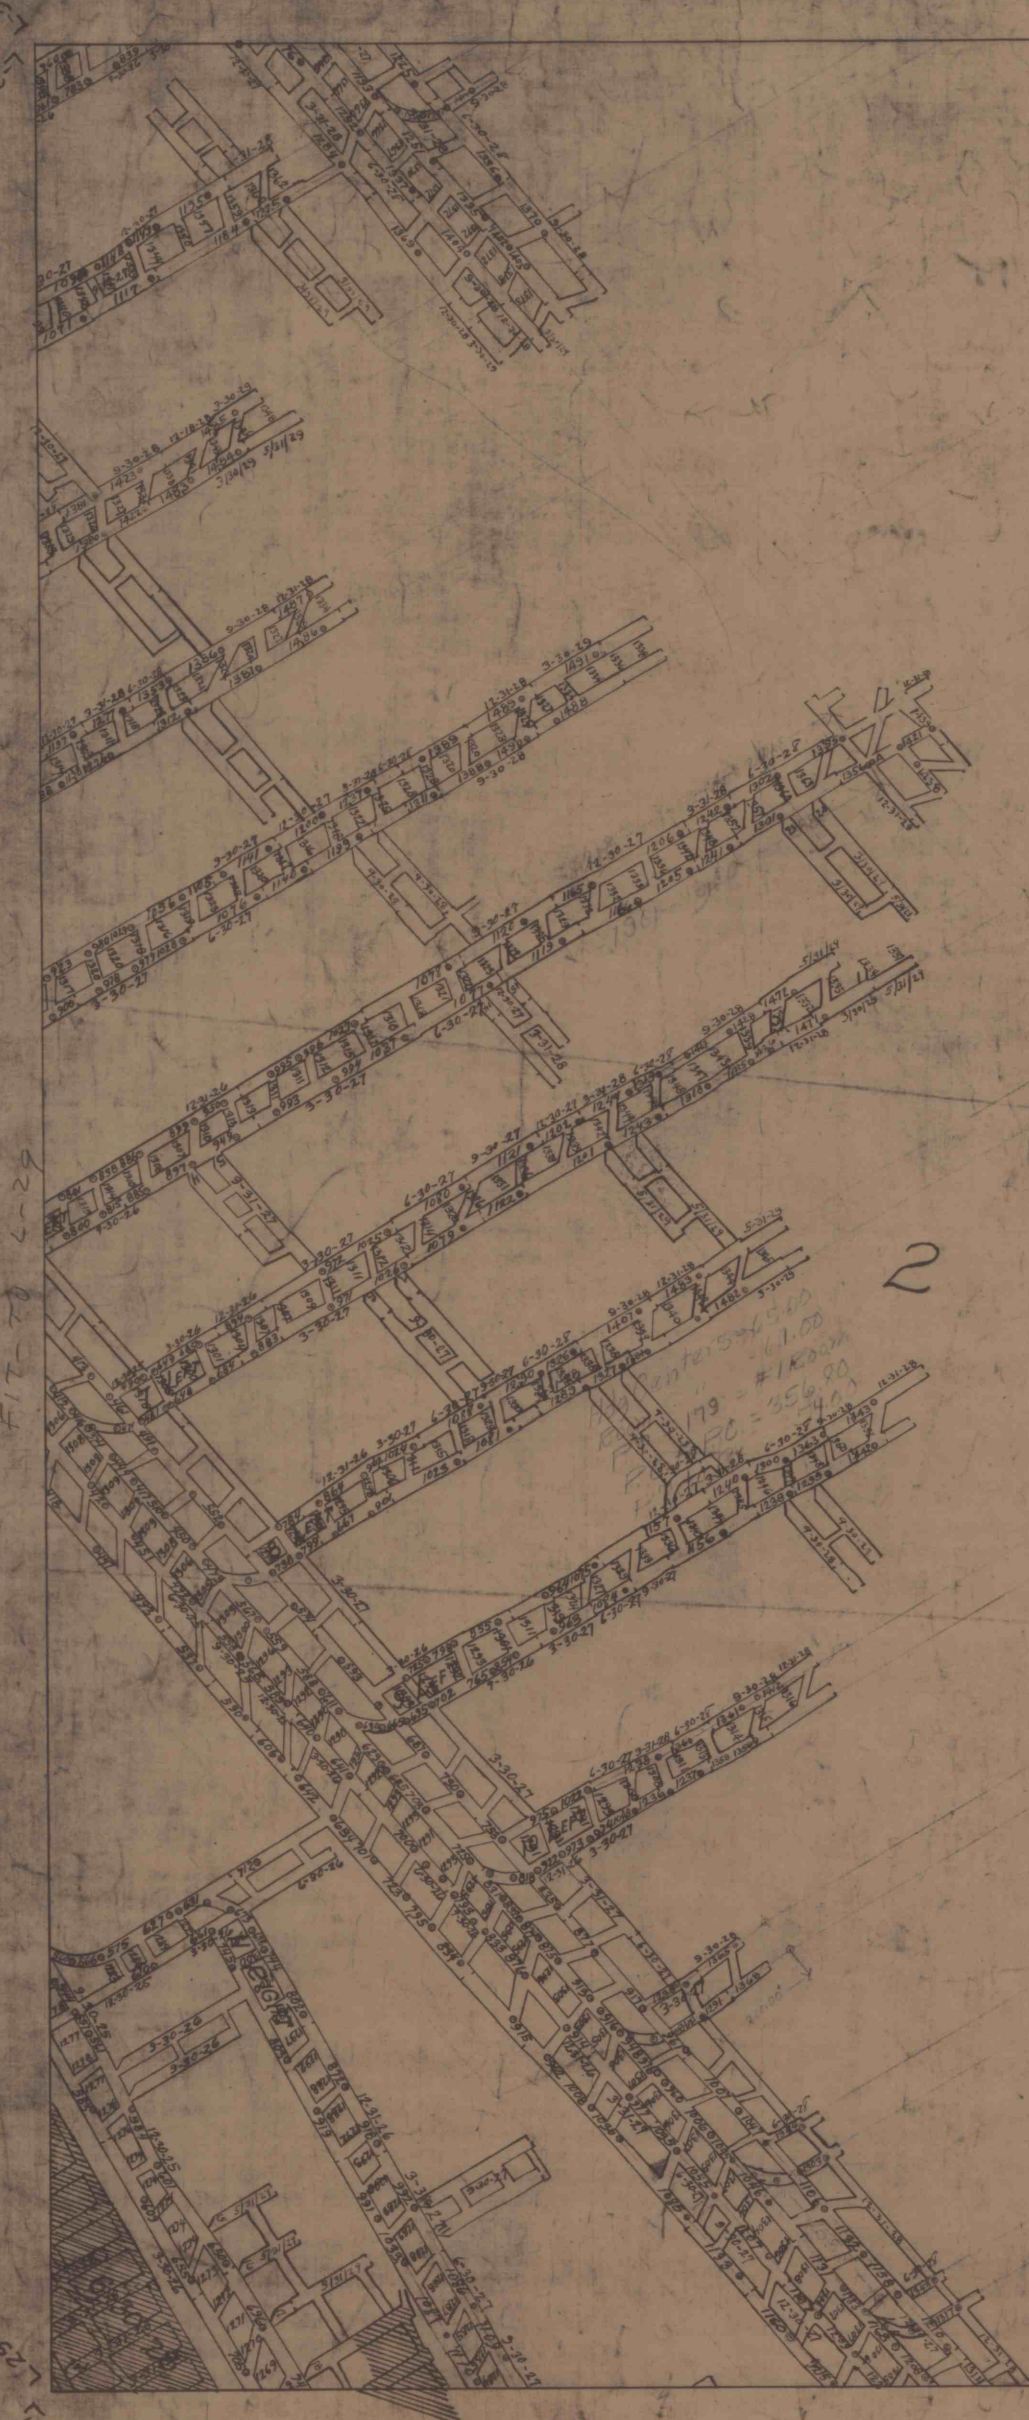

2

FIT TO L-28-A

L-29-A