


DEED	GRANTOR	GRANTEE	ACRES	REMARKS
14	LACK. I. & S. CO.	LACK. C. & C. CO.	168.71	
40	" " "	" " "	130.33	
49	" " "	" " "	25.11	
51	" " "	" " "	110.67	
8	A. V. BARKER	" " "	74.12	
18	" " "	" " "	60.15	
19	" " "	" " "	100.15	
23	" " "	" " "	35.11	
129	" " "	" " "	61.15	

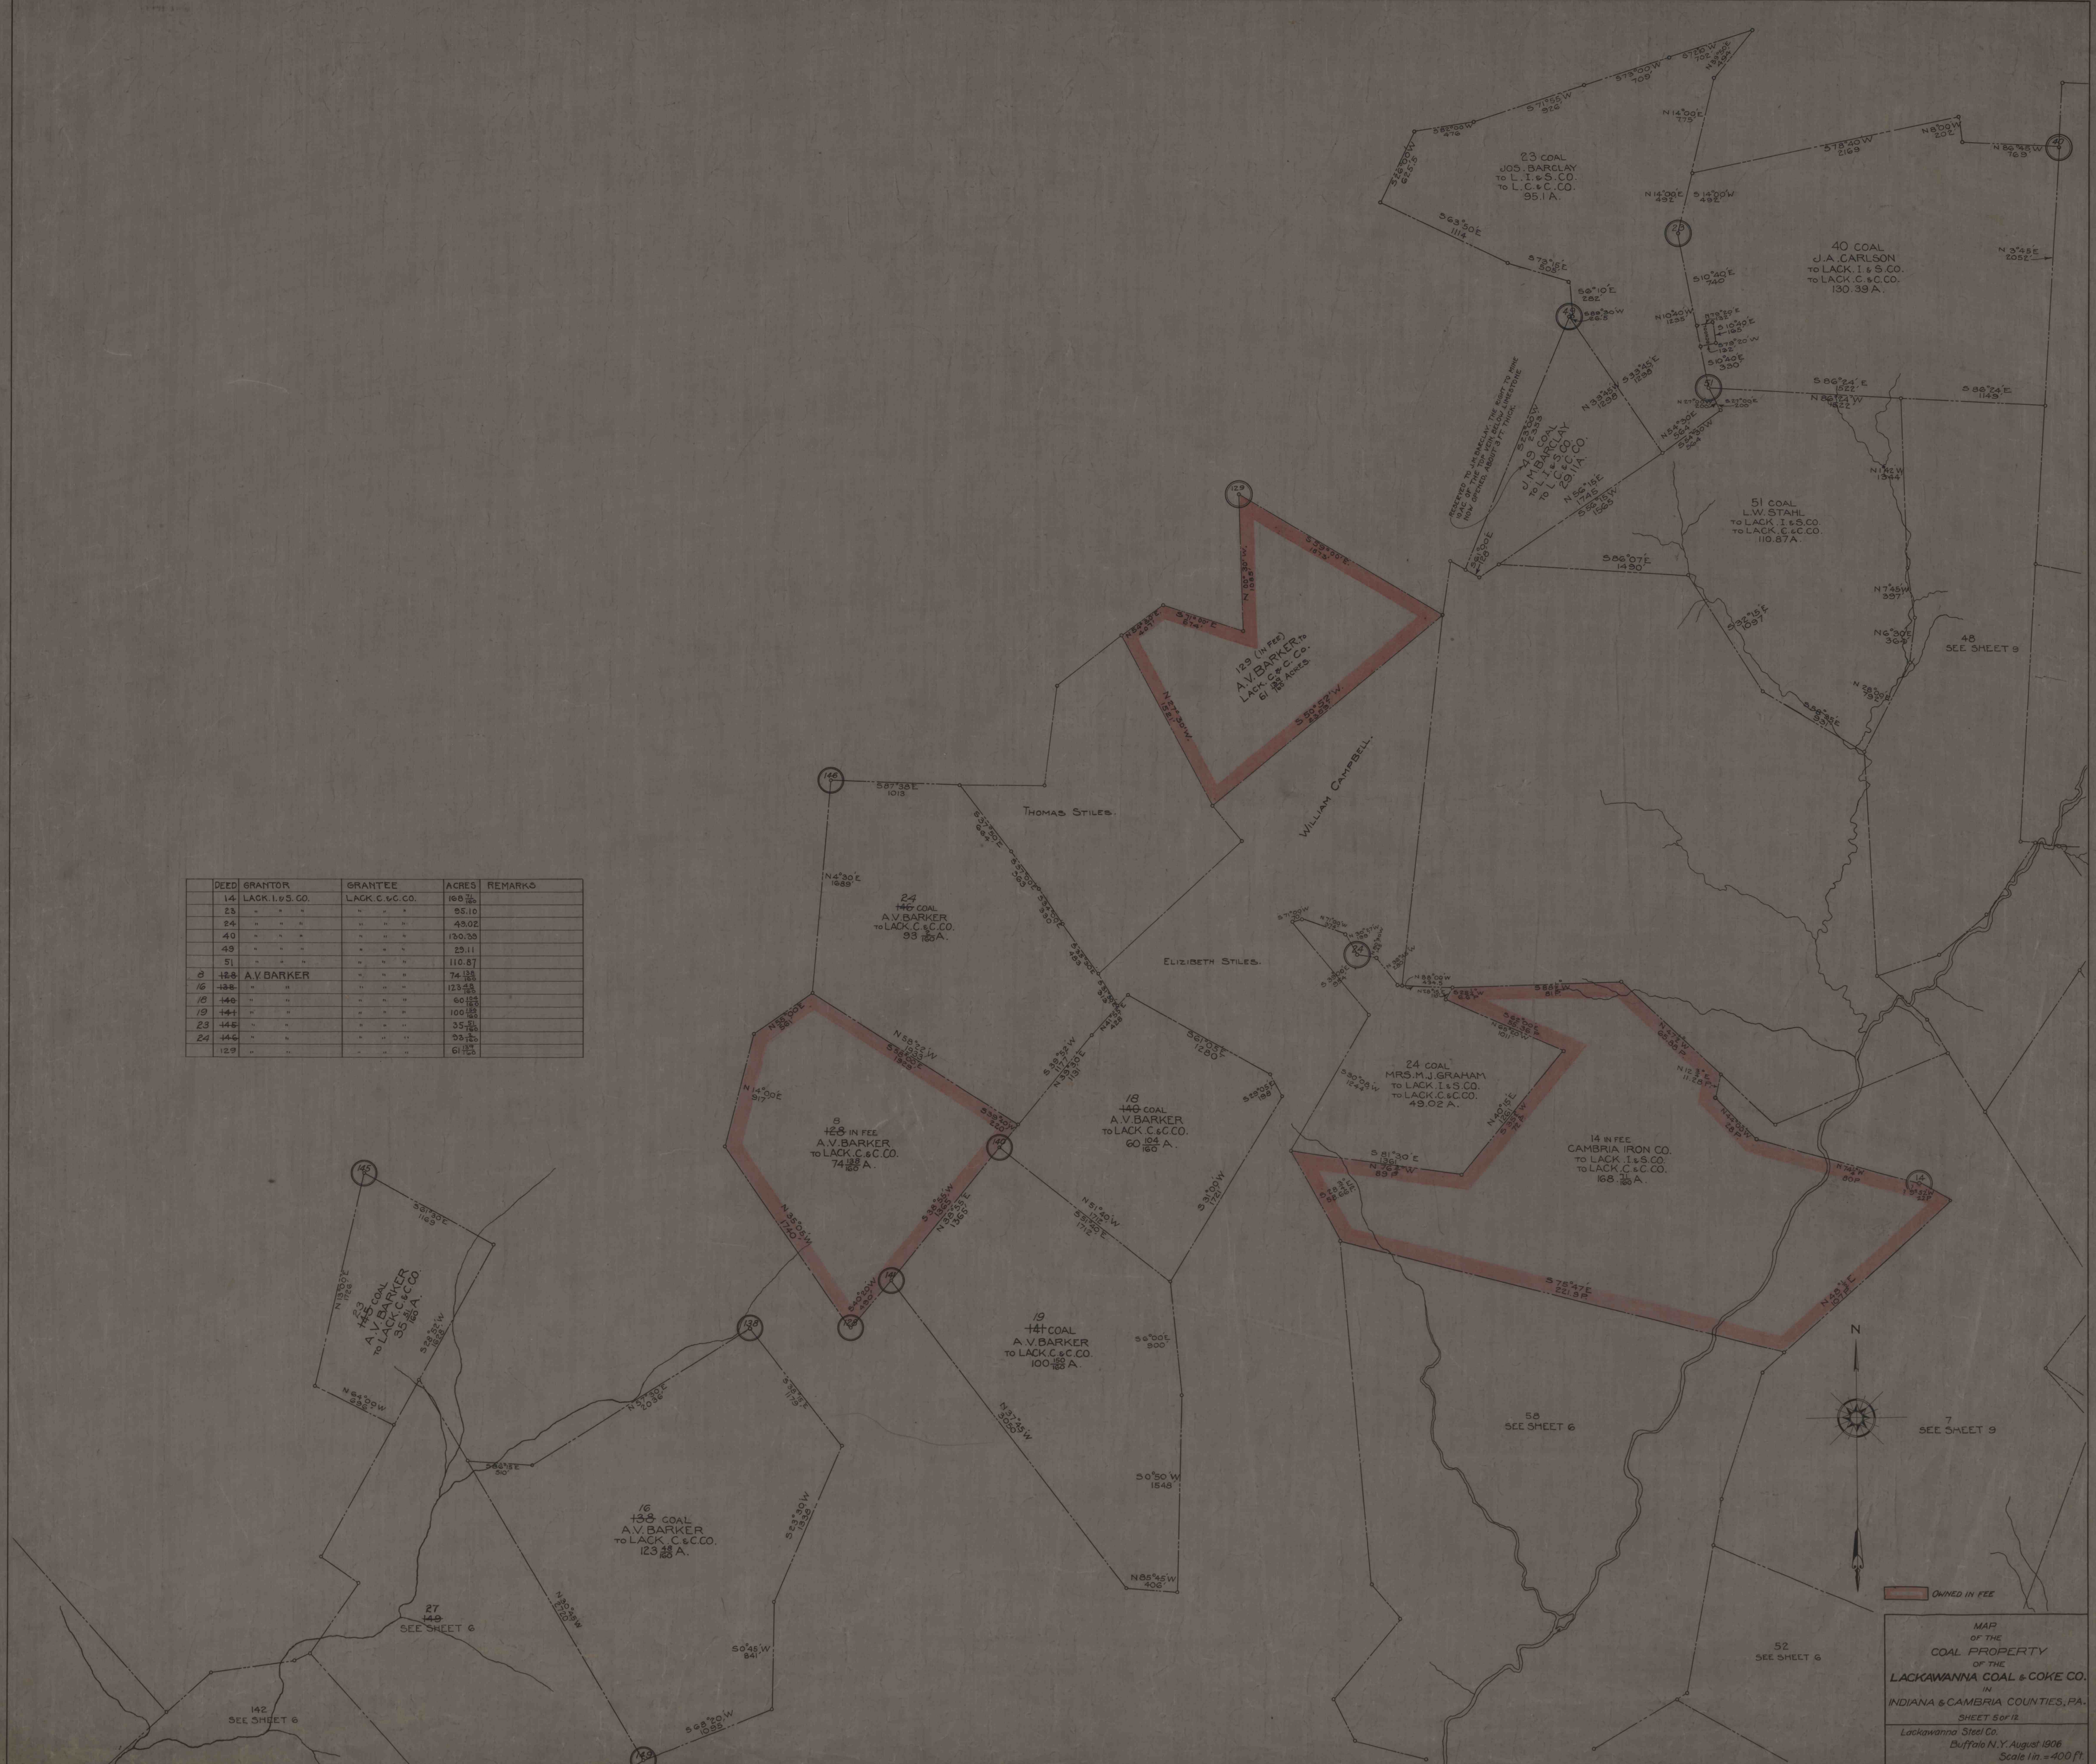

OWNED IN FEE

MAP OF THE
COAL PROPERTY
OF THE
LACKAWANNA COAL & COKE CO.
IN
INDIANA & CAMBRIA COUNTIES, PA.
SHEET 5 OF 12
Lackawanna Steel Co.
Buffalo, N.Y. August 1906
Scale 1 in. = 400 ft.