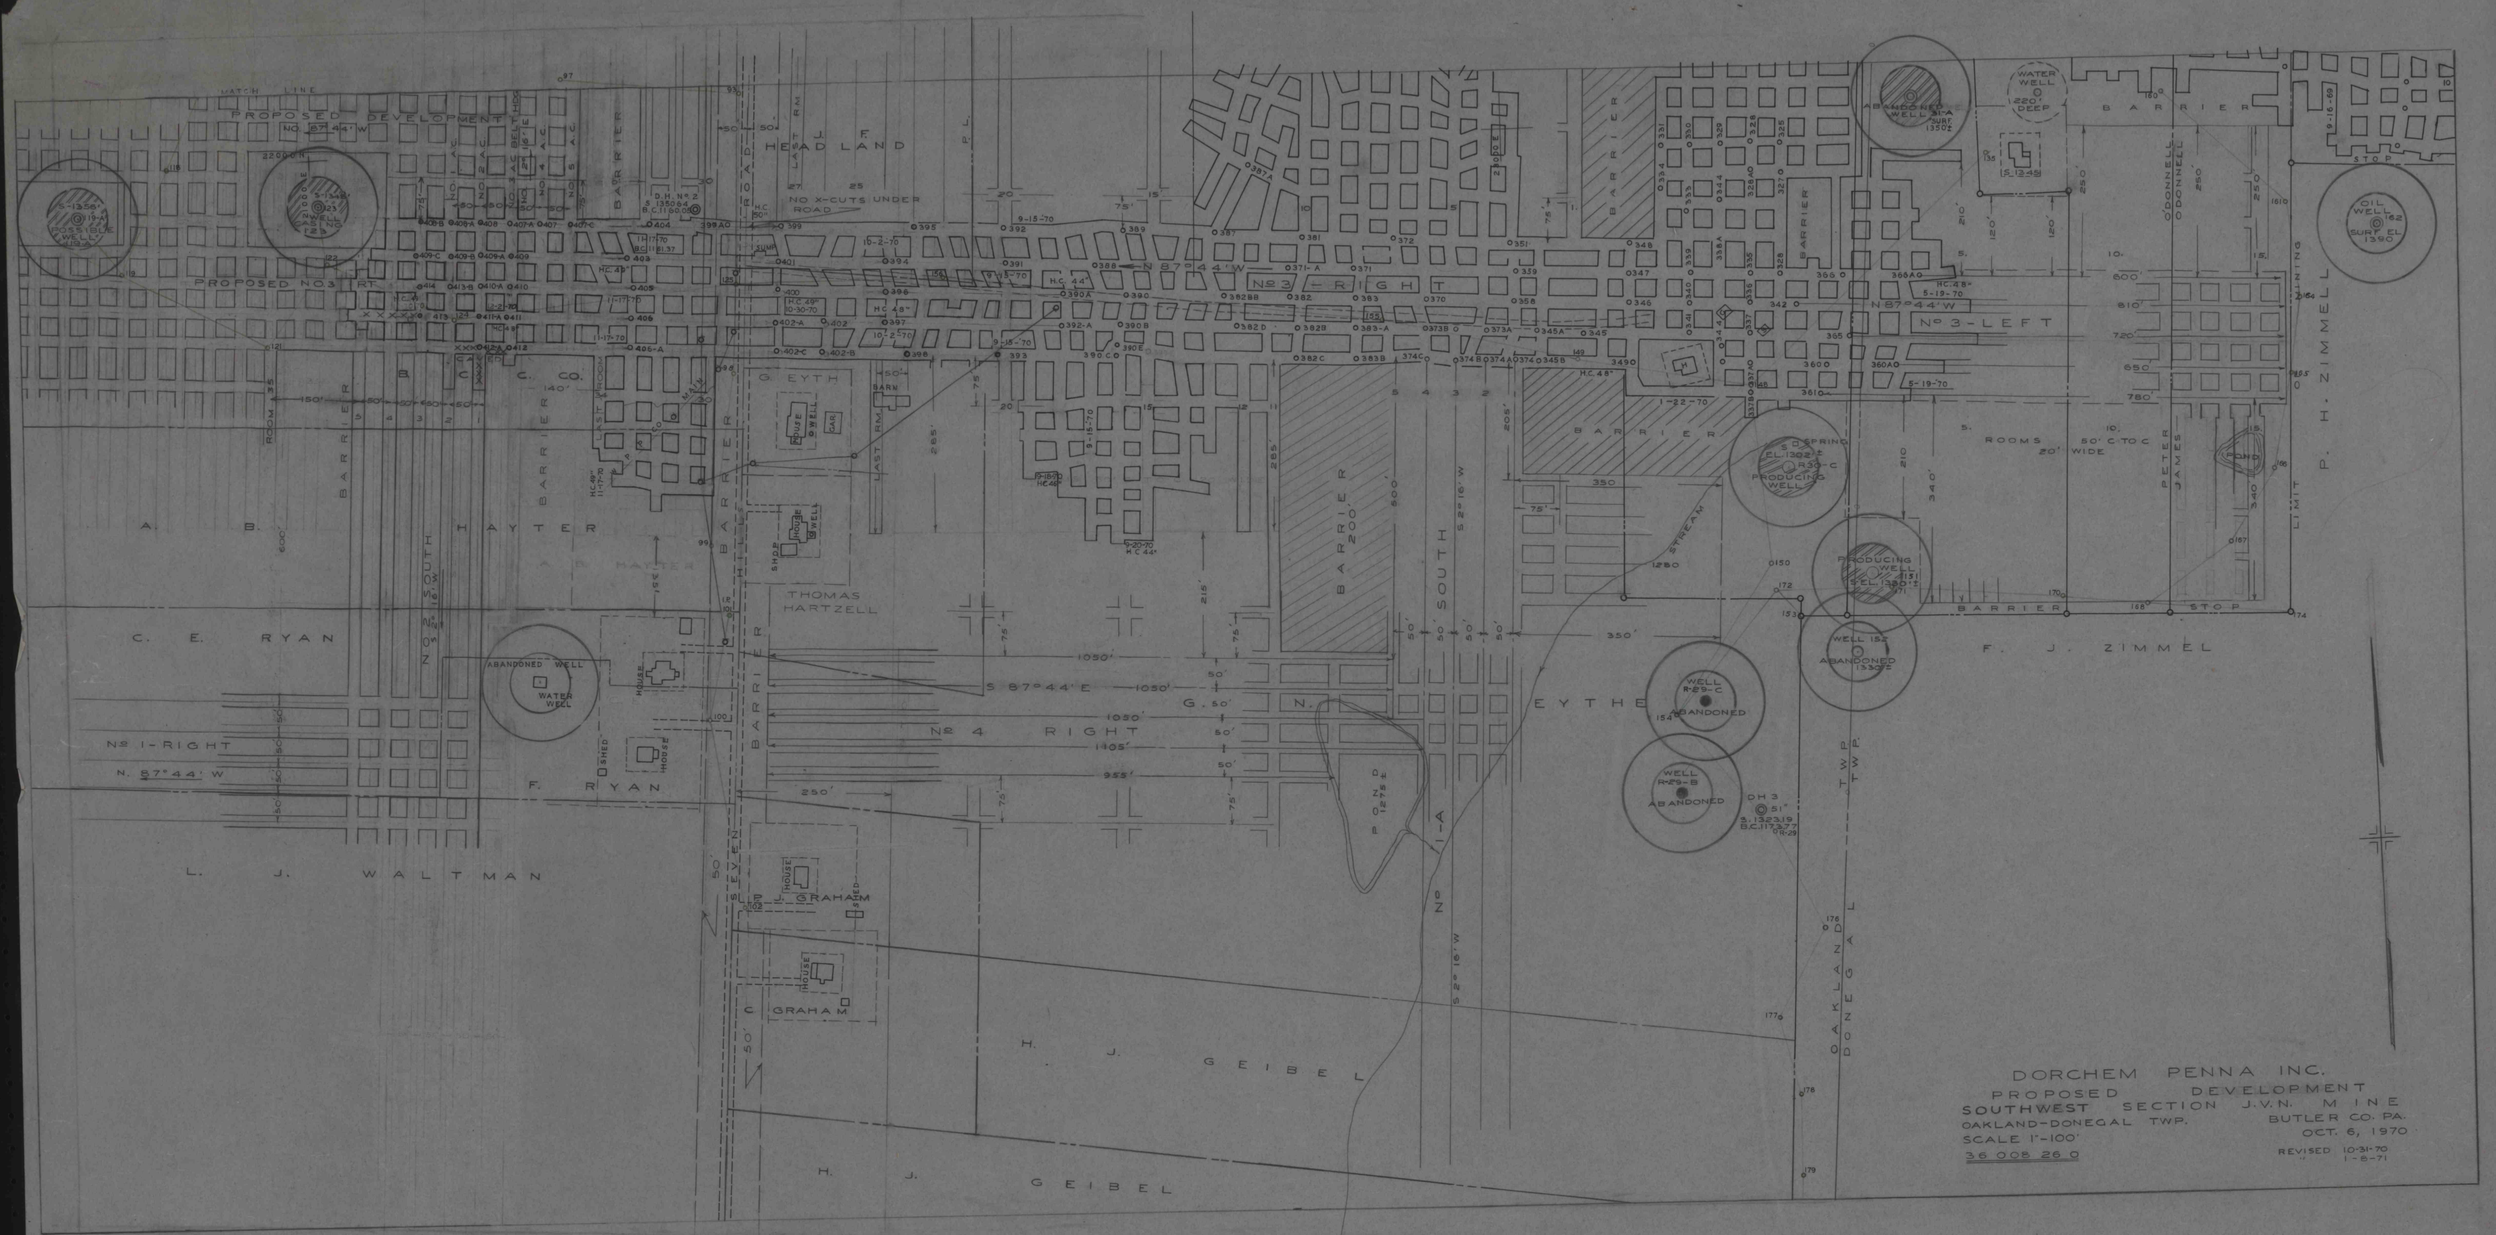
DORCHEM PENNA INC.
PROPOSED DEVELOPMENT
SOUTHWEST SECTION J.V.N. MINE
OAKLAND-DONEGAL TWP. BUTLER CO. PA.
SCALE 1"-100'
OCT. 6, 1970
REVISED 10-31-70
1-8-71
36 005 26 0
PROPOSED DEVELOPMENT
HEAD LAND
NO X-CUTS UNDER ROAD
PROPOSED No 3 RT.
No 3 - RIGHT
No 3 - LEFT
No 4 RIGHT
No 1 - RIGHT
N. 87° 44' W
S 87° 44' E
A. B. HAYTER
C. E. RYAN
F. RYAN
L. J. WALTMAN
THOMAS HARTZELL
G. EYTH
C. GRAHAM
H. J. GEIBEL
F. J. ZIMMEL
P. H. ZIMMELL
O'DONNELL
BARRIER
ROOMS 20' WIDE 50' C TO C
POND
STREAM
SOUTH
OAKLAND-DONEGAL
LIMIT
ABANDONED WELL
WATER WELL
OIL WELL
PRODUCING WELL
WELL R-89-C ABANDONED
WELL R-89-B ABANDONED
DH 3
STOP