

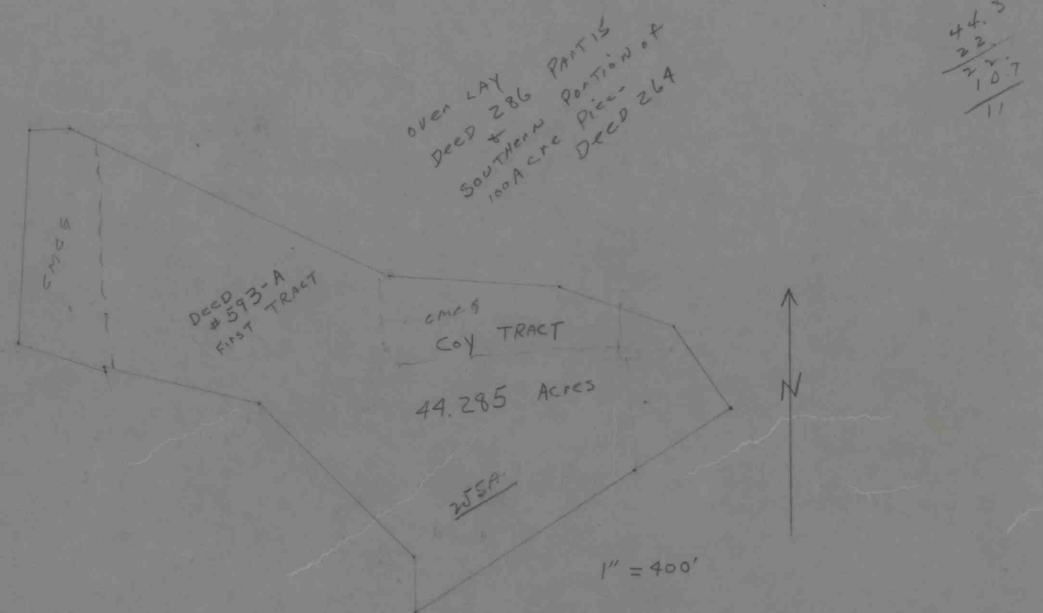
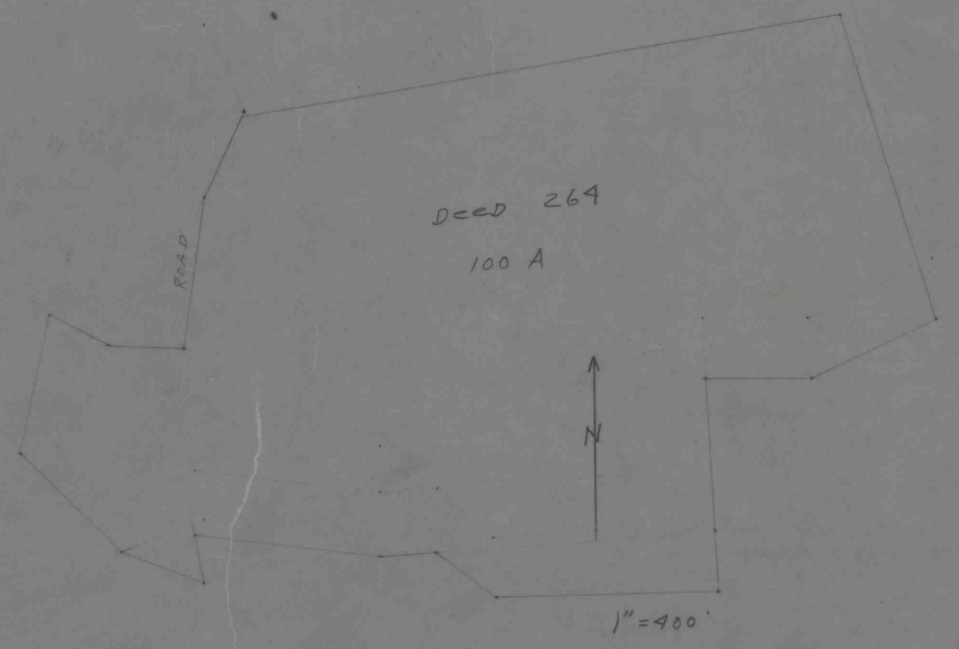


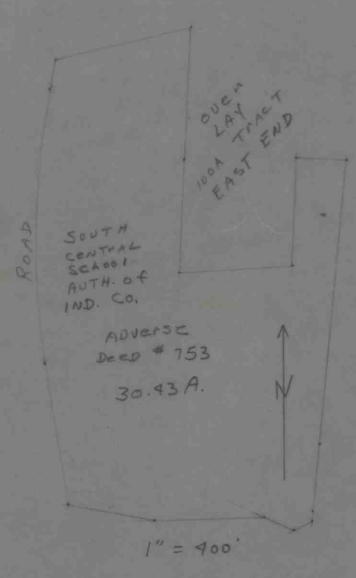

44.3
22
10.7
11

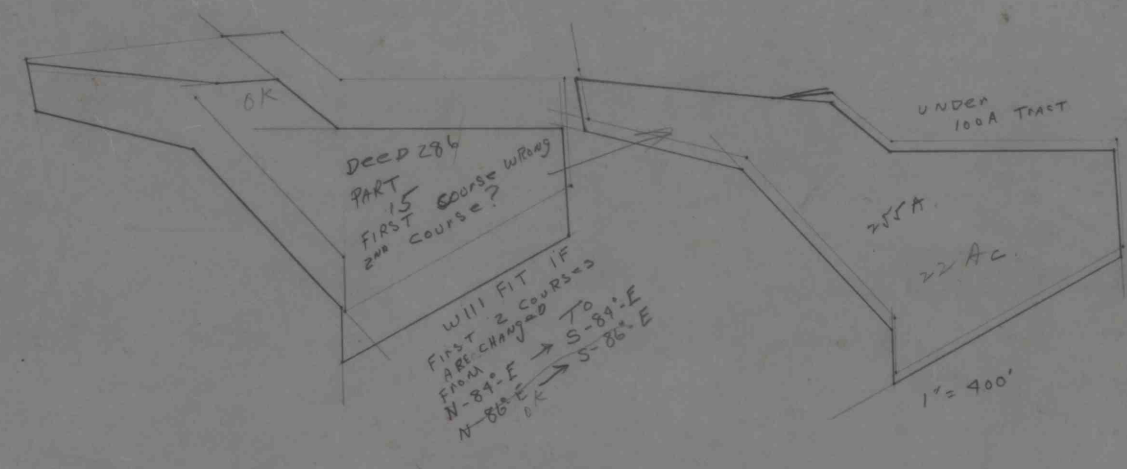

44.3
18.7
25.6
1.0
23.6

25.5
18.8
44.3