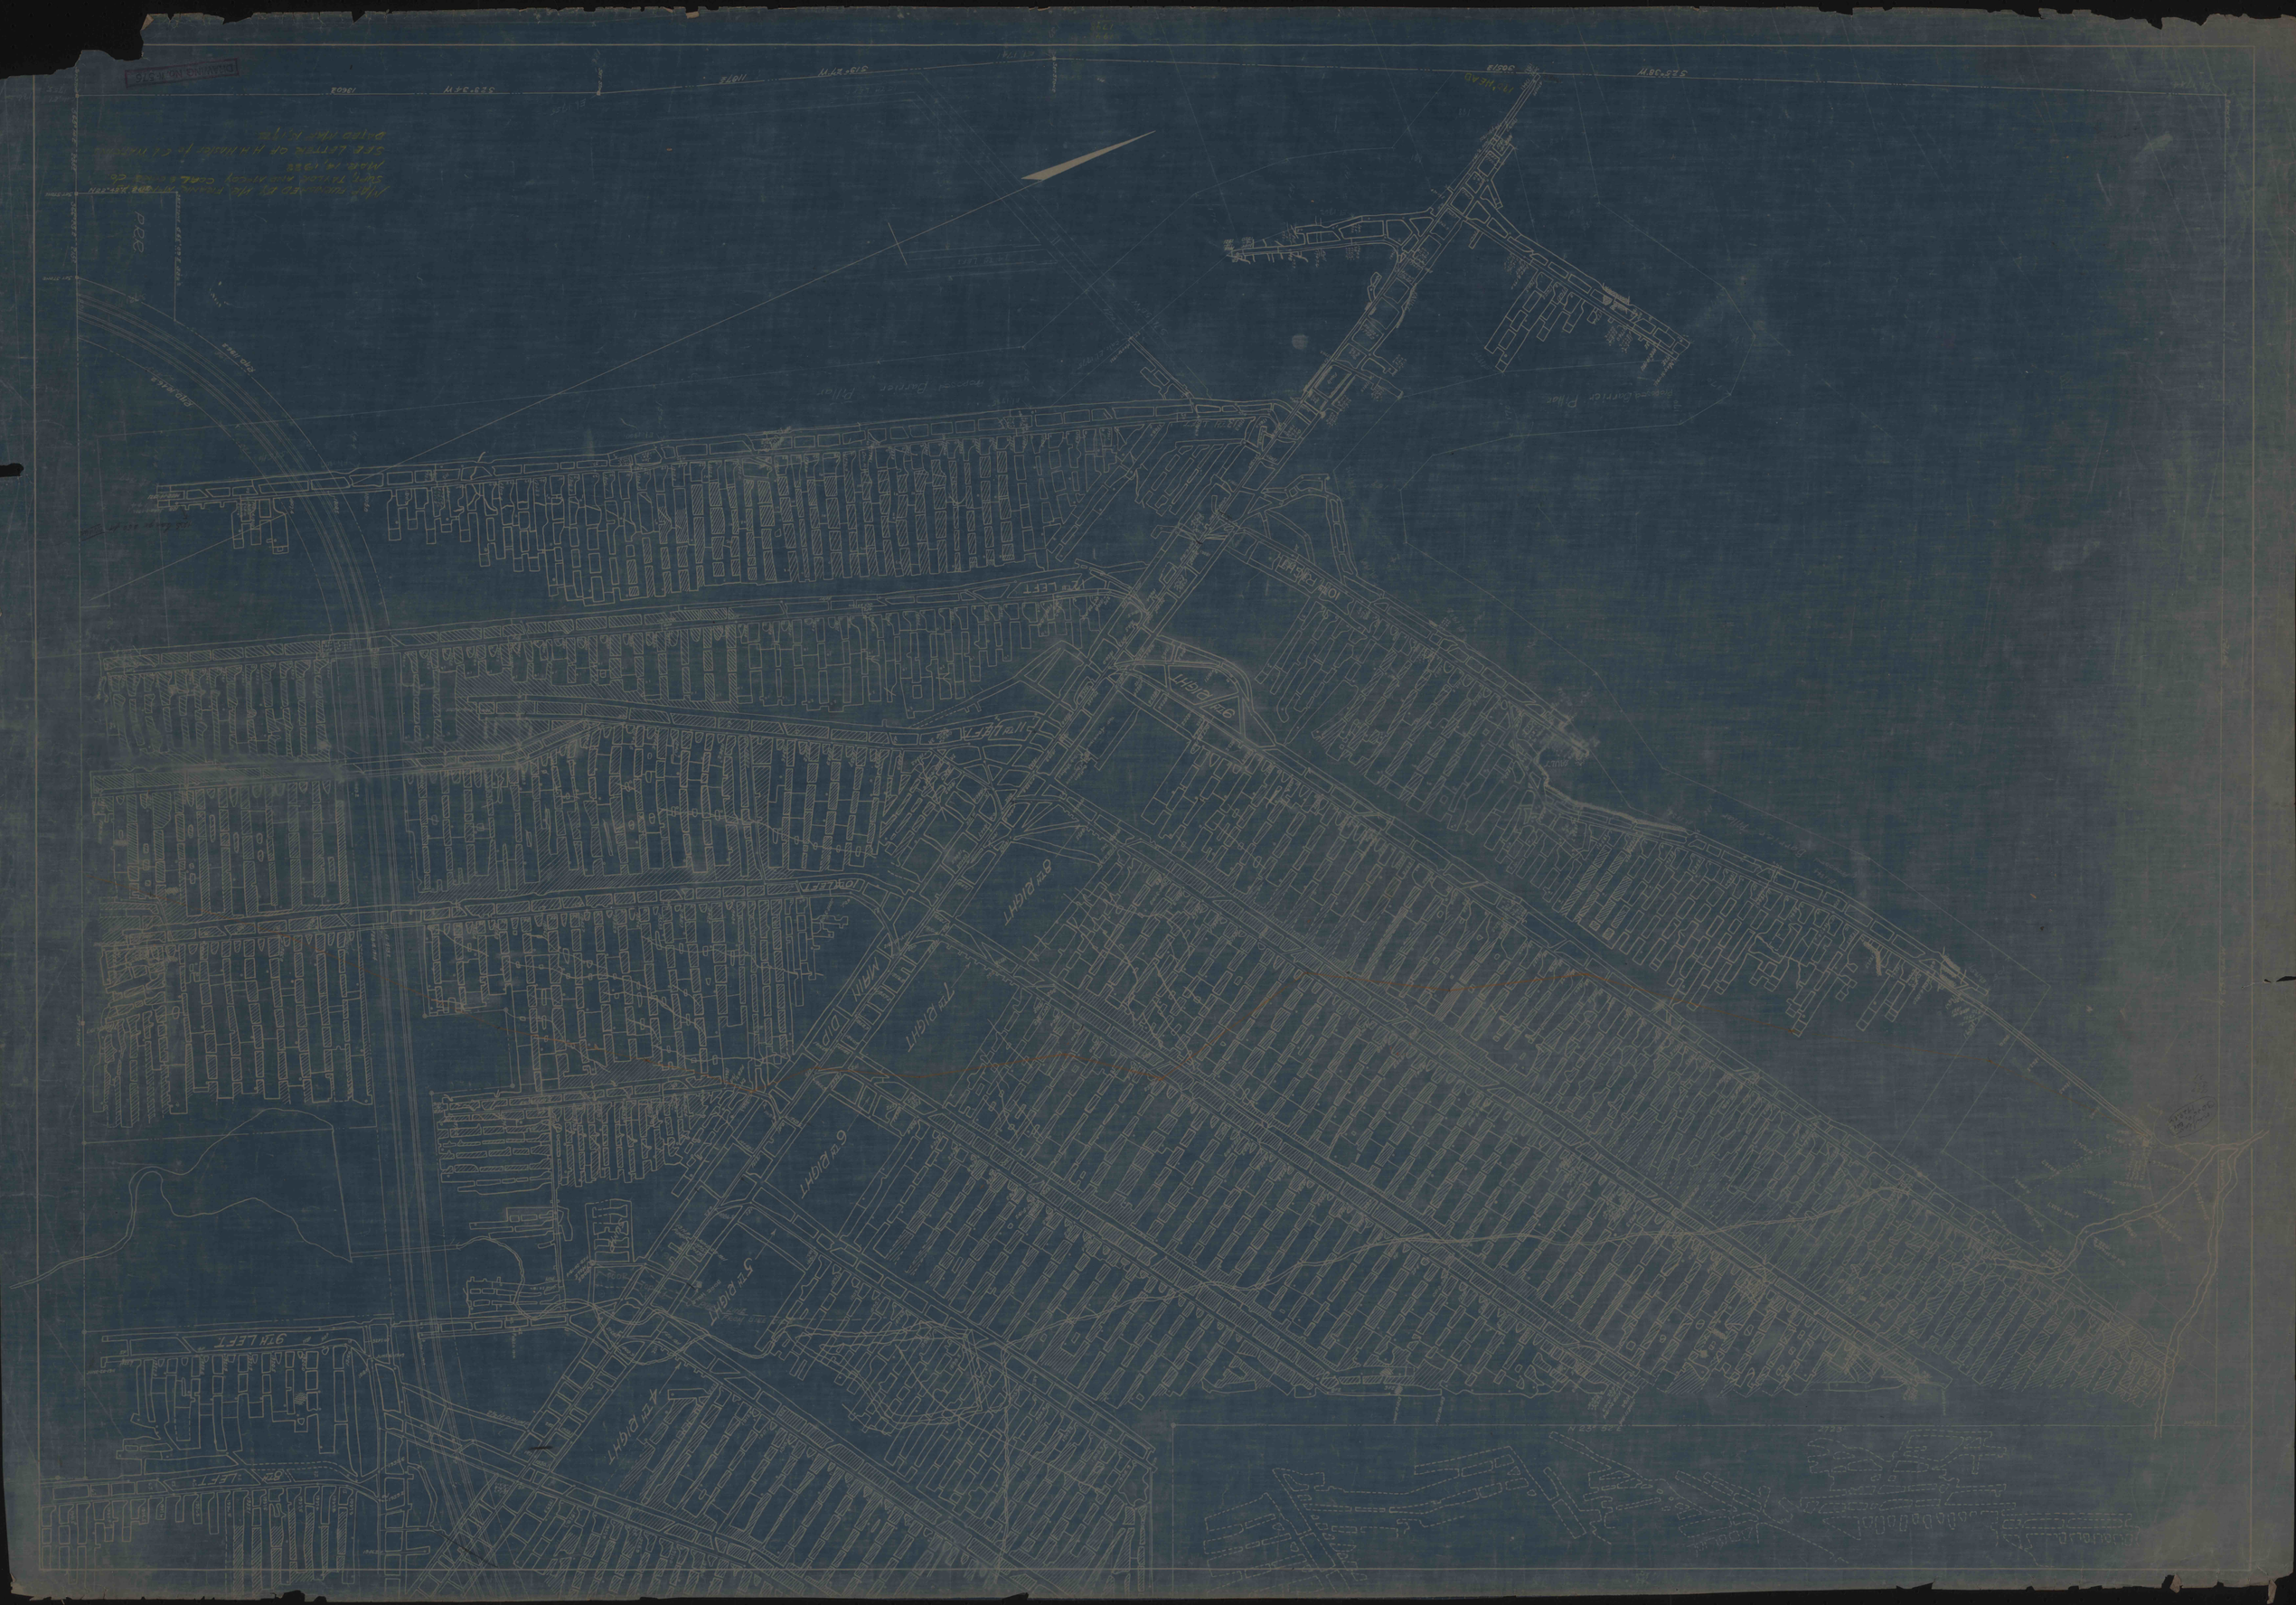

4th RIGHT
5th RIGHT
6th RIGHT
7th RIGHT
8th RIGHT
9th RIGHT
10th RIGHT
MAIN DIP
8th LEFT
9th LEFT
10th LEFT
11th LEFT
12th LEFT
Barrier Pillar
Barrier Pillar
P.R.R.
SET STONE
SET STONE
S65°09'E 332
S66°25'E 2152
S65°14'E 2352
N22°45'E 2192
S23°34'W
13603
S19°27'W
11872
S23°34'W
Calc. El. 1755
Surf. 1930.0
Surf. 1931.7
Surf. 1926.6
1931.8
overflow
J.C.&C.C. ELEV
1928.82

MAP FURNISHED BY MR. FRANK Mc[illegible]
SUPT. TAYLOR AND McCOY COAL & COKE Co.
MAR. 14, 1922
SEE LETTER OF H.H. Haster to C.L. WATSON
DATED MAR 15, 1922

DRAWING No. W-576