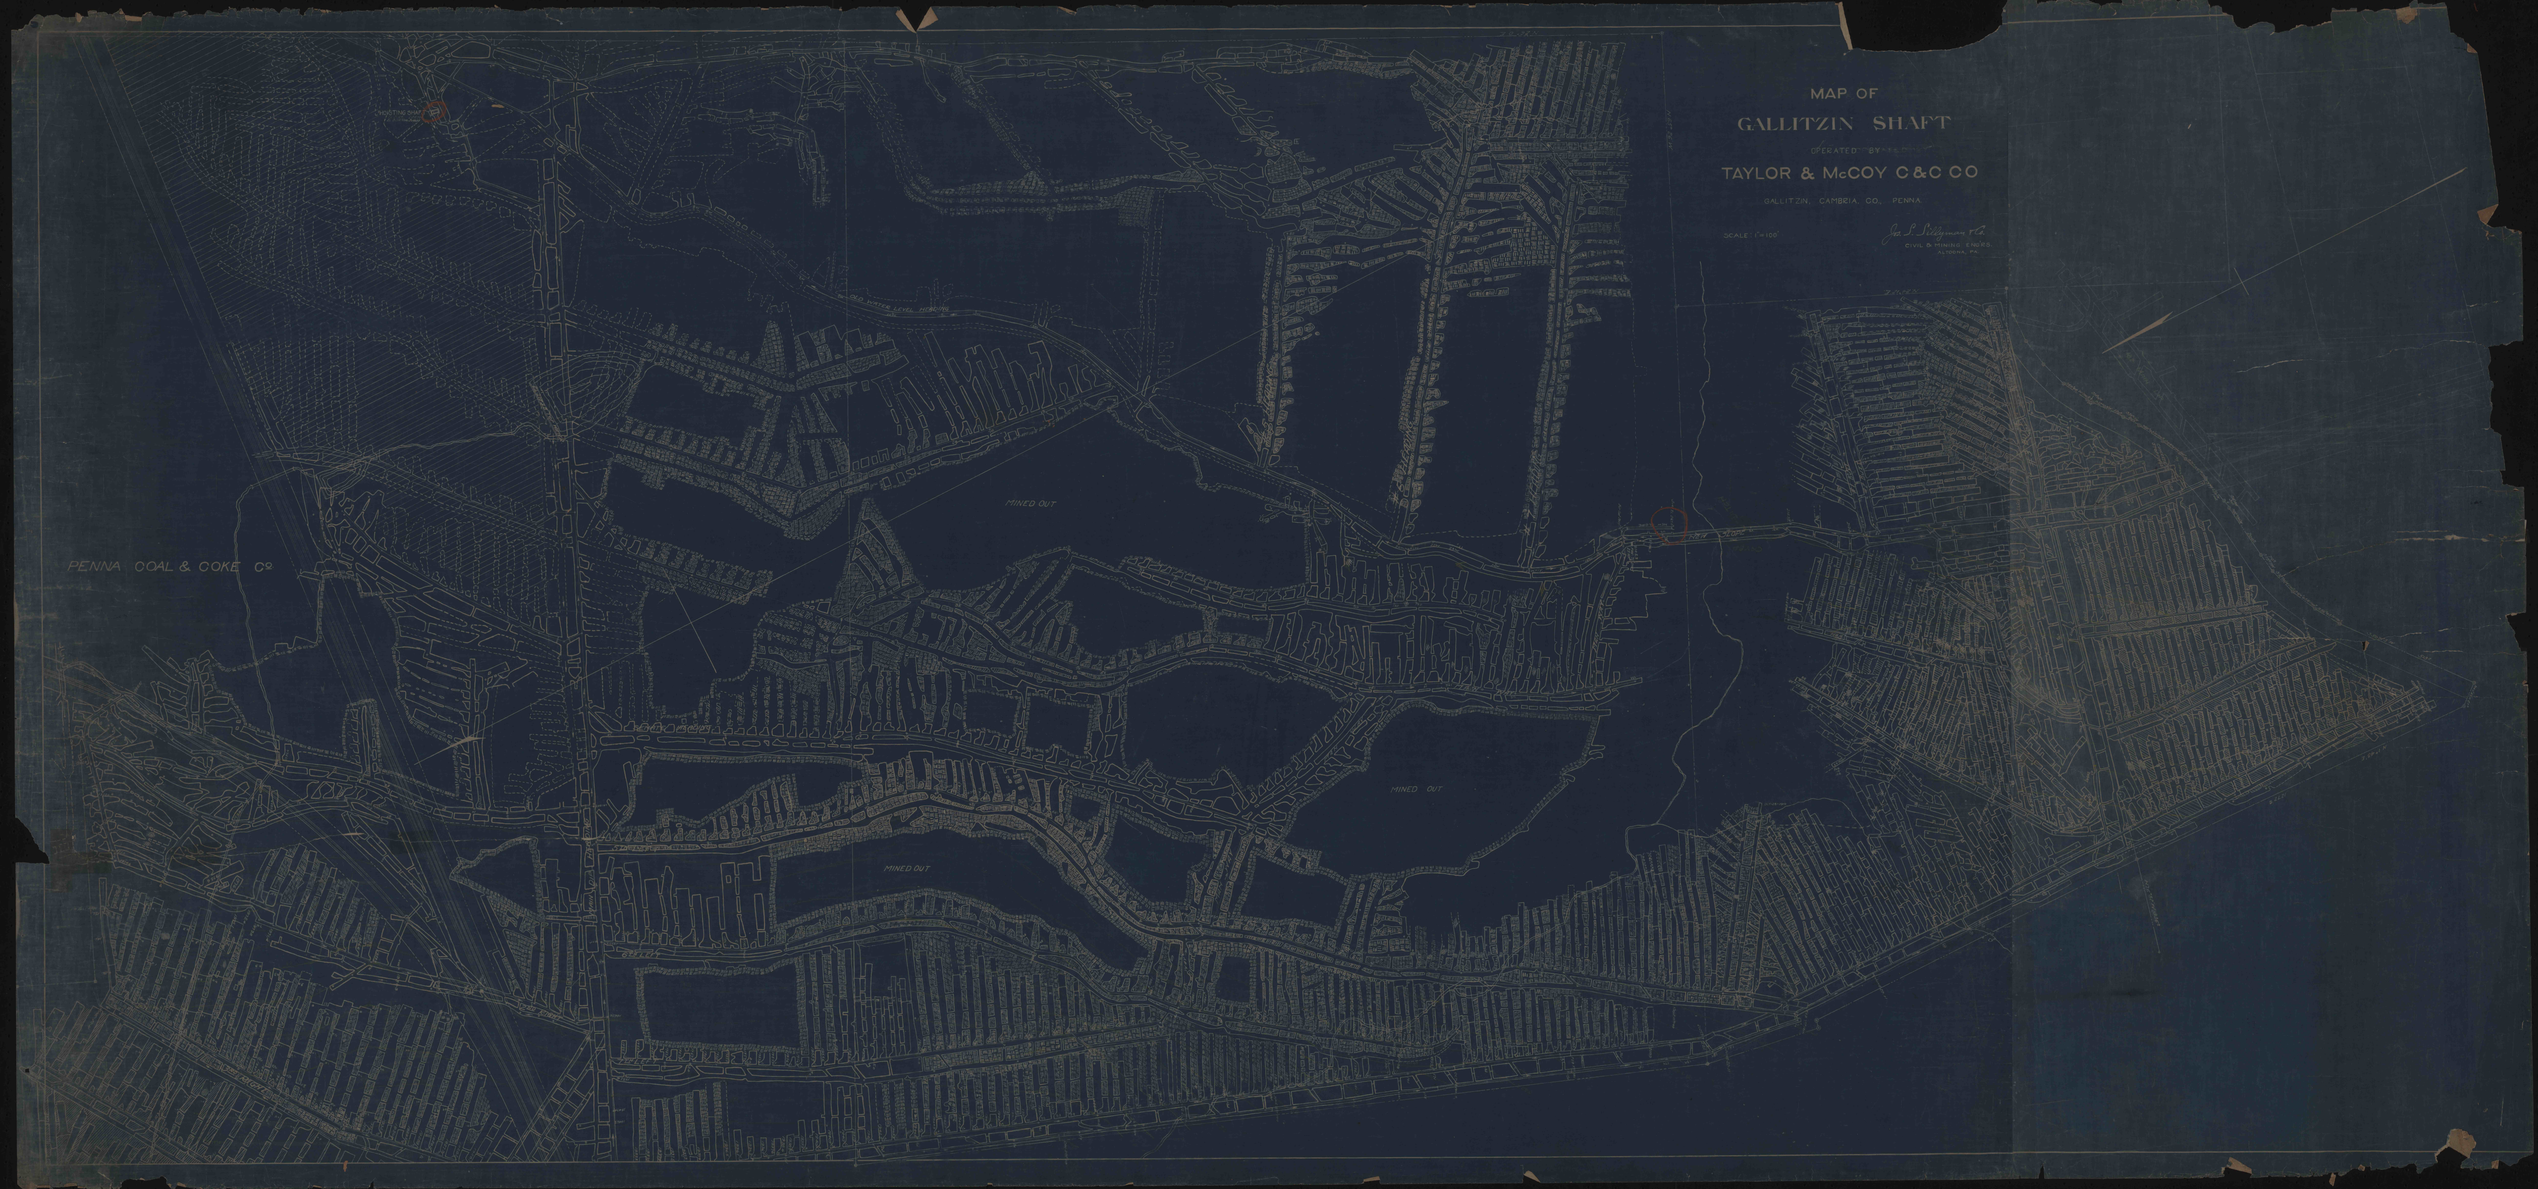
MAP OF
GALLITZIN SHAFT
OPERATED BY
TAYLOR & McCOY C&C CO
GALLITZIN, CAMBRIA, CO., PENNA.
SCALE: 1"=100'
CIVIL & MINING ENGRS.
ALTOONA, PA.
PENNA COAL & COKE Co
MINED OUT
MINED OUT
MINED OUT