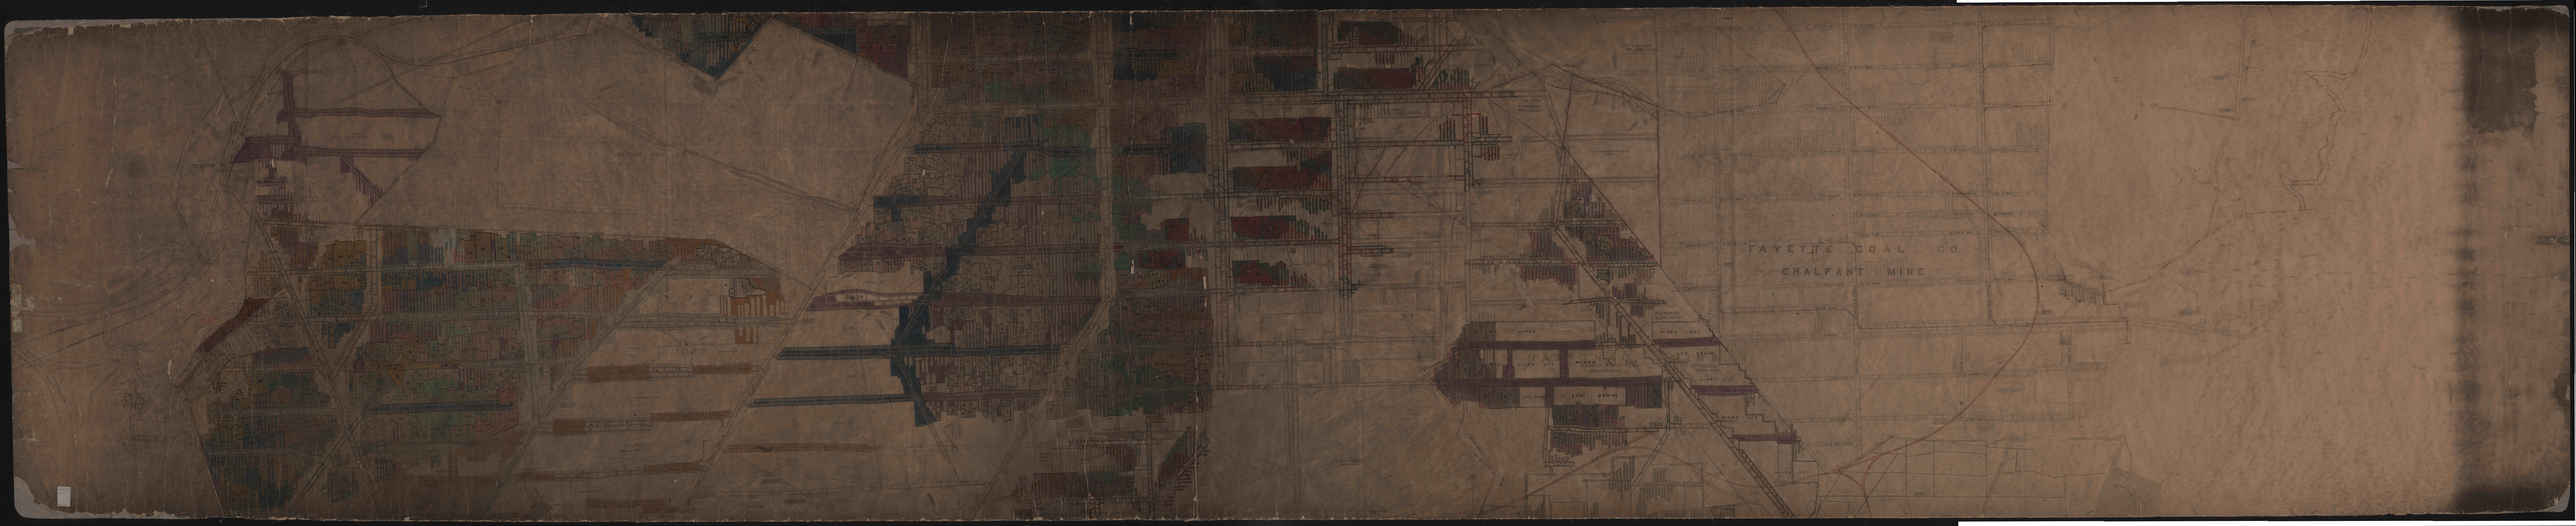

FAYETTE COAL CO.
CHALFANT MINE