


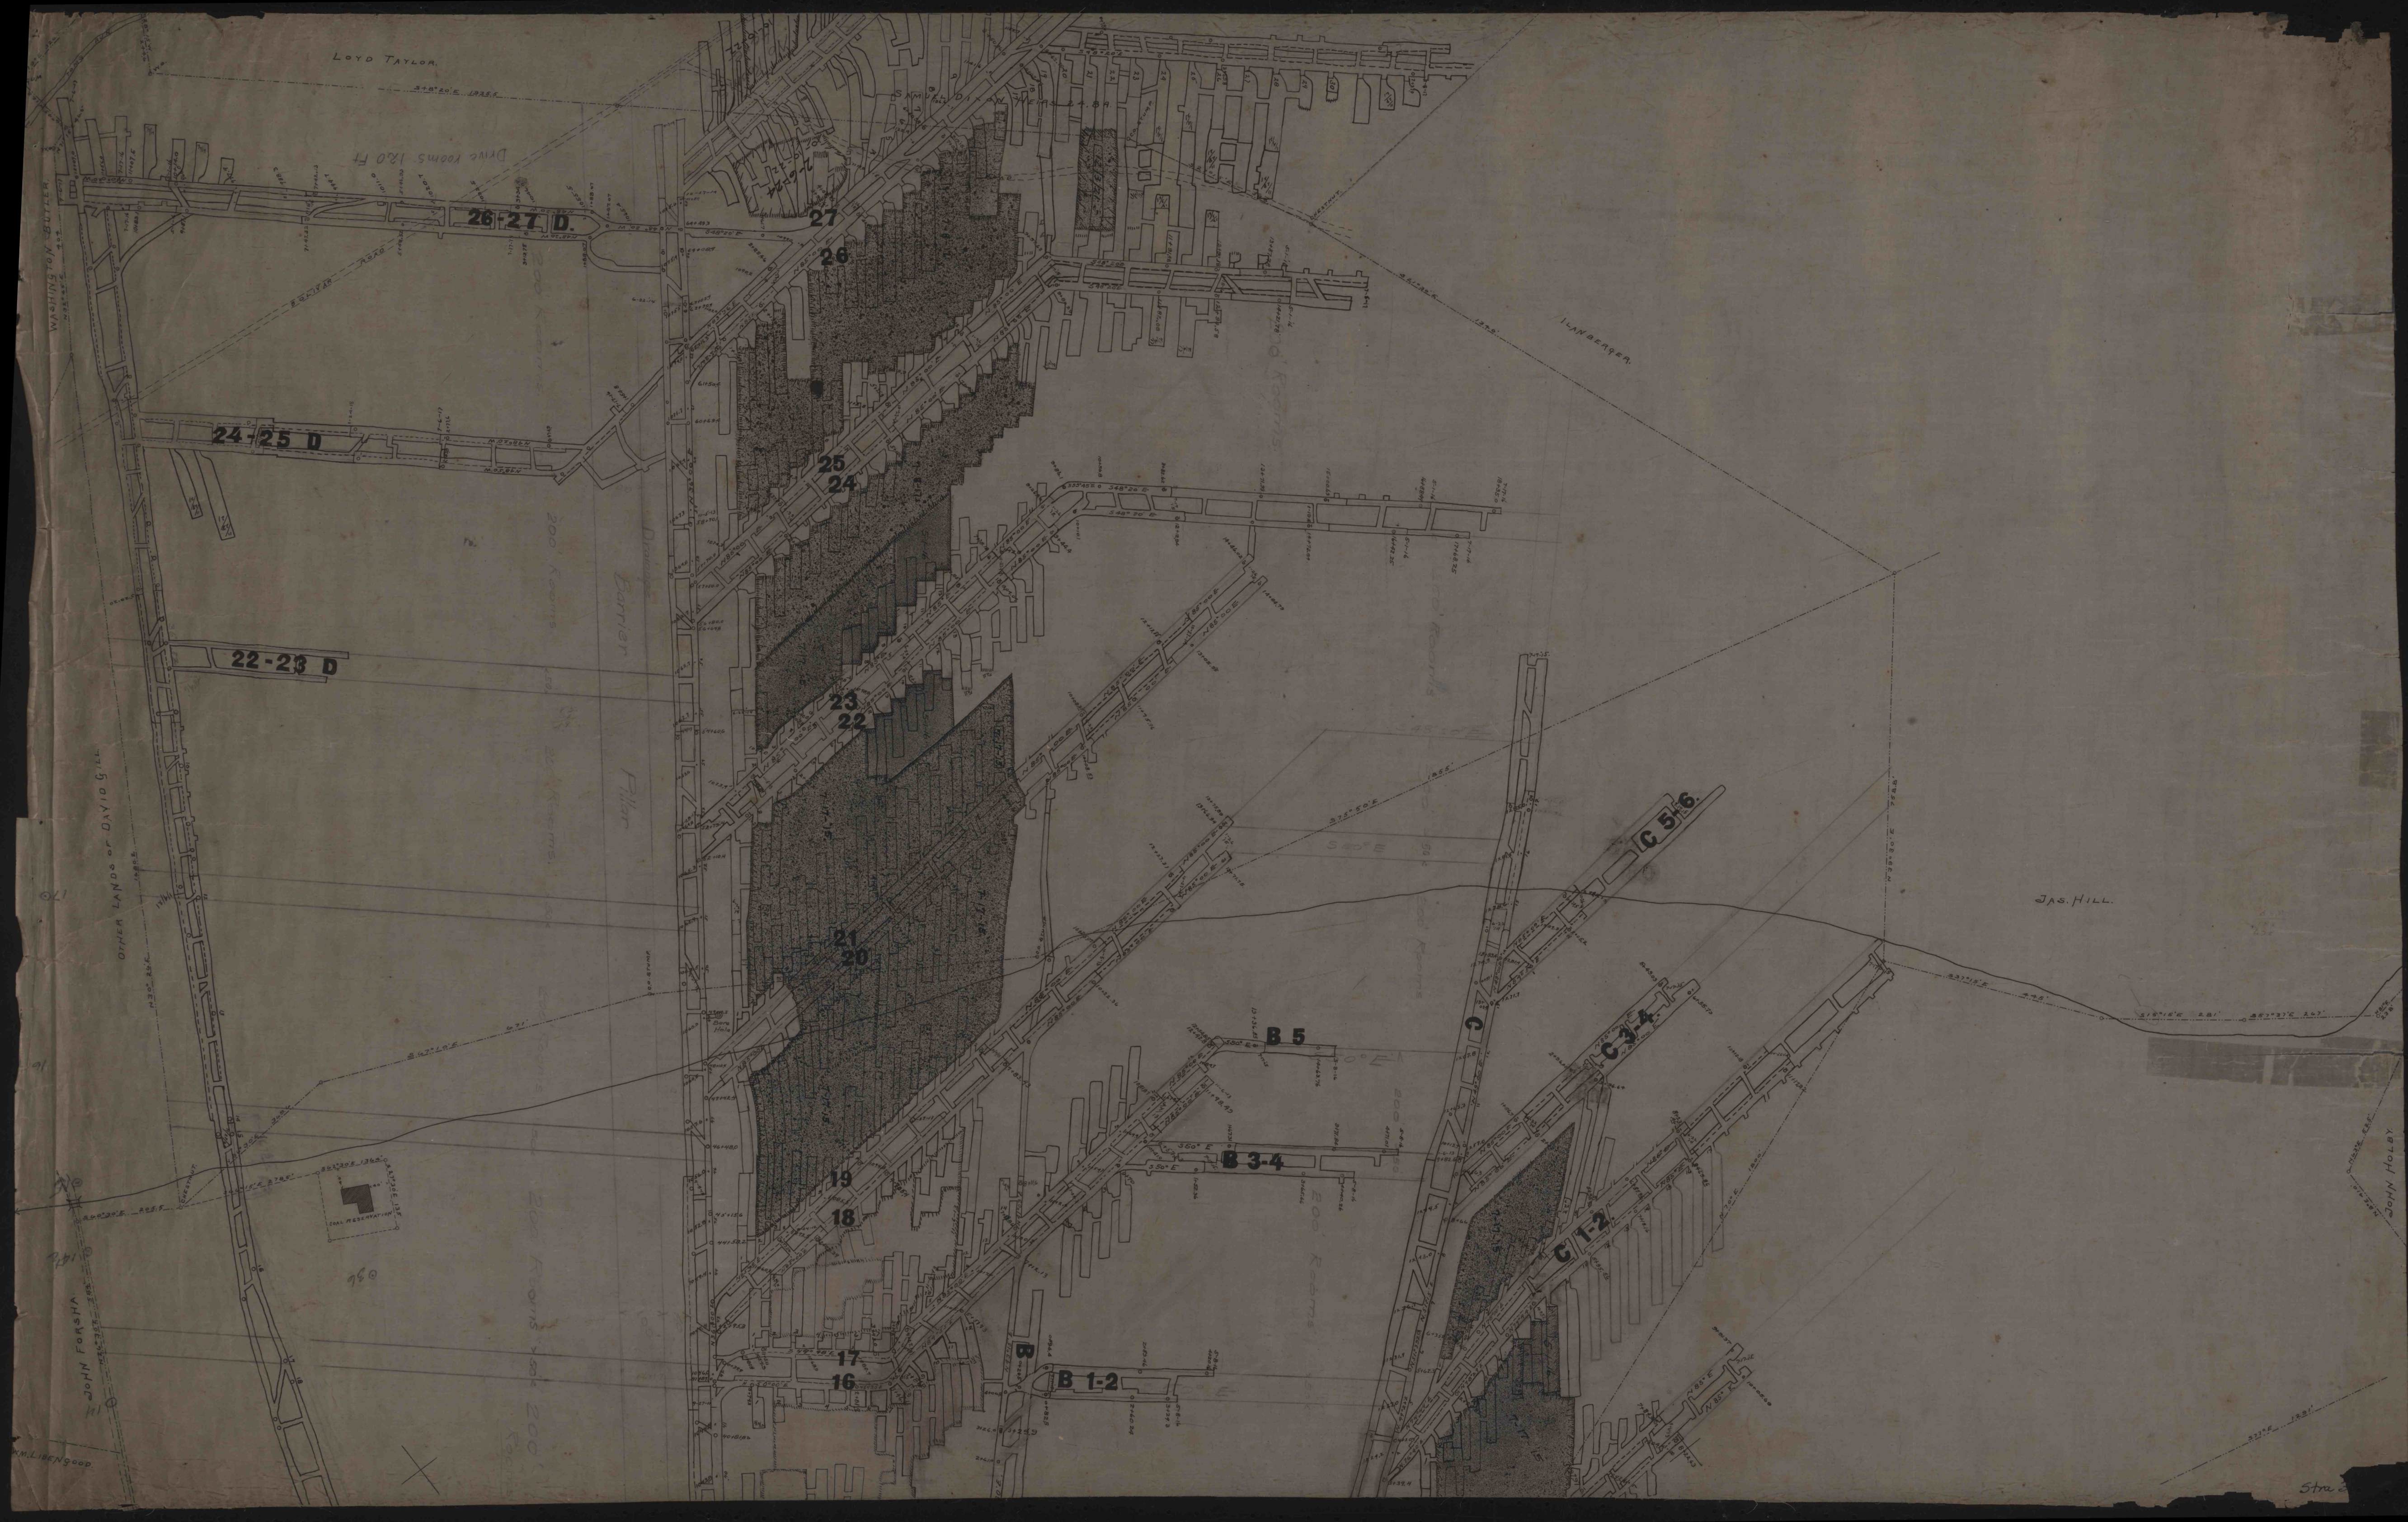

LOYD TAYLOR

Drive rooms 180 Ft

26-27 D

27

26

25

24

24-25 D

22-23 D

23

22

21

20

19

18

17

16

B 5

B 3-4

B 1-2

C 5-6

C 3-4

C 1-2

JAS. HILL

JOHN HOLBY

JOHN FORSHA

K. LIBENGOOD

5th St