


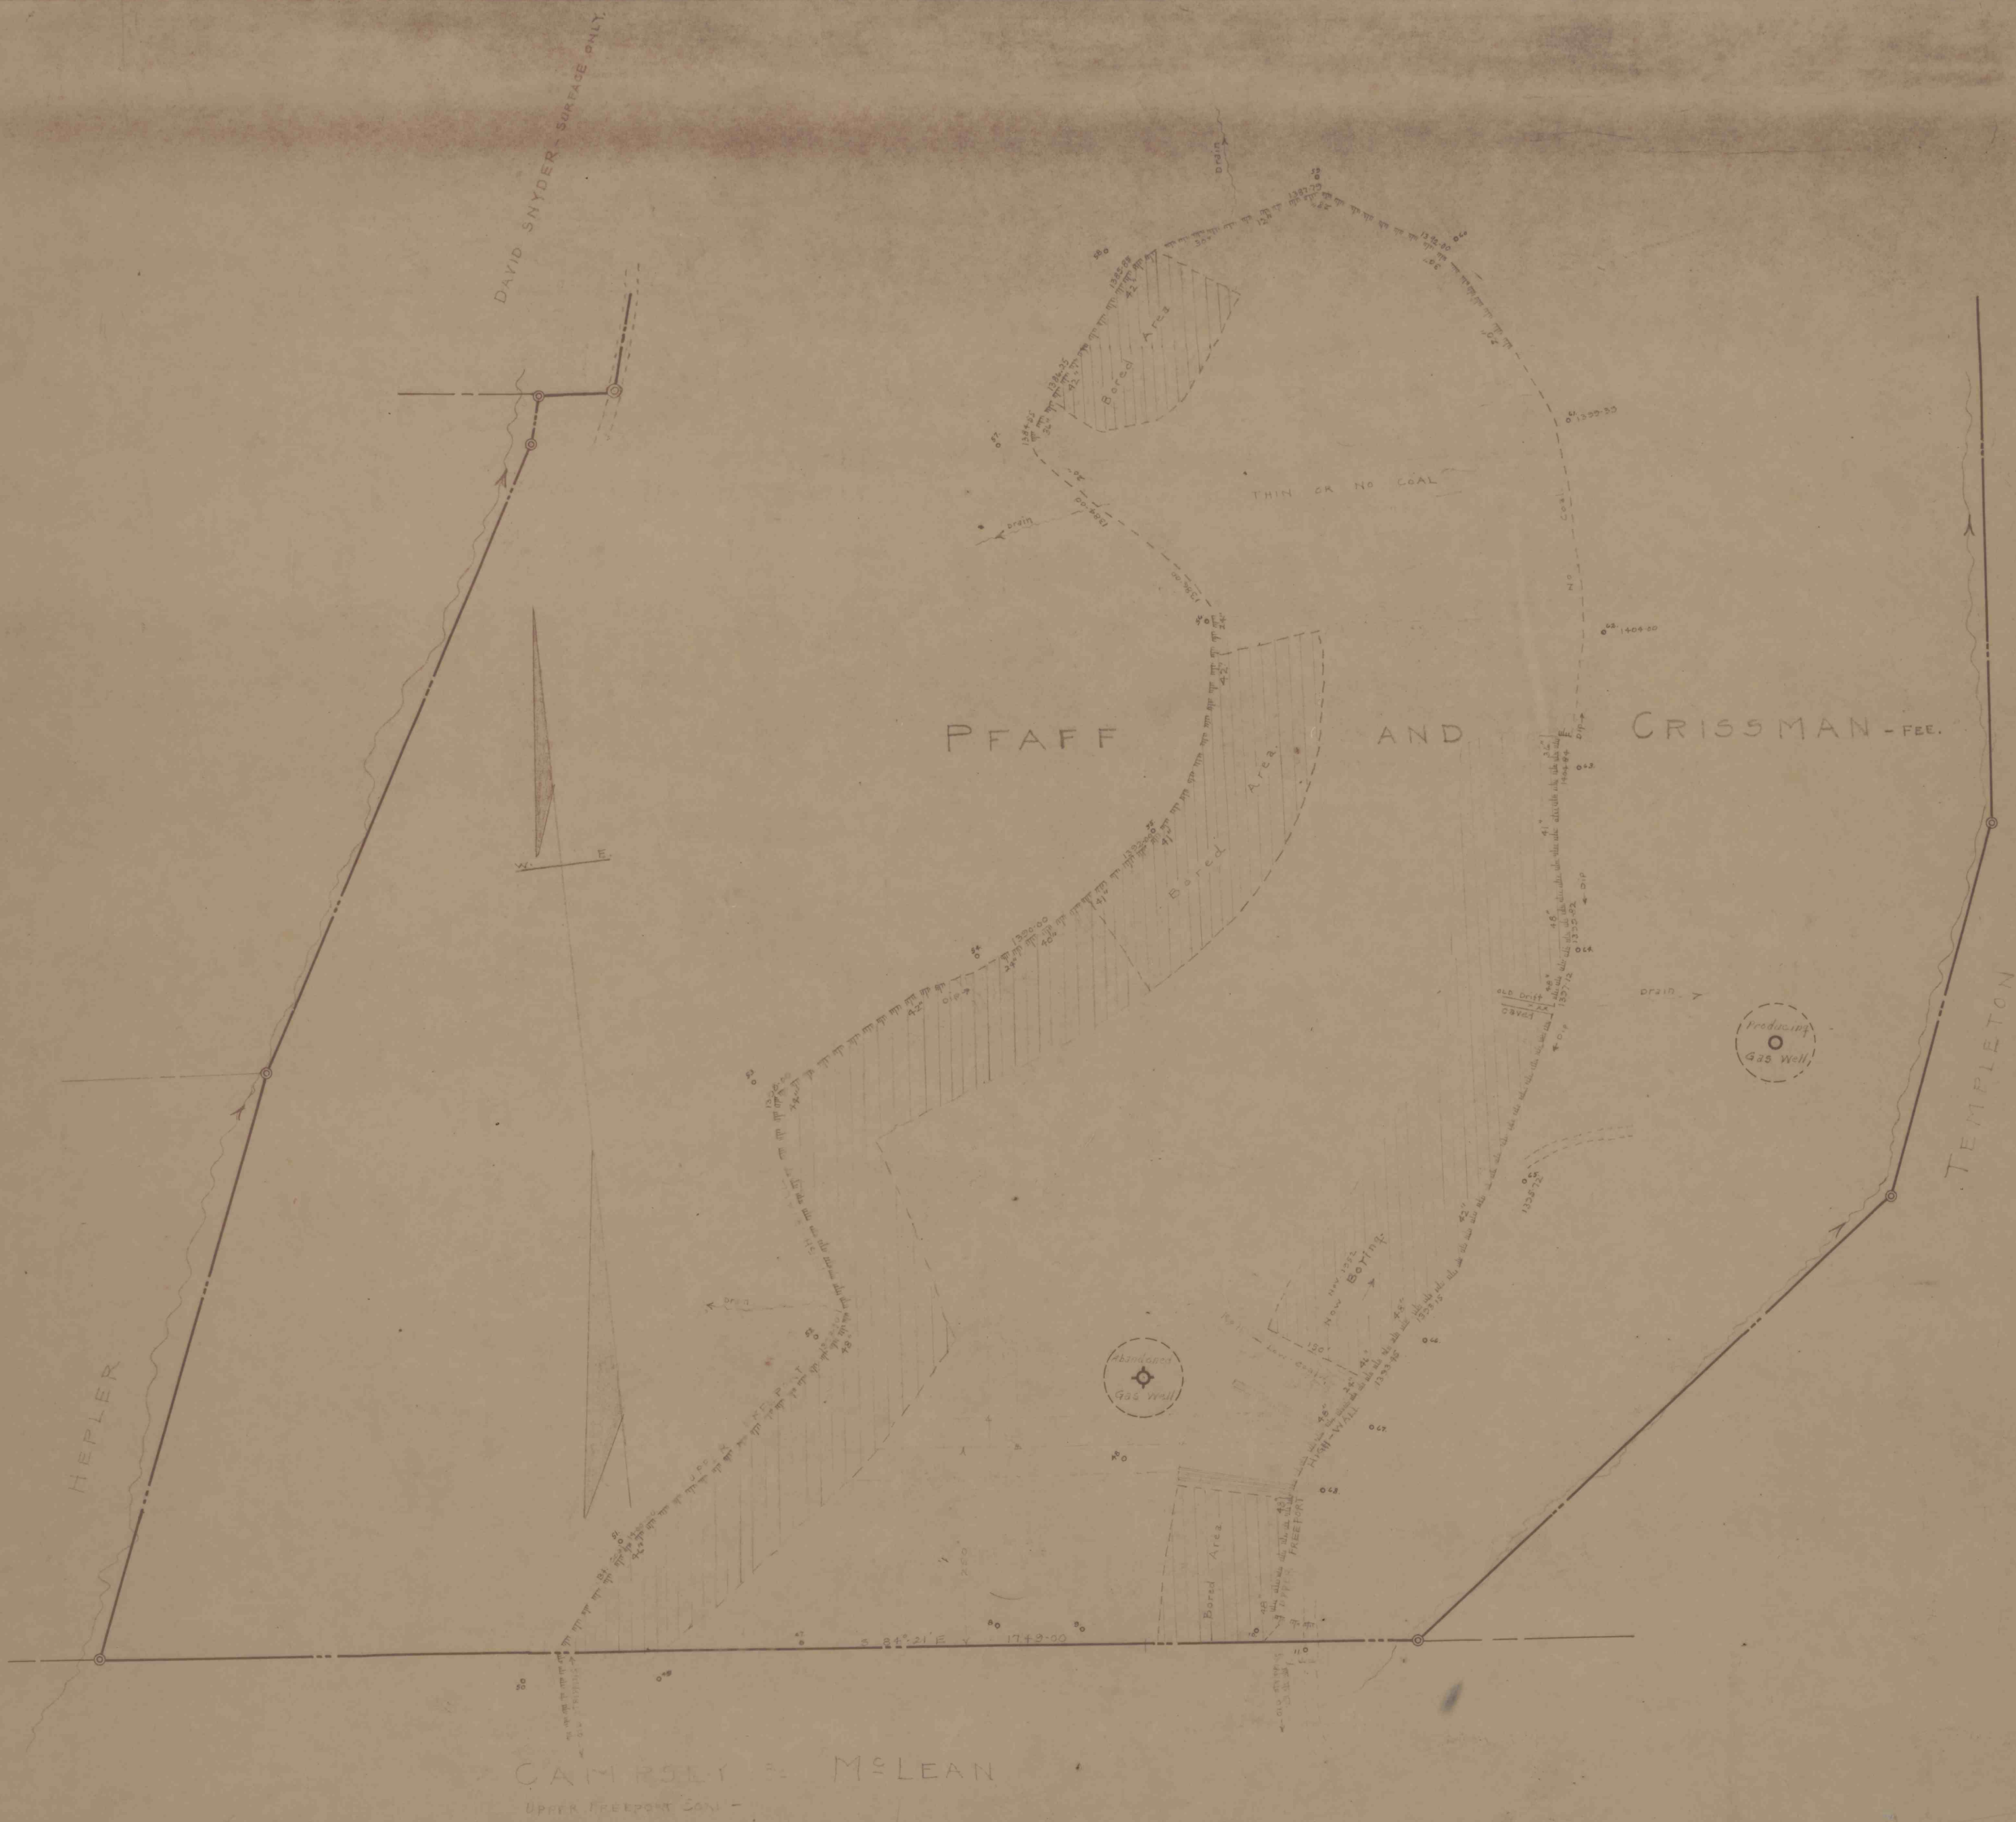

MAP SHOWING
 HIGH-WALL ON UPPER-FREEPORT COAL
 PFAFF AND CRISSMAN PROPERTY
 SUGAR CREEK TWP. ARMSTRONG CO.
 HARCLIFF COAL CO. - COAL STRIPPING
 Date Surveyed 11-18-52. Scale 1" = 100'