


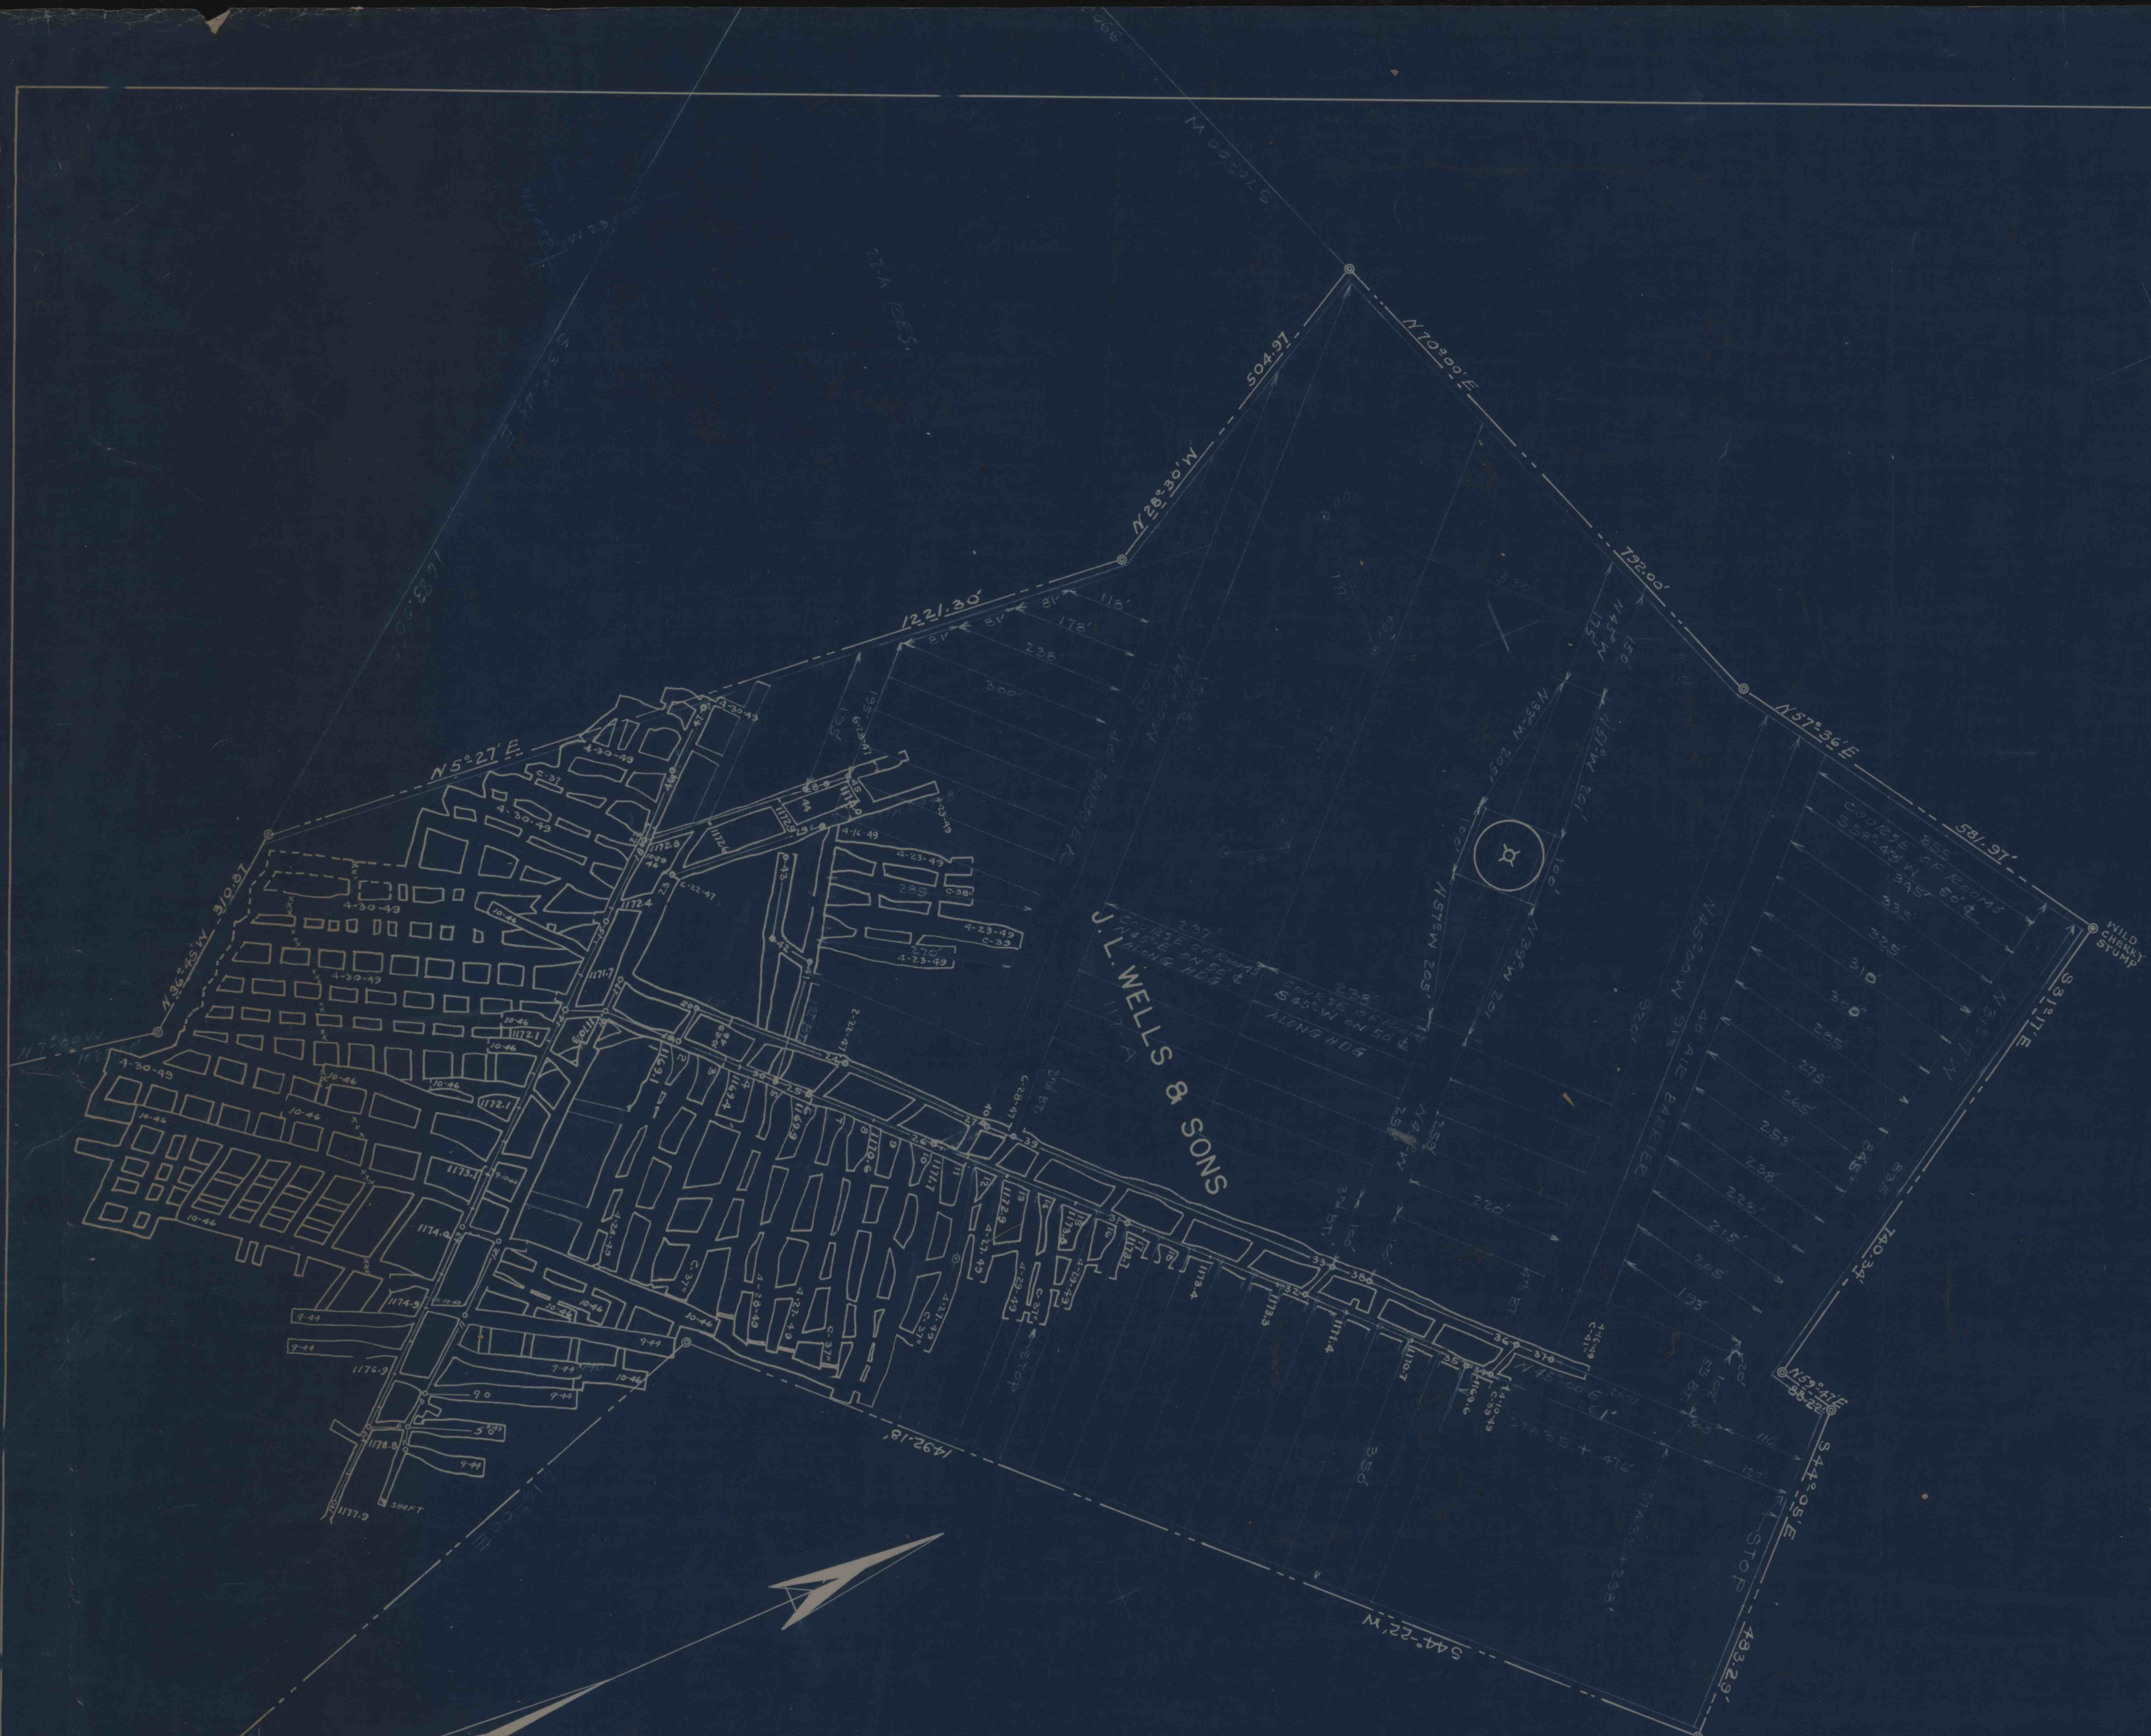

J.L. WELLS & SONS MINE
SOUTH BEND TOWNSHIP
ARMSTRONG COUNTY
SCALE 1" = 100'
SURVEYED BY - H.W. MIKESELL, R.P.E.
EXTENDED TO SEPT. 10, 1944
REVISED - OCT. 29, 1946
" - JUNE - 6 - 1947
" - MAY - 1 - 1949