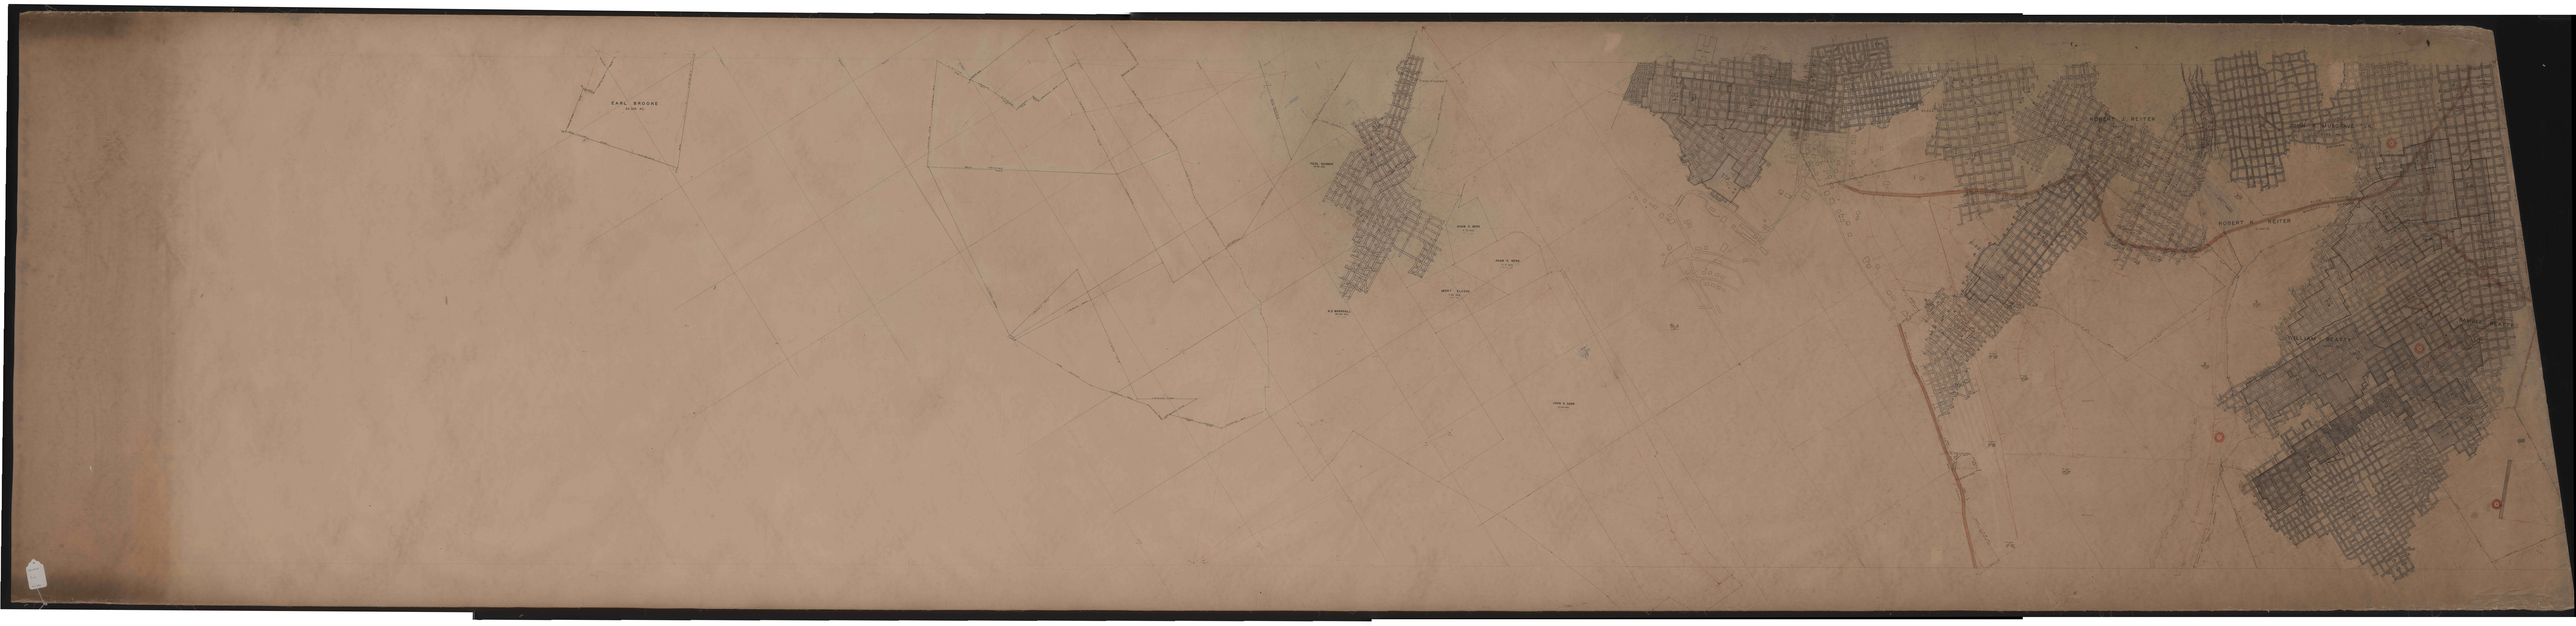
EARL BROOKE
ROBERT C. REITER
ROBERT C. REITER
WILLIAM BEATTY
WILLIAM BEATTY