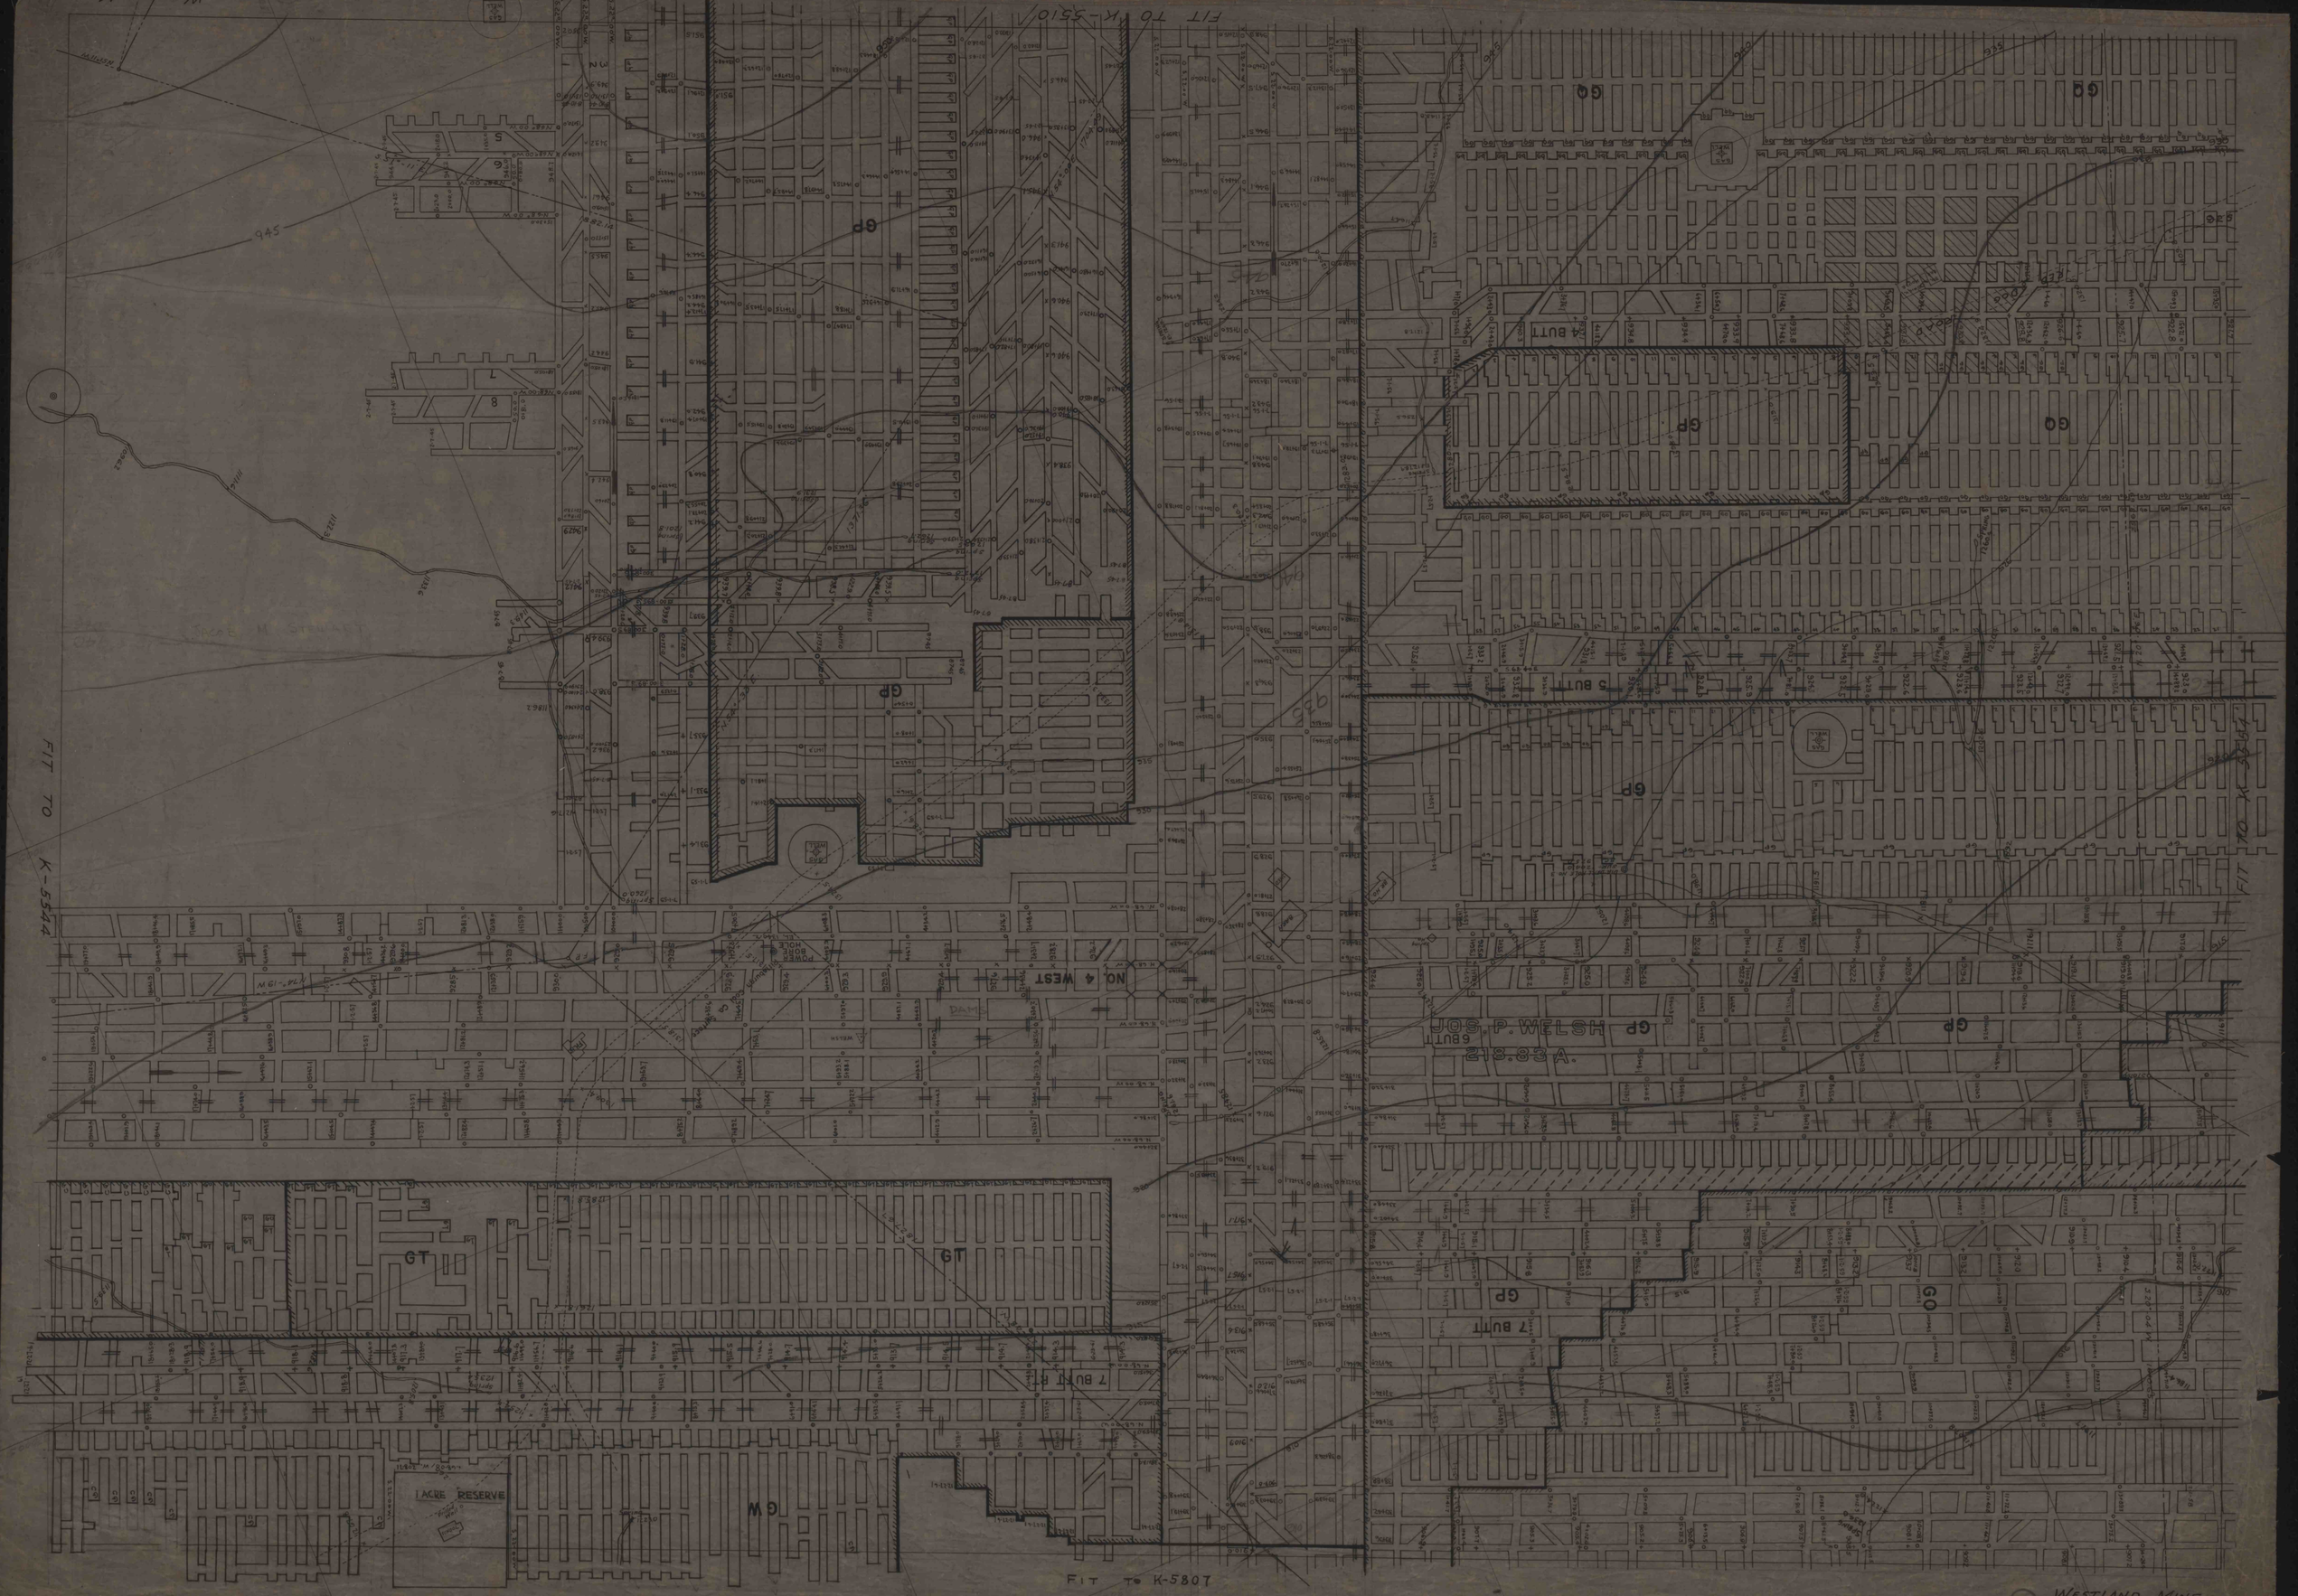
WESTLAND MINE
K-5543
FIT TO K-5510
FIT TO K-5544
FIT TO K-5507
NO. 4 WEST
JOS. P. WELSH
GP
GQ
GT
GW
4 BUTT
5 BUTT
6 BUTT
7 BUTT
1 ACRE RESERVE
945
935