


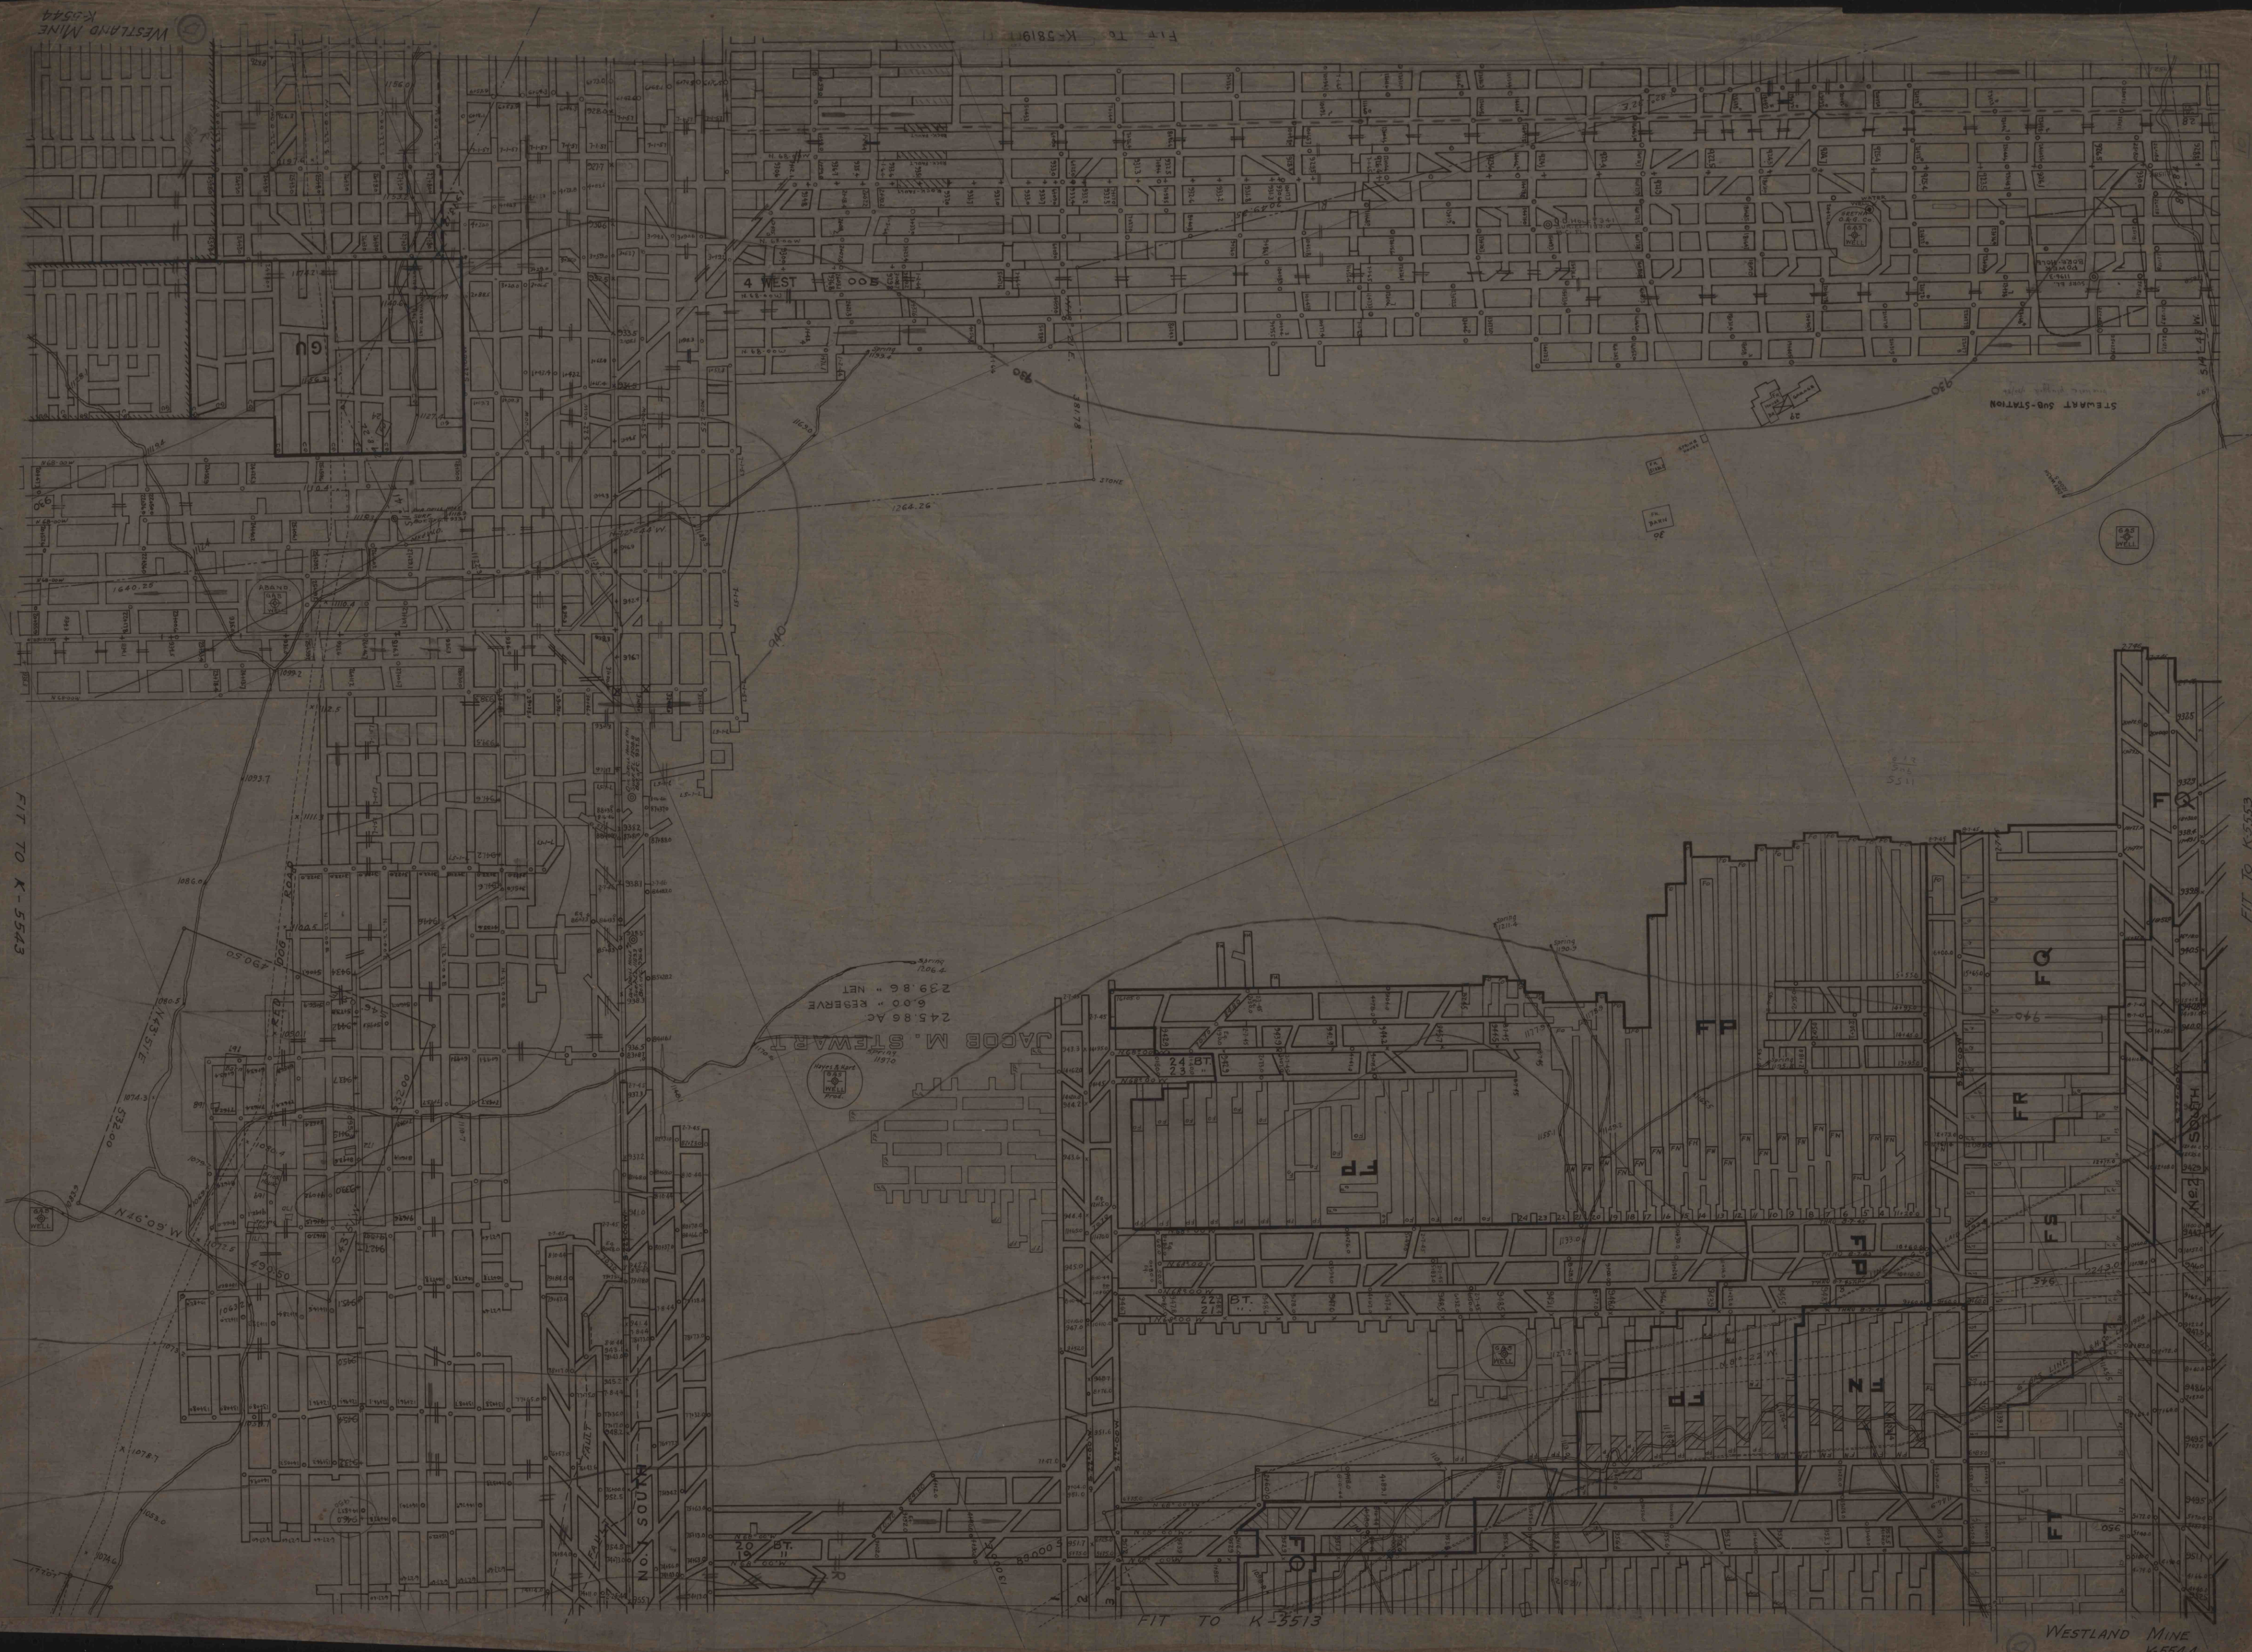

WESTLAND MINE  
K-5544

FIT TO K-5543

FIT TO K-5819

FIT TO K-5553

FIT TO K-5513

WESTLAND MINE  
K-5544