


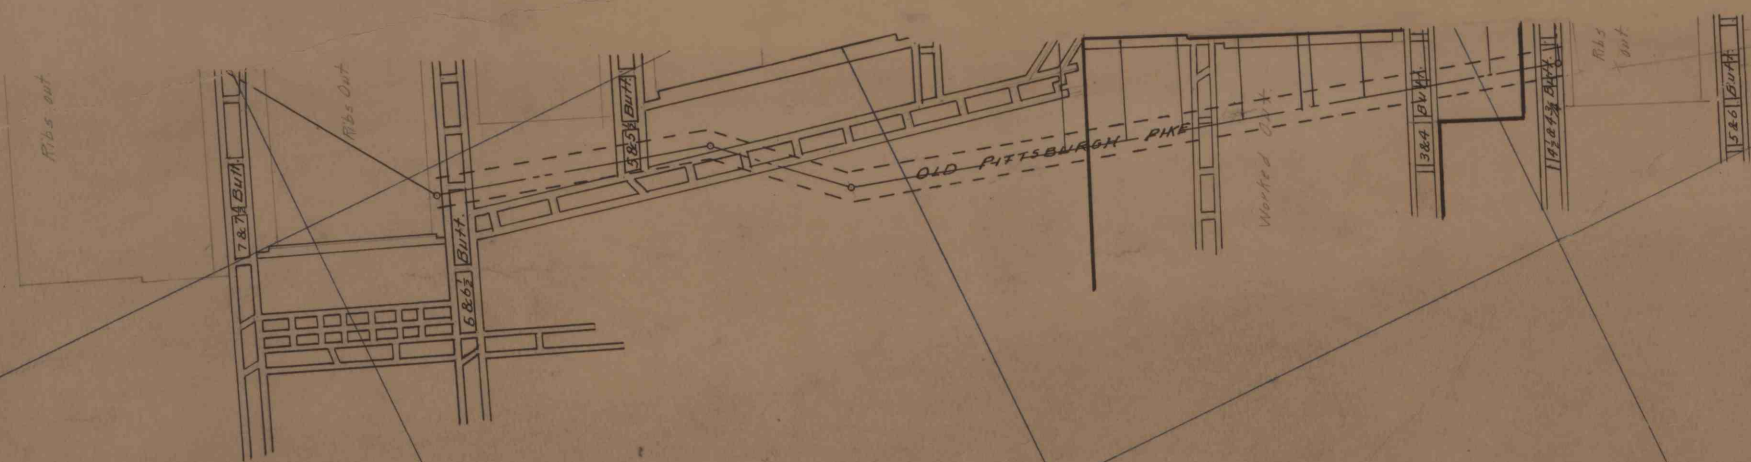

Old Pittsburgh
Pike, Ribs cut

XSI-791