


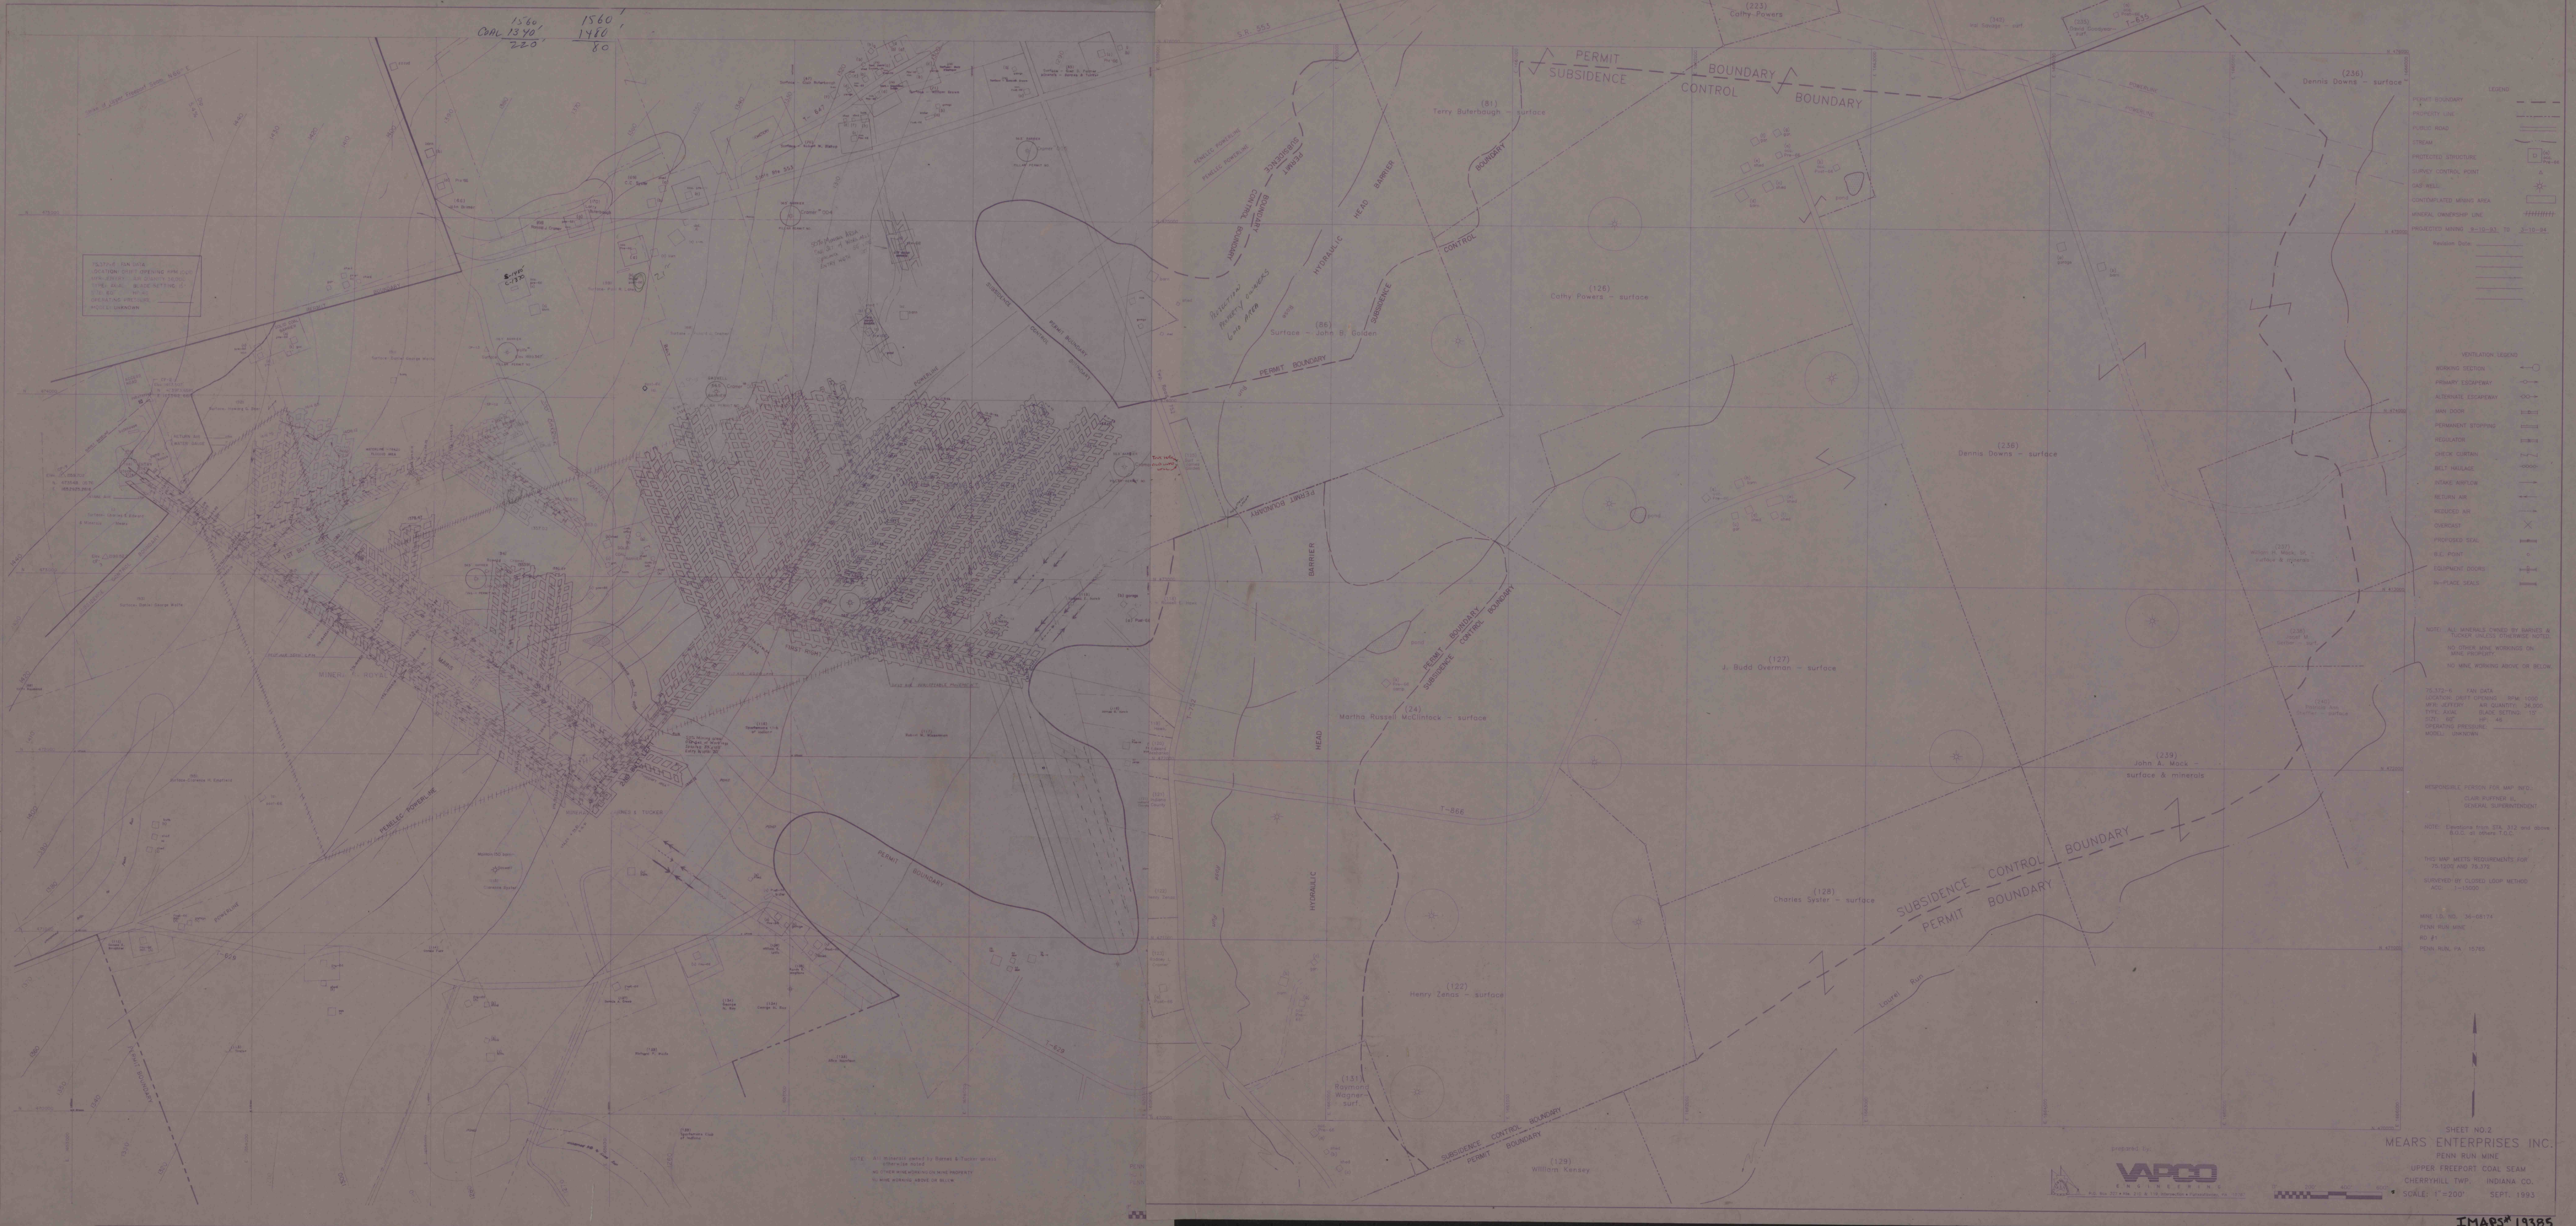

- LEGEND
- PERMIT BOUNDARY
 - PROPERTY LINE
 - PUBLIC ROAD
 - STREAM
 - PROTECTED STRUCTURE
 - SURVEY CONTROL POINT
 - GAS WELL
 - CONTINGENT MINING AREA
 - MINERAL OWNERSHIP LINE
 - PROPOSED MINING AREA

- VENTILATION LEGEND
- WORKING SECTION
 - PRIMARY ESCAPEWAY
 - ALTERNATE ESCAPEWAY
 - MAIN DOOR
 - PERMANENT STOPPING
 - REGULATOR
 - CHECK CURTAIN
 - BELT HAULAGE
 - WATER MAINLINE
 - RETURN AIR
 - REDUCED AIR
 - OVERCAST
 - PROPOSED SEAL
 - S.E. POINT
 - EQUIPMENT DOORS
 - IN-PLACE SEALS

NOTE: ALL MINERALS OWNED BY BARRETT & TUCKER UNLESS OTHERWISE NOTED
NO OTHER MINE WORKINGS ON MINE PROPERTY
NO MINE WORKING ABOVE OR BELOW

75.372-6 FAN DATA
LOCATION: OFF OPENING FROM 1000
MFR: JEFFERY AIR QUANTITY: 36,000
TYPE: AXIAL BLADE SETTING: 15°
D.C.: 40 HP
OPERATING PRESSURE: _____
MODEL: UNKNOWN

RESPONSIBLE PERSON FOR MAP INFO:
CLAIR RUTHERFORD
GENERAL SUPERINTENDENT

NOTE: ELEVATIONS FROM STA. 312 AND ABOVE
B.L.C. AT OTHER T.O.C.

THIS MAP MEETS REQUIREMENTS FOR
75.1200 AND 75.372
SURVEYED BY CLOSED LOOP METHOD
ACC. 1-15-93

MINE I.D. NO. 36-08174
PENN RUN MINE
RD #1
PENN RUN, PA 15765

SHEET NO. 2
MEARS ENTERPRISES INC.
PENN RUN MINE
UPPER FREEPORT COAL SEAM
CHERRYHILL TWP. INDIANA CO.
SCALE: 1"=200' SEPT. 1993



IMAPS 19385