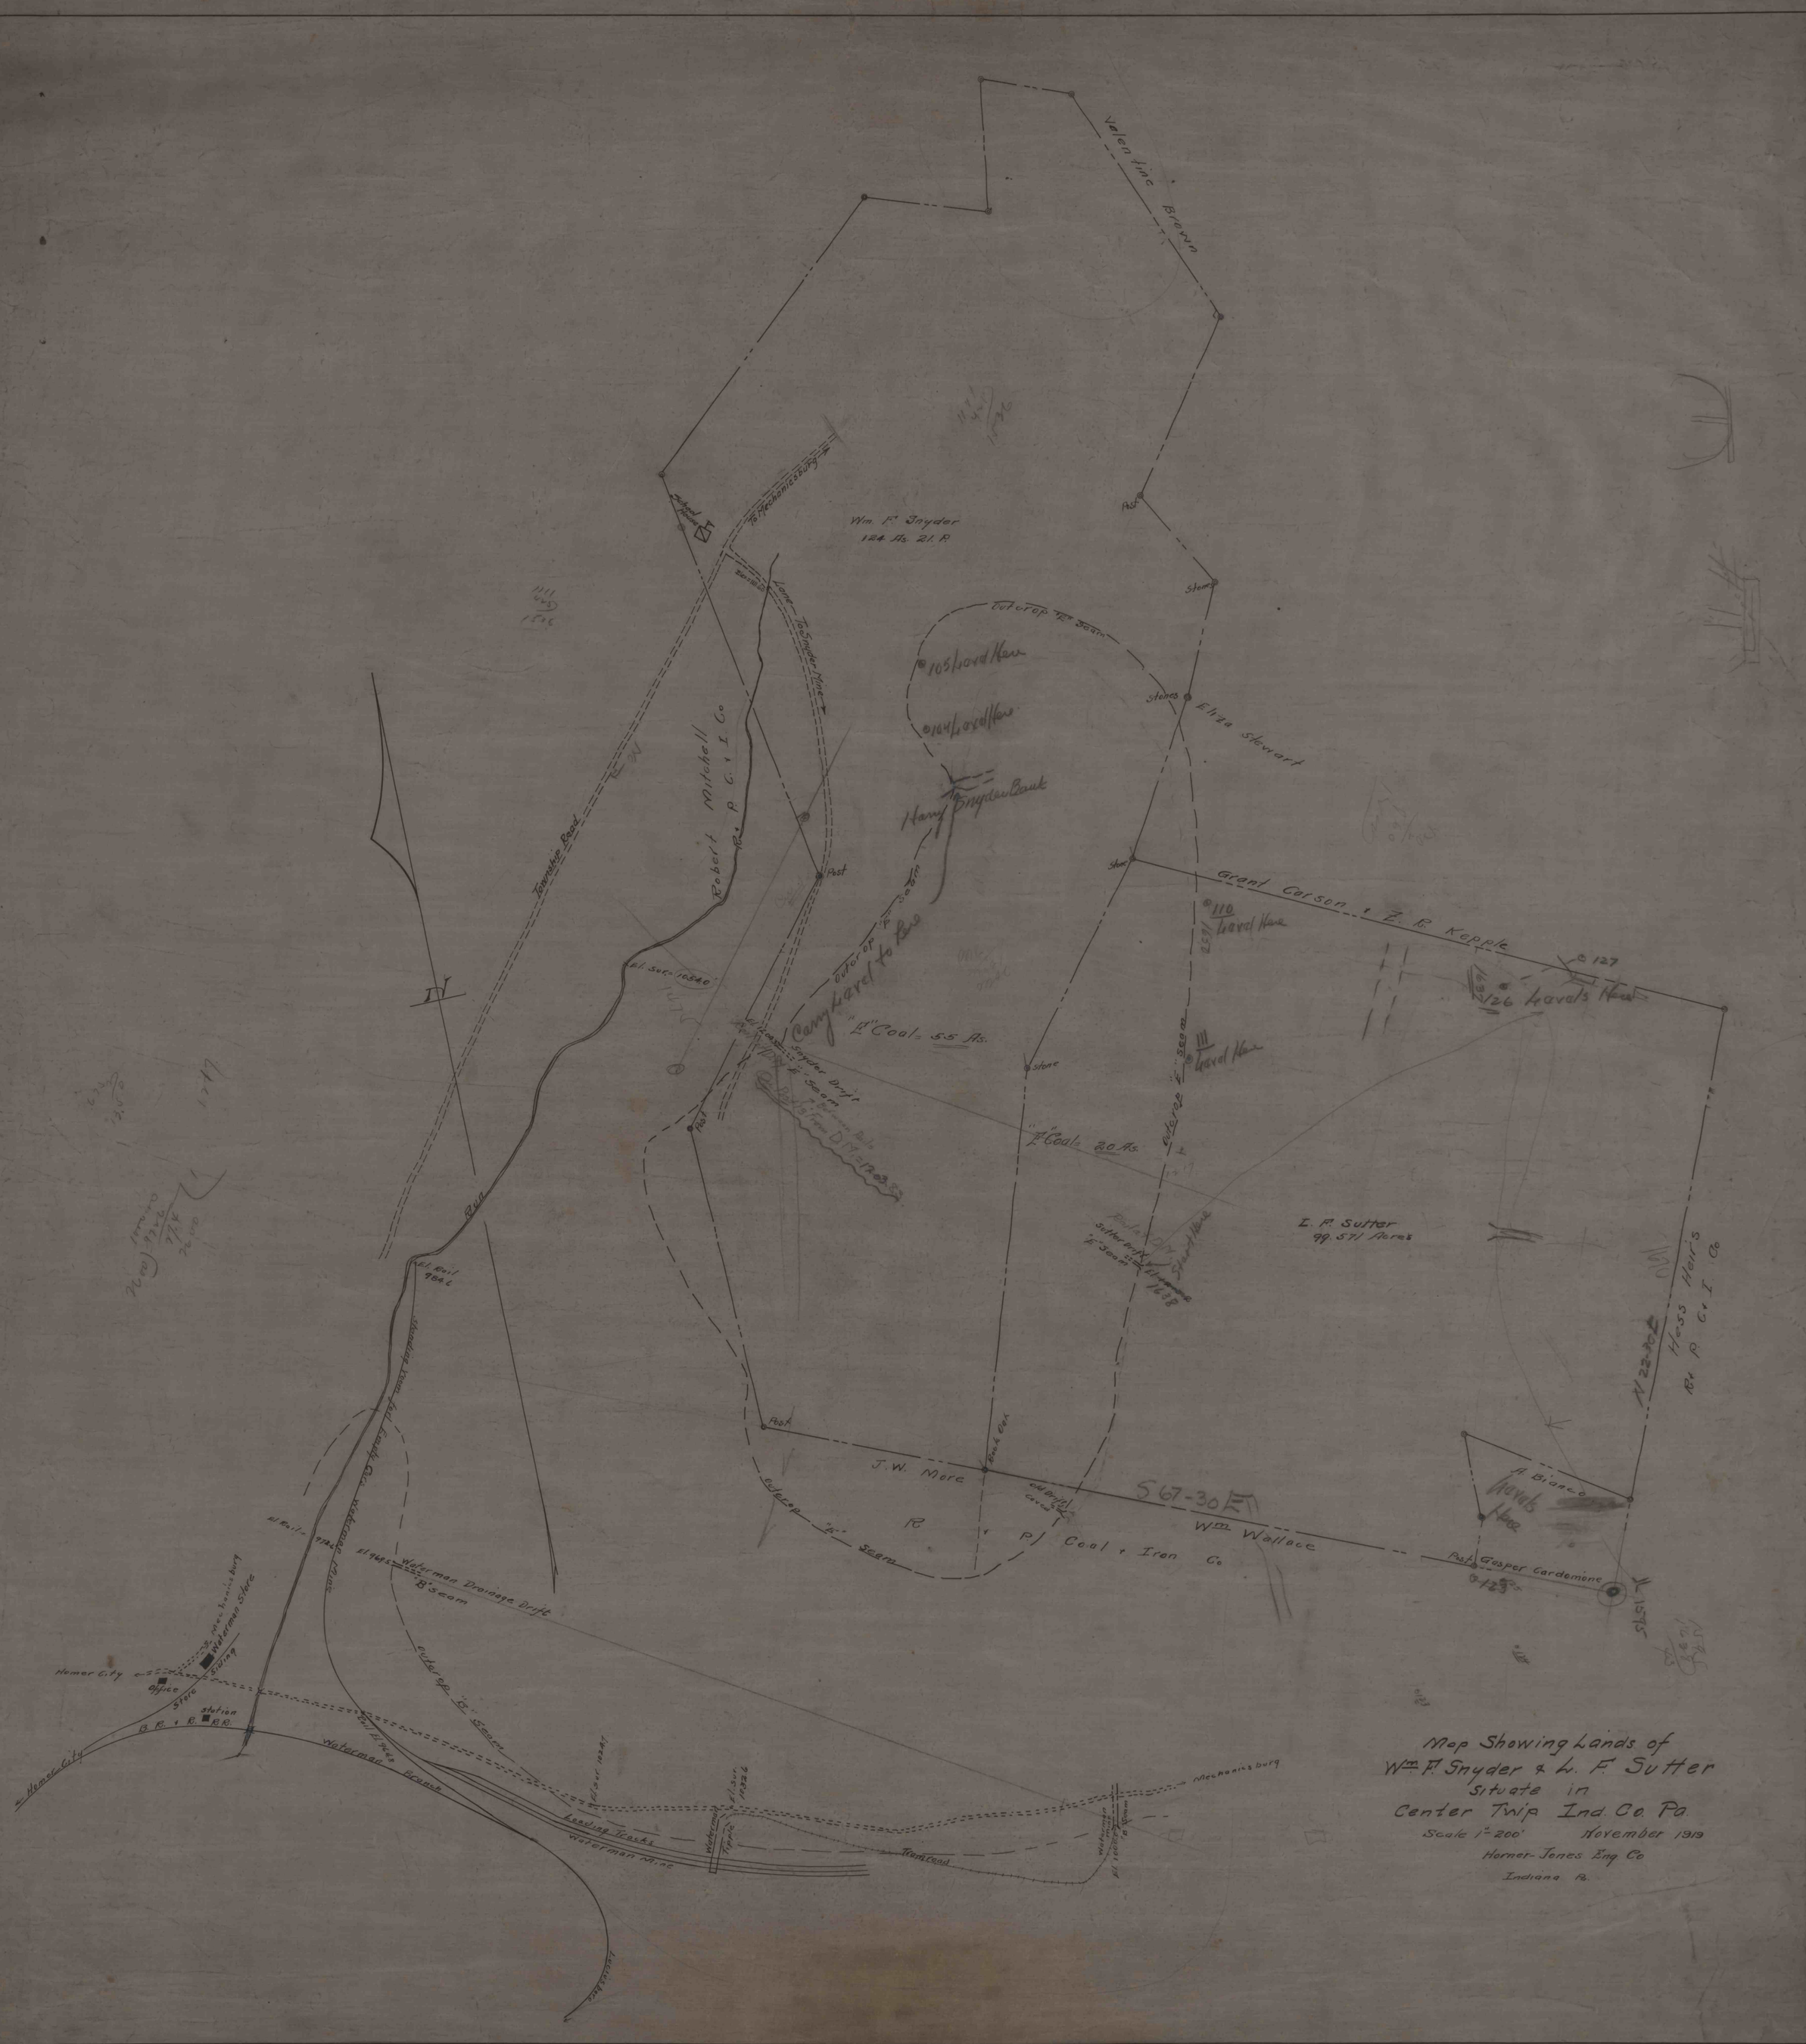

Map Showing Lands of
Wm. F. Snyder & L. F. Sutter
Situate in
Center Twp. Ind. Co. Pa.
Scale 1" = 200' November 1919
Horner-Jones Eng. Co
Indiana Pa.

IMAPS # 19409