


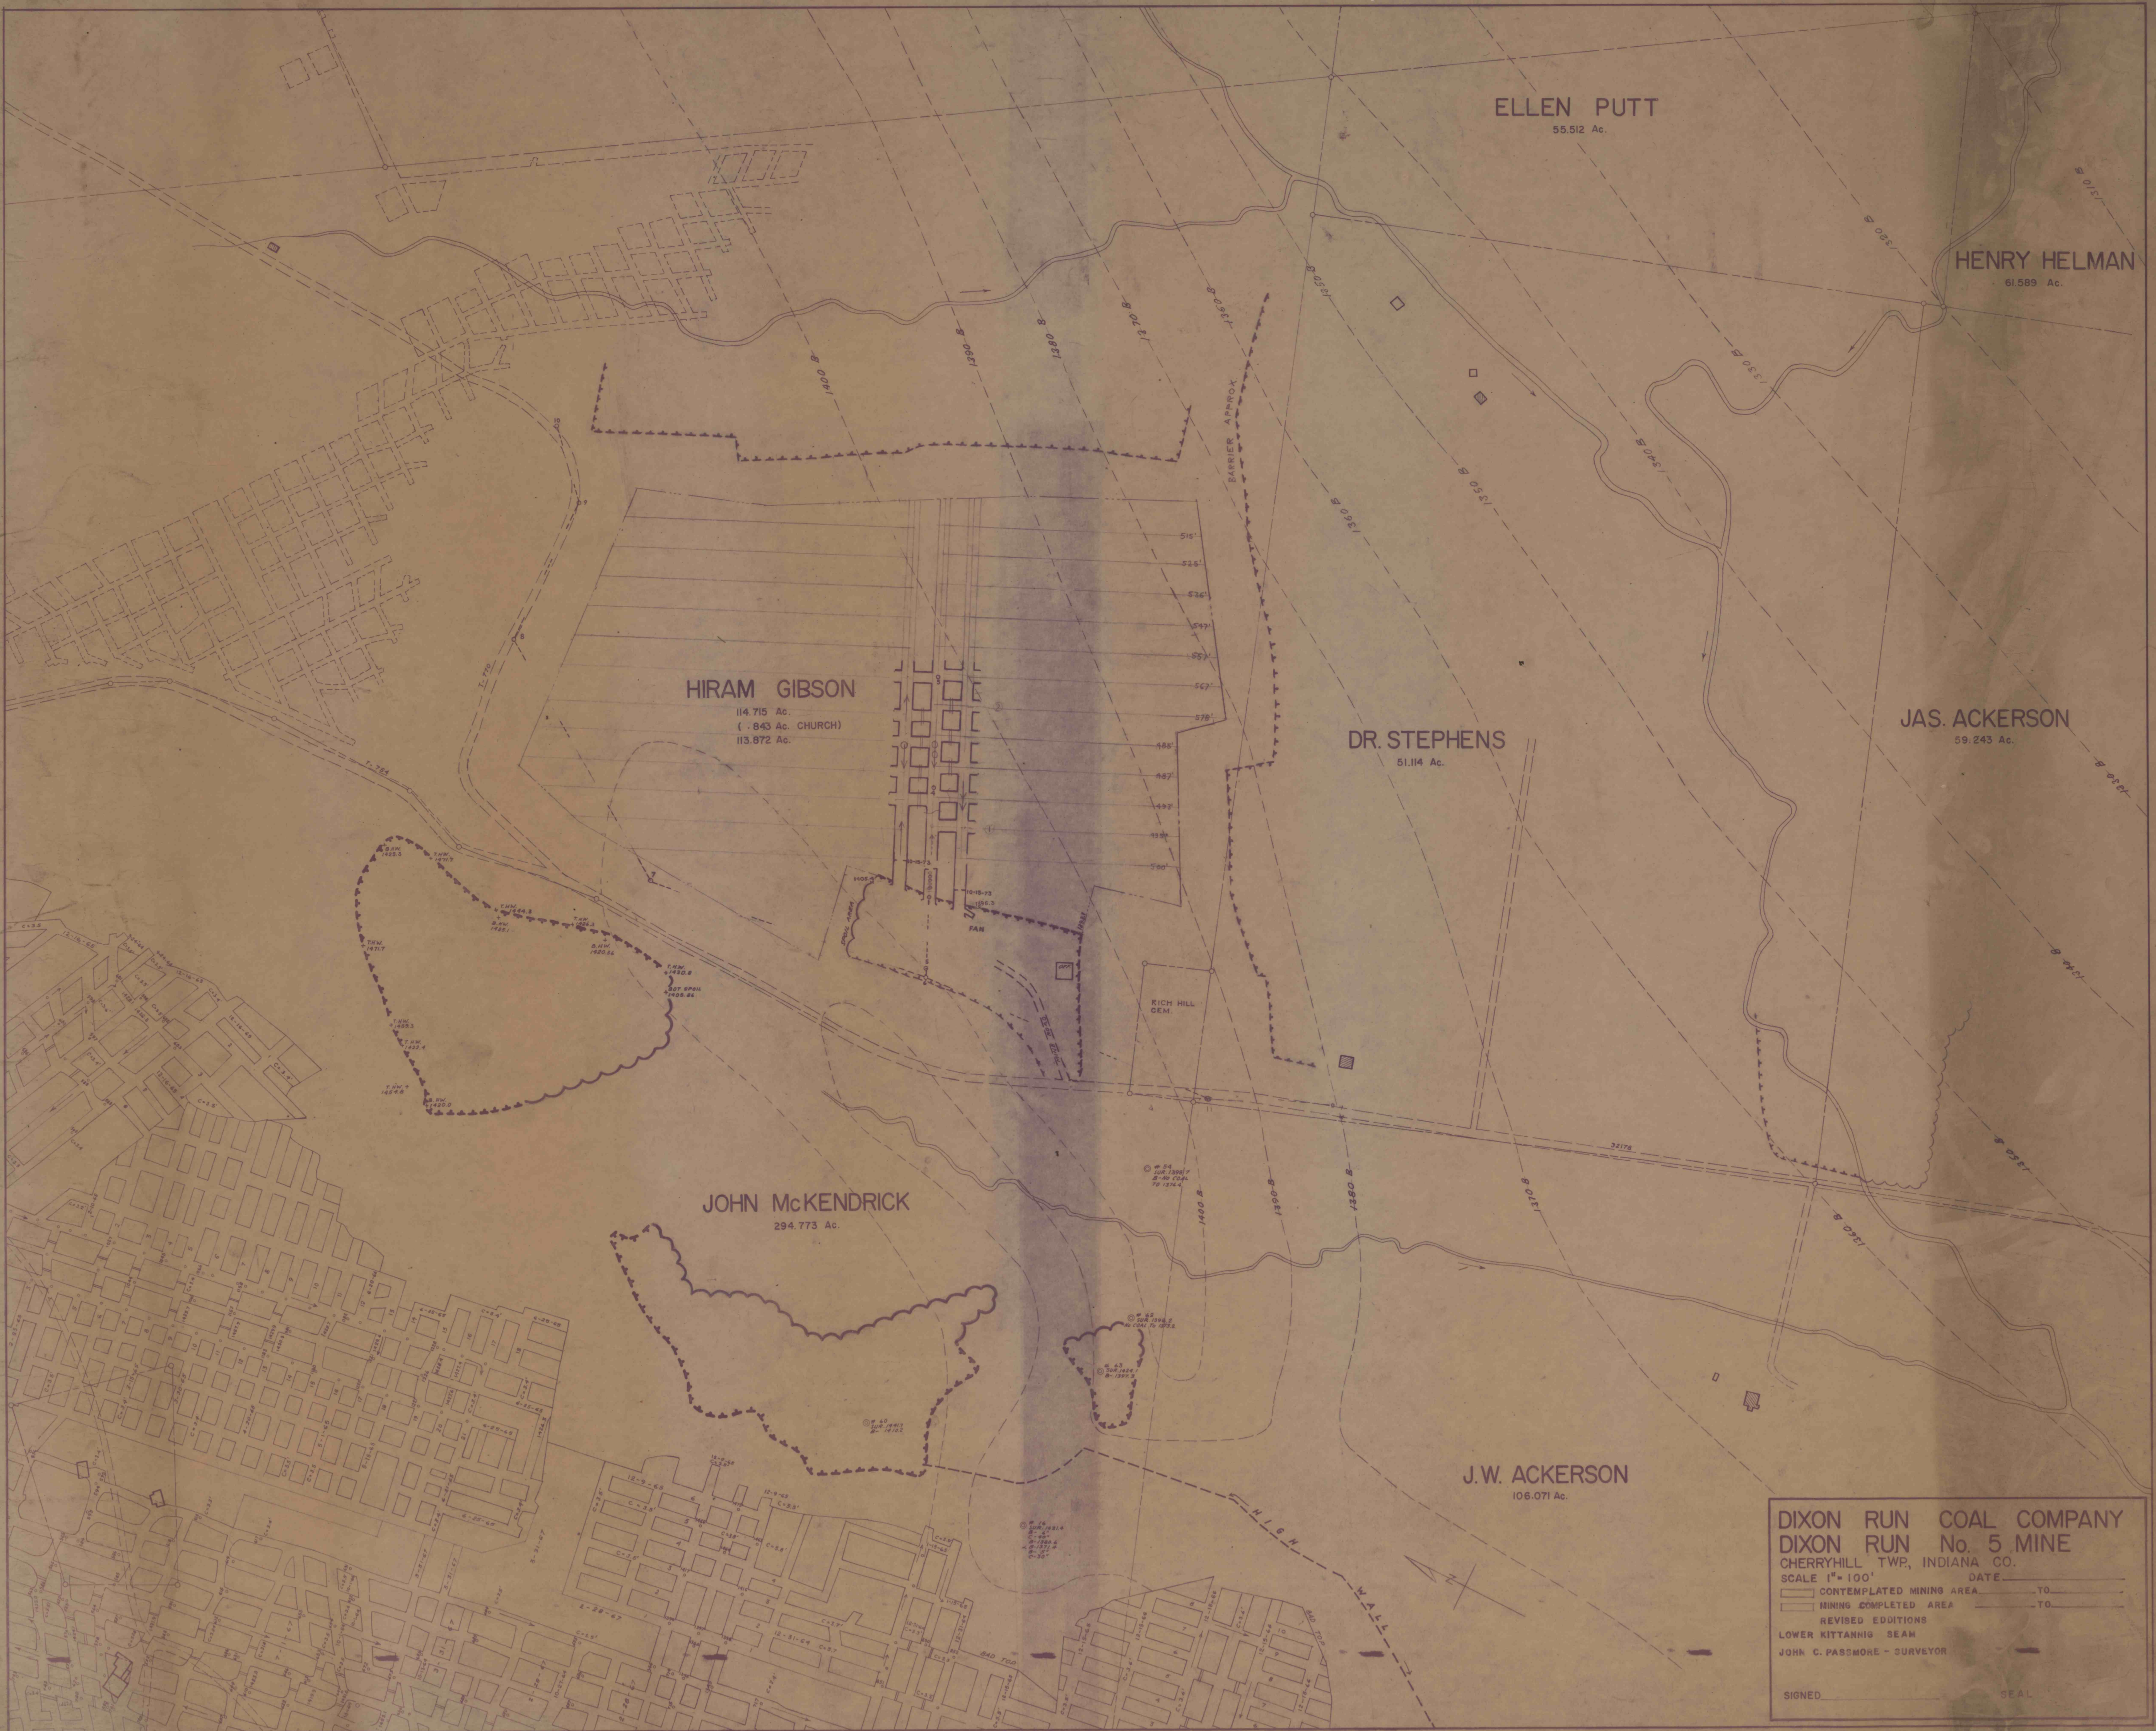

ELLEN PUTT
55.512 Ac.

HENRY HELMAN
61.589 Ac.

HIRAM GIBSON
114.715 Ac.
(.843 Ac. CHURCH)
113.972 Ac.

DR. STEPHENS
51.114 Ac.

JAS. ACKERSON
59.243 Ac.

JOHN McKENDRICK
294.773 Ac.

J.W. ACKERSON
106.071 Ac.

DIXON RUN COAL COMPANY
DIXON RUN No. 5 MINE
CHERRY HILL TWP, INDIANA CO.
SCALE 1"=100' DATE _____
CONTEMPLATED MINING AREA _____
MINING COMPLETED AREA _____
REVISED EDITIONS
LOWER KITTANNIS SEAM
JOHN C. PASMORE - SURVEYOR
SIGNED _____ SEAL _____