




PERMIT No. 02931301
ISSUED 6-29-93



ORIGINAL MAPPING PREPARED FOR
LTV STEEL COMPANY, PENN HILLS
ENERGY AND OTHERS. KILLAM DOES
NOT ATTEST TO THE VERACITY OF
THE INFORMATION DEPICTED BY THE
PREVIOUS OPERATORS.

Ex. 19.3: SUBSIDENCE CONTROL PLAN MAP.
Plum Creek Mining Co.
NEWFIELD MINE
Upper Freeport Coal Seam
PLUM BOROUGH, PENN HILLS TWP.,
ALLEGHENY CO., PA.

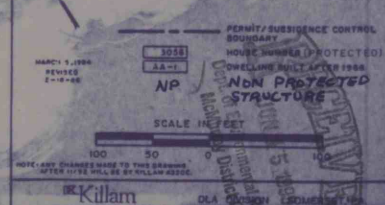

SHEET NO. 79