


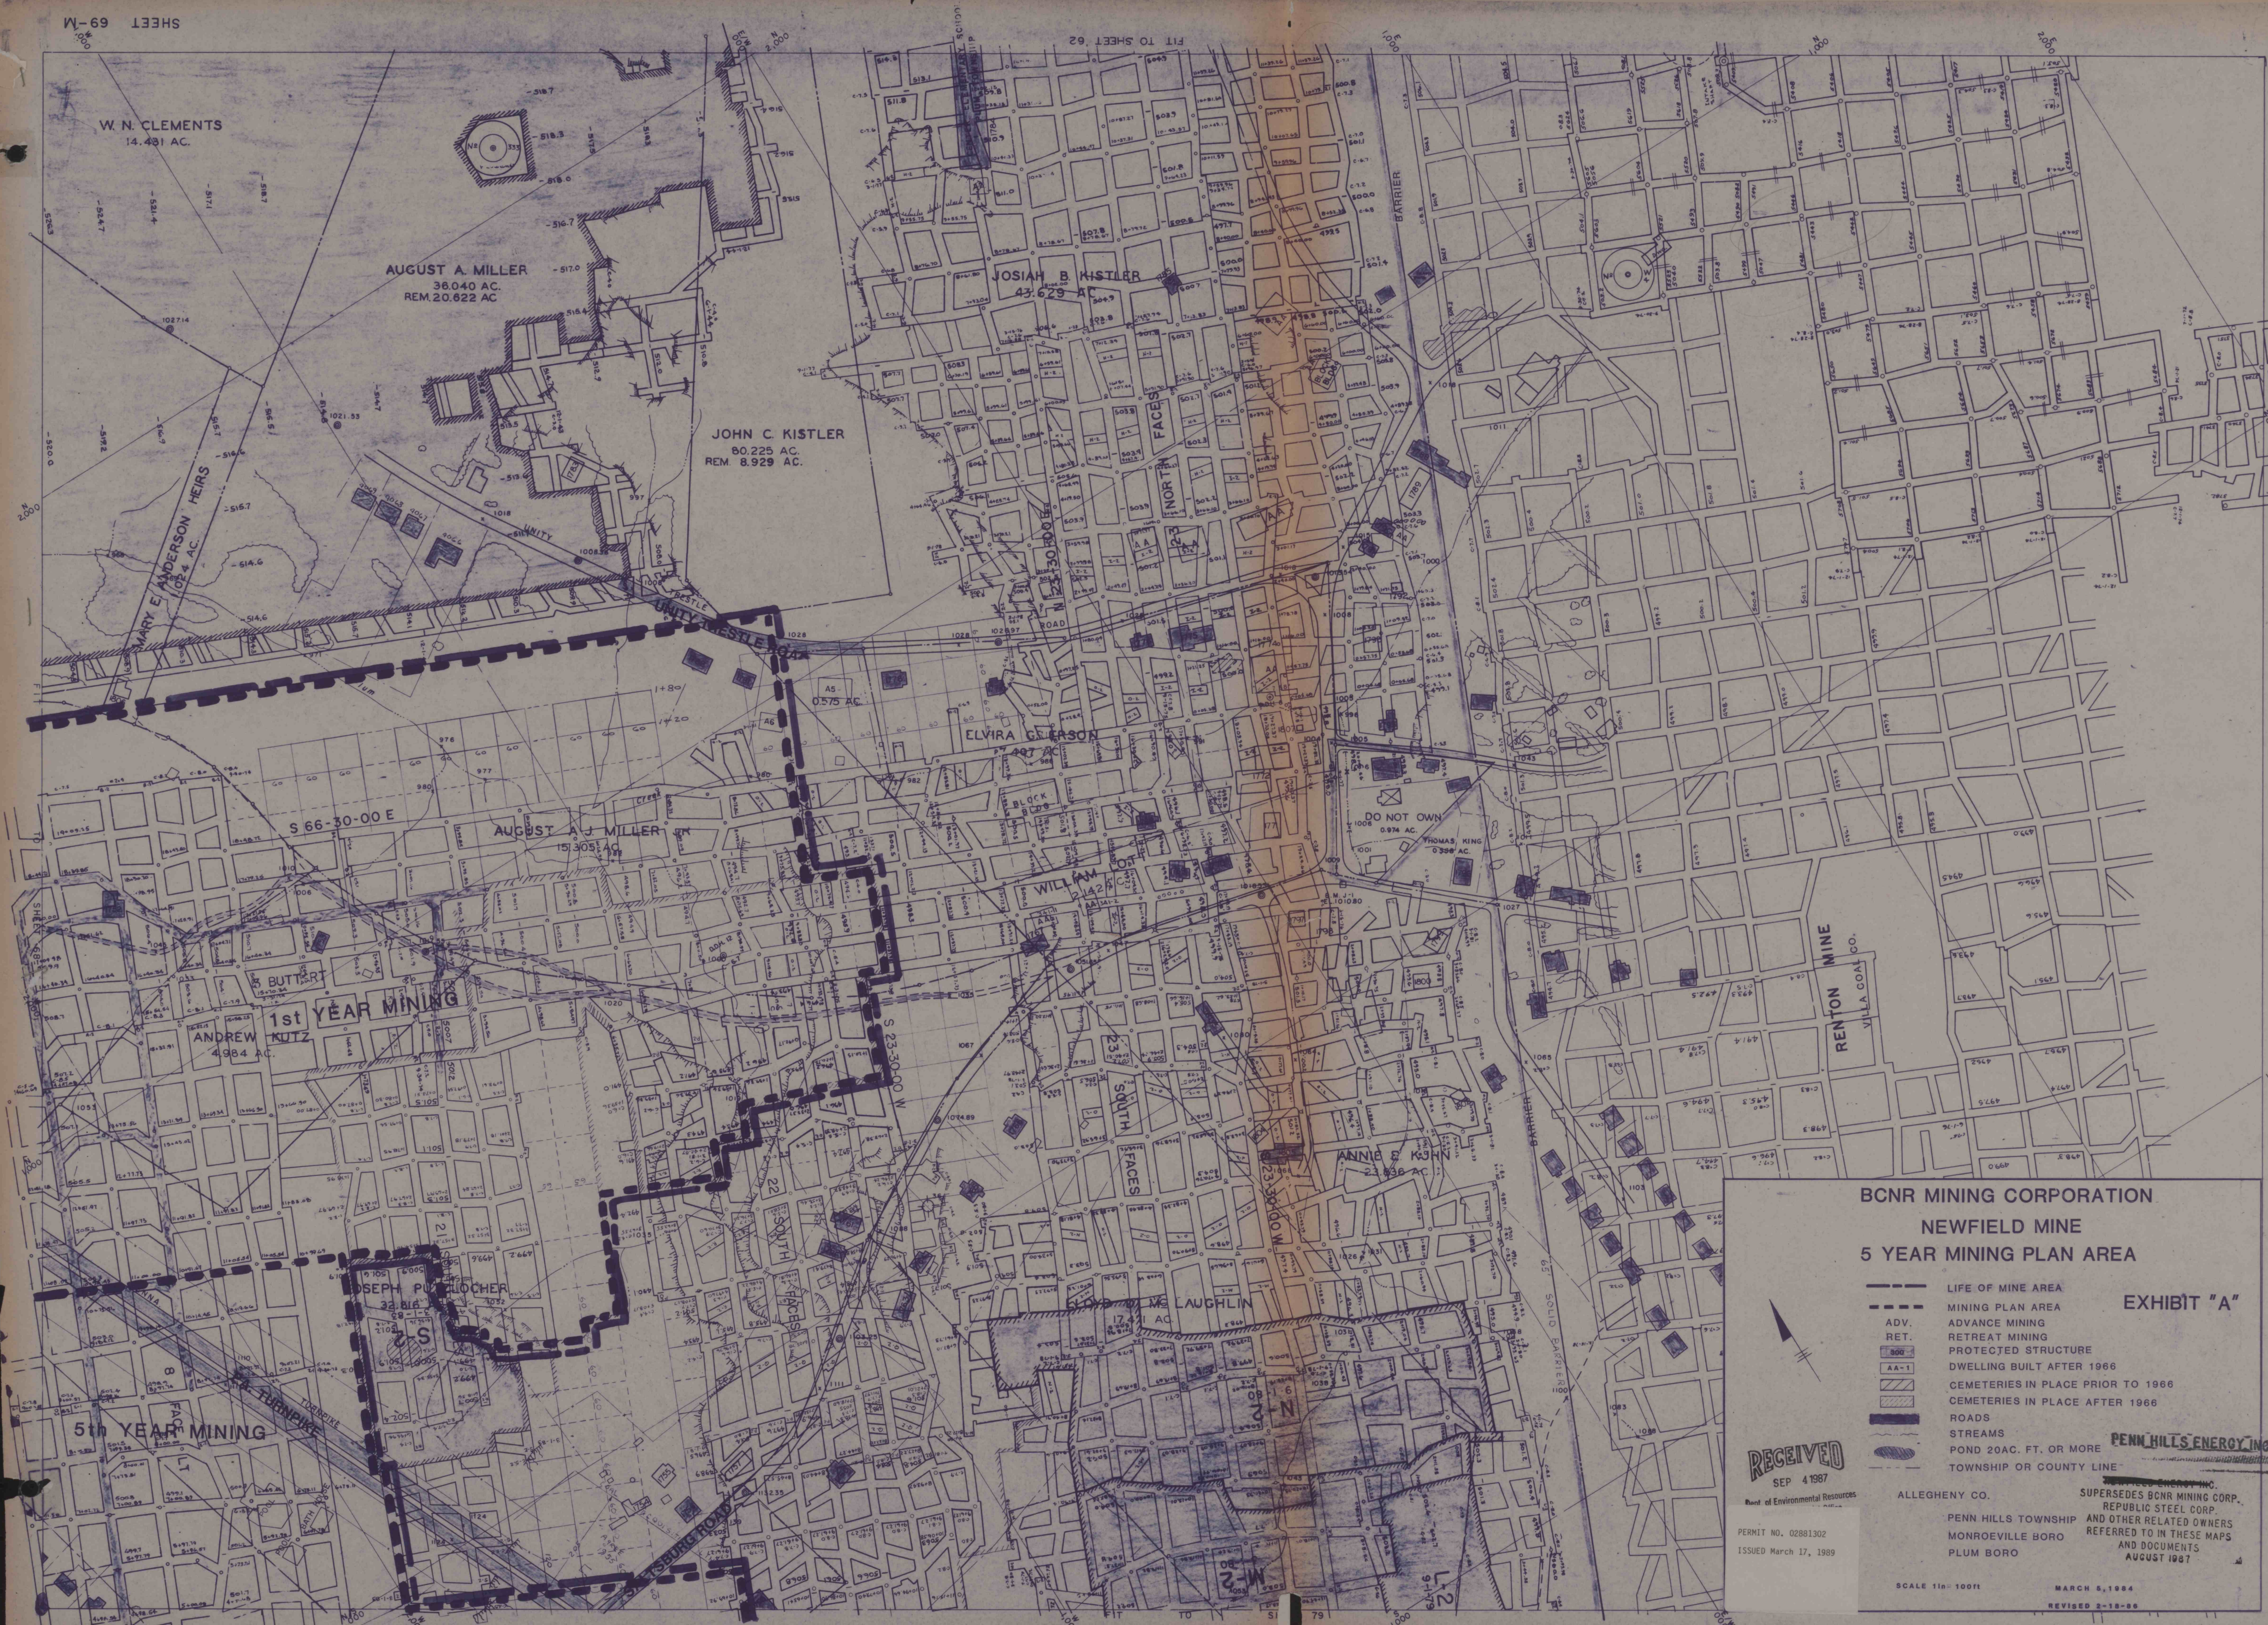

BCNR MINING CORPORATION
NEWFIELD MINE
5 YEAR MINING PLAN AREA

EXHIBIT "A"

- LIFE OF MINE AREA
- ADV. MINING
- RET. MINING
- PROTECTED STRUCTURE
- DWELLING BUILT AFTER 1966
- CEMETERIES IN PLACE PRIOR TO 1966
- CEMETERIES IN PLACE AFTER 1966
- ROADS
- STREAMS
- POND 20AC. FT. OR MORE
- TOWNSHIP OR COUNTY LINE

RECEIVED
SEP 4 1987
Bureau of Environmental Resources

PERMIT NO. 02881302
ISSUED March 17, 1989

ALLEGHENY CO.
PENN HILLS TOWNSHIP
MONROEVILLE BORO
PLUM BORO

SUPERSEDES BCNR MINING CORP.
REPUBLIC STEEL CORP.
AND OTHER RELATED OWNERS
REFERRED TO IN THESE MAPS
AND DOCUMENTS
AUGUST 1987

SCALE 1"=100'
MARCH 6, 1984
REVISED 2-18-88