


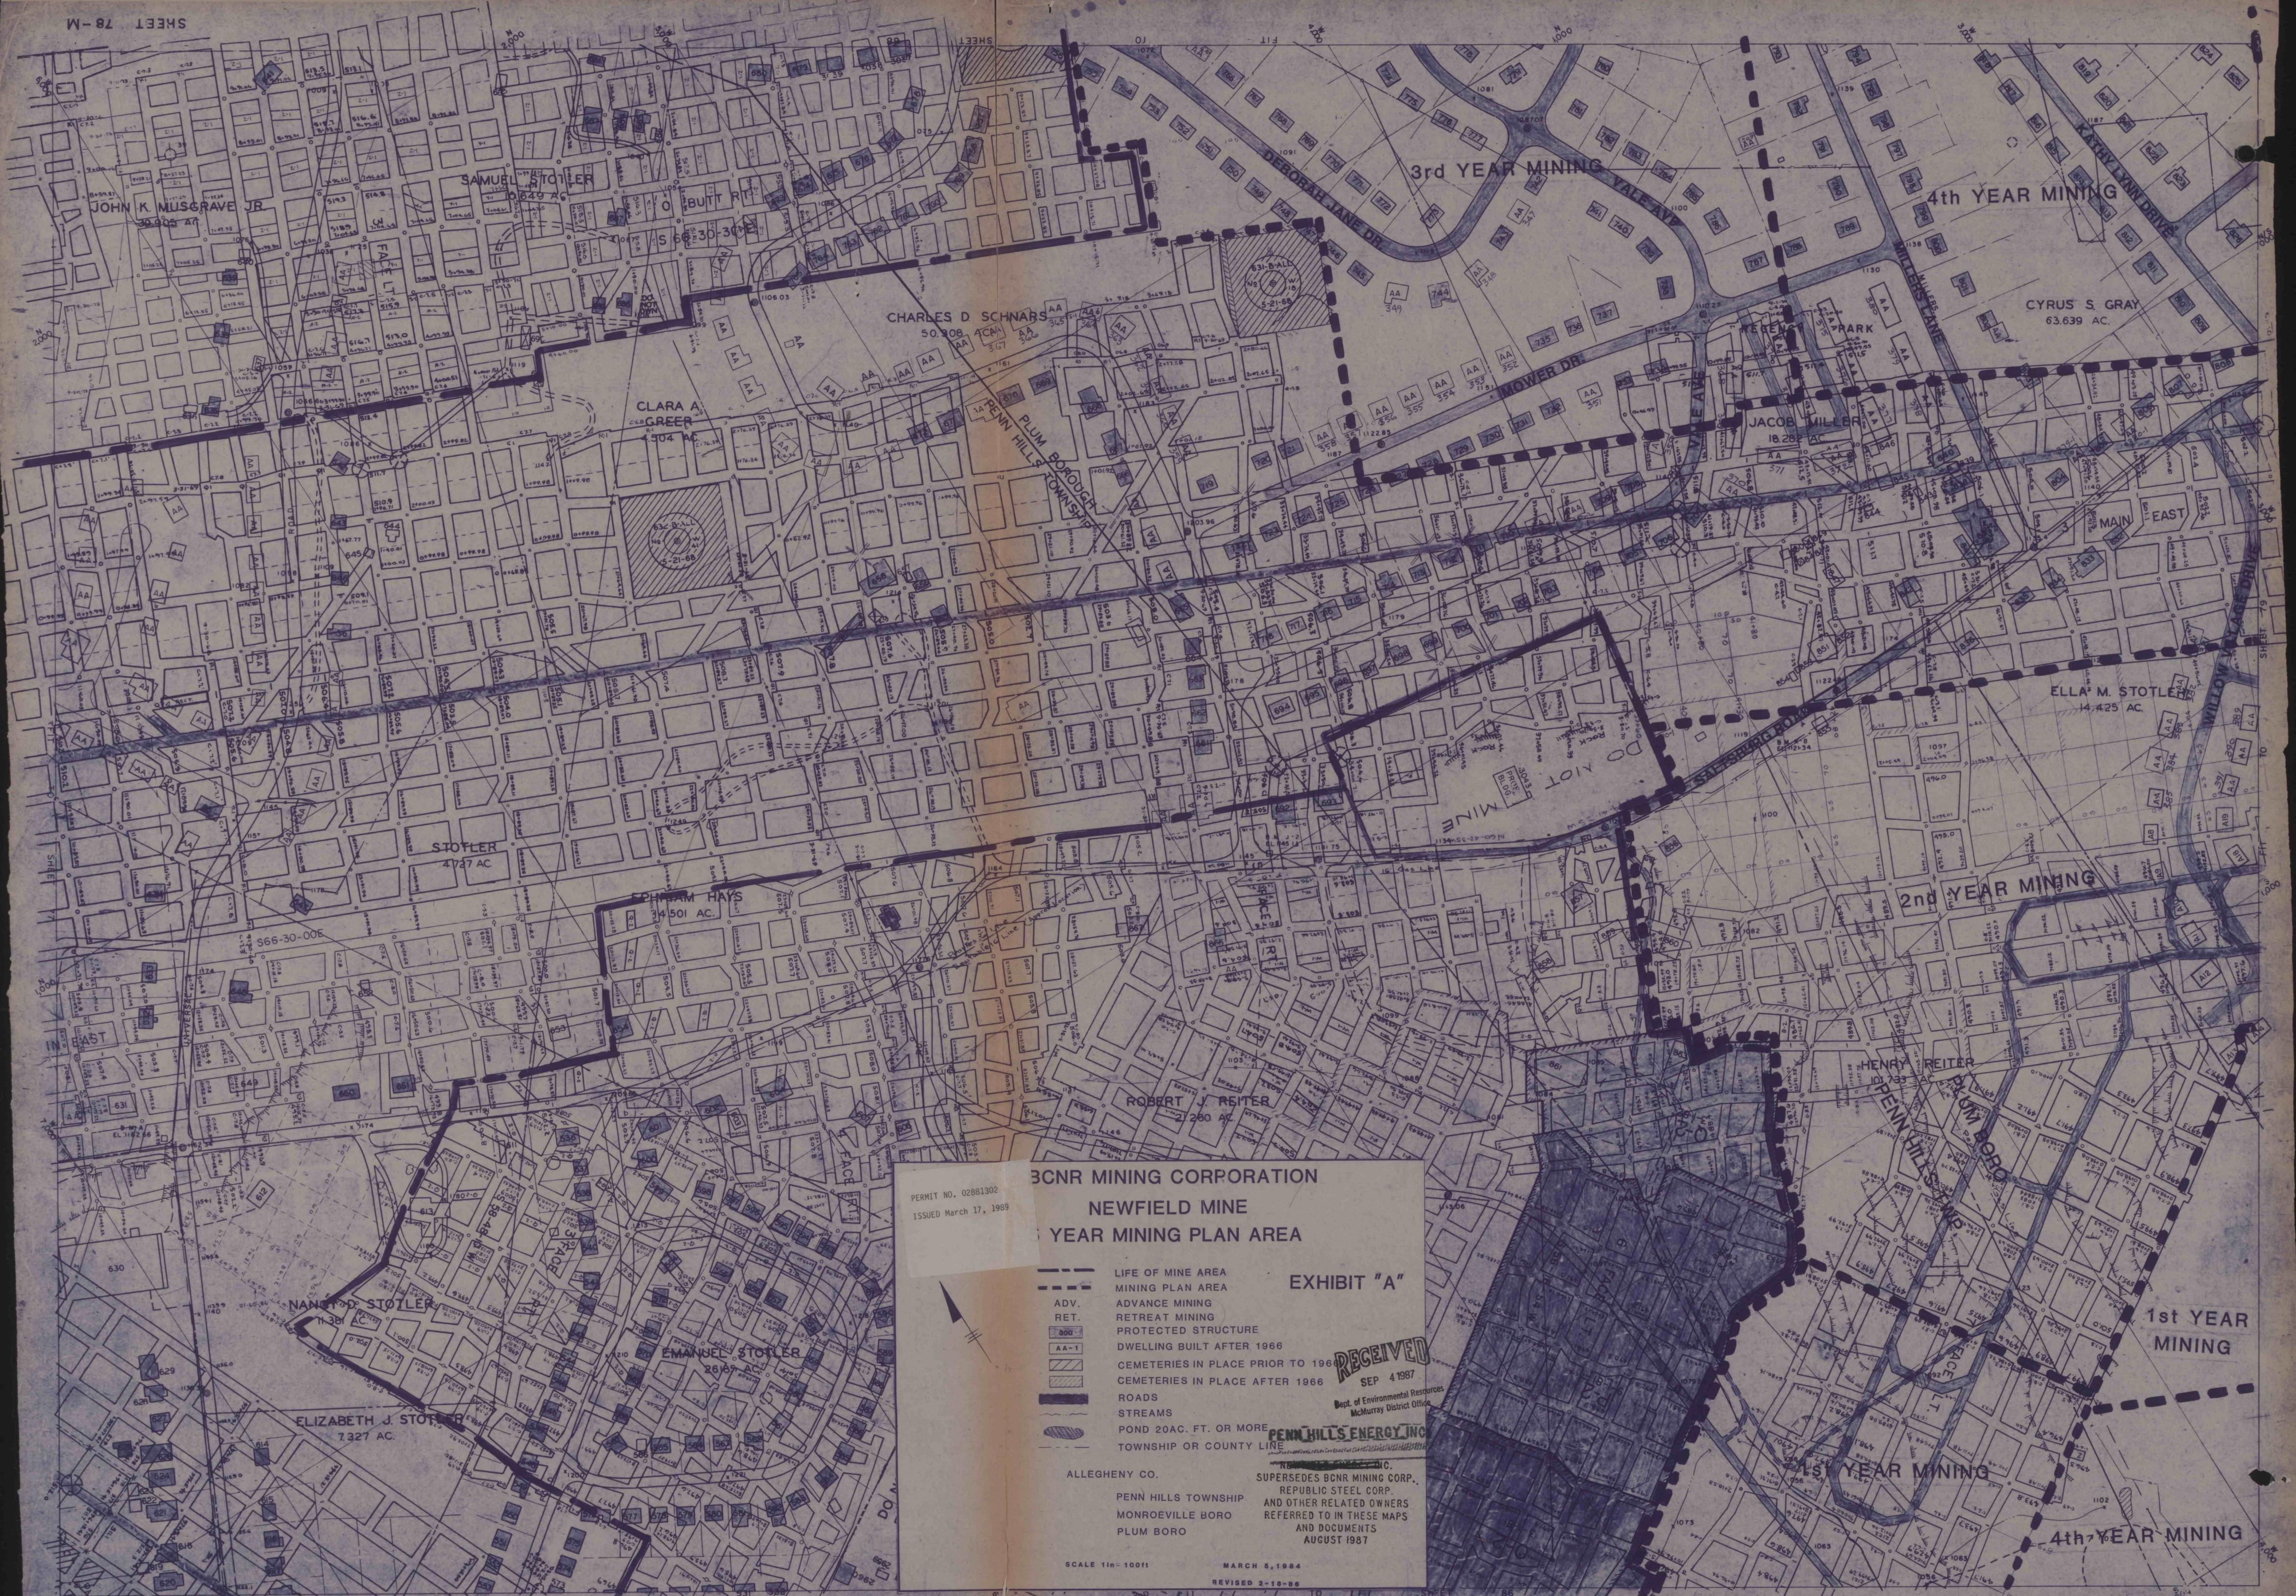

PERMIT NO. 02881302
ISSUED March 17, 1989

BCNR MINING CORPORATION
NEWFIELD MINE
YEAR MINING PLAN AREA

EXHIBIT "A"

- ADV.
- RET.
- AA-1
- DWELLING BUILT AFTER 1966
- CEMETERIES IN PLACE PRIOR TO 1966
- CEMETERIES IN PLACE AFTER 1966
- ROADS
- STREAMS
- POND 20AC. FT. OR MORE
- TOWNSHIP OR COUNTY LINE

RECEIVED
SEP 4 1987
Dept. of Environmental Resources

PENN HILLS ENERGY INC.
SUPERSEDES BCNR MINING CORP.,
REPUBLIC STEEL CORP.
AND OTHER RELATED OWNERS
REFERRED TO IN THESE MAPS
AND DOCUMENTS
AUGUST 1987

ALLEGHENY CO.
PENN HILLS TOWNSHIP
MONROEVILLE BORO
PLUM BORO

SCALE 1in=100ft
MARCH 6, 1984
REVISED 2-18-88