


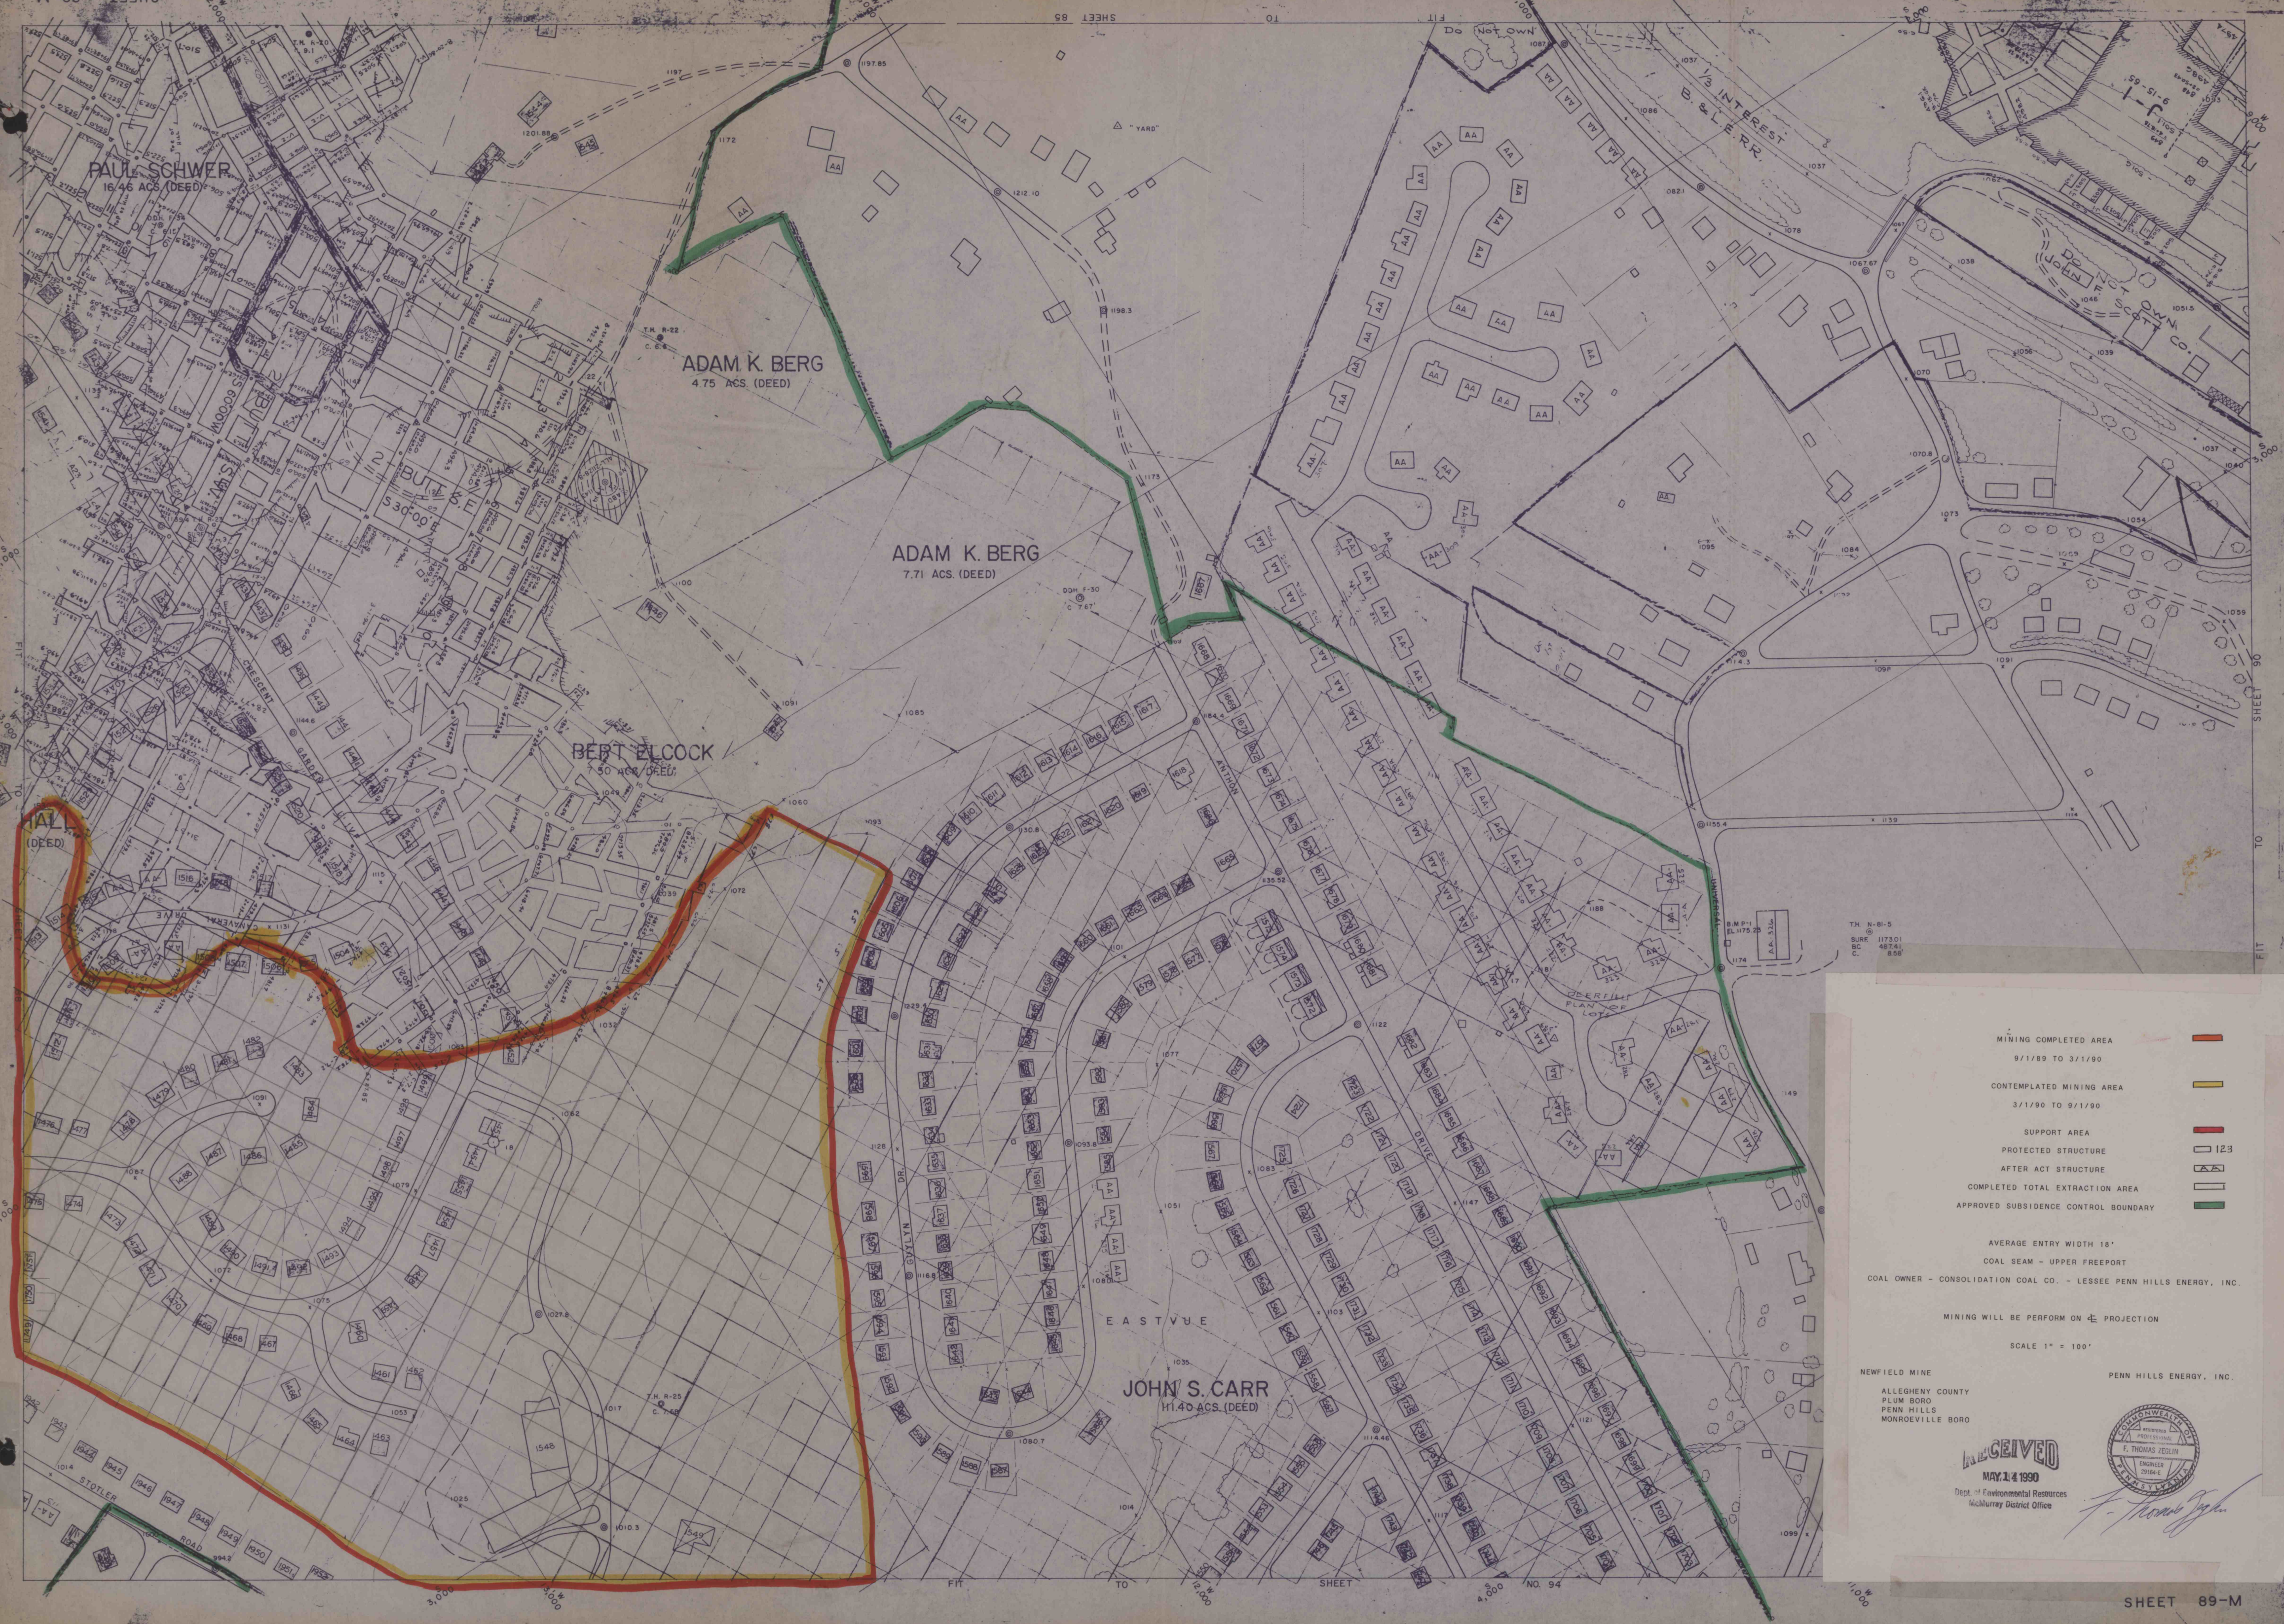

MINING COMPLETED AREA
9/1/89 TO 3/1/90

CONTEMPLATED MINING AREA
3/1/90 TO 9/1/90

SUPPORT AREA

PROTECTED STRUCTURE

AFTER ACT STRUCTURE

COMPLETED TOTAL EXTRACTION AREA

APPROVED SUBSIDENCE CONTROL BOUNDARY

AVERAGE ENTRY WIDTH 18'

COAL SEAM - UPPER FREEPORT

COAL OWNER - CONSOLIDATION COAL CO. - LESSEE PENN HILLS ENERGY, INC.

MINING WILL BE PERFORM ON ± PROJECTION

SCALE 1" = 100'

NEWFIELD MINE

ALLEGHENY COUNTY
PLUM BORO
PENN HILLS
MONROEVILLE BORO

PENN HILLS ENERGY, INC.

RECEIVED
MAY 14 1990
Dept. of Environmental Resources
McMurray District Office

F. Thomas Zedlin
ENGINEER
1984-4