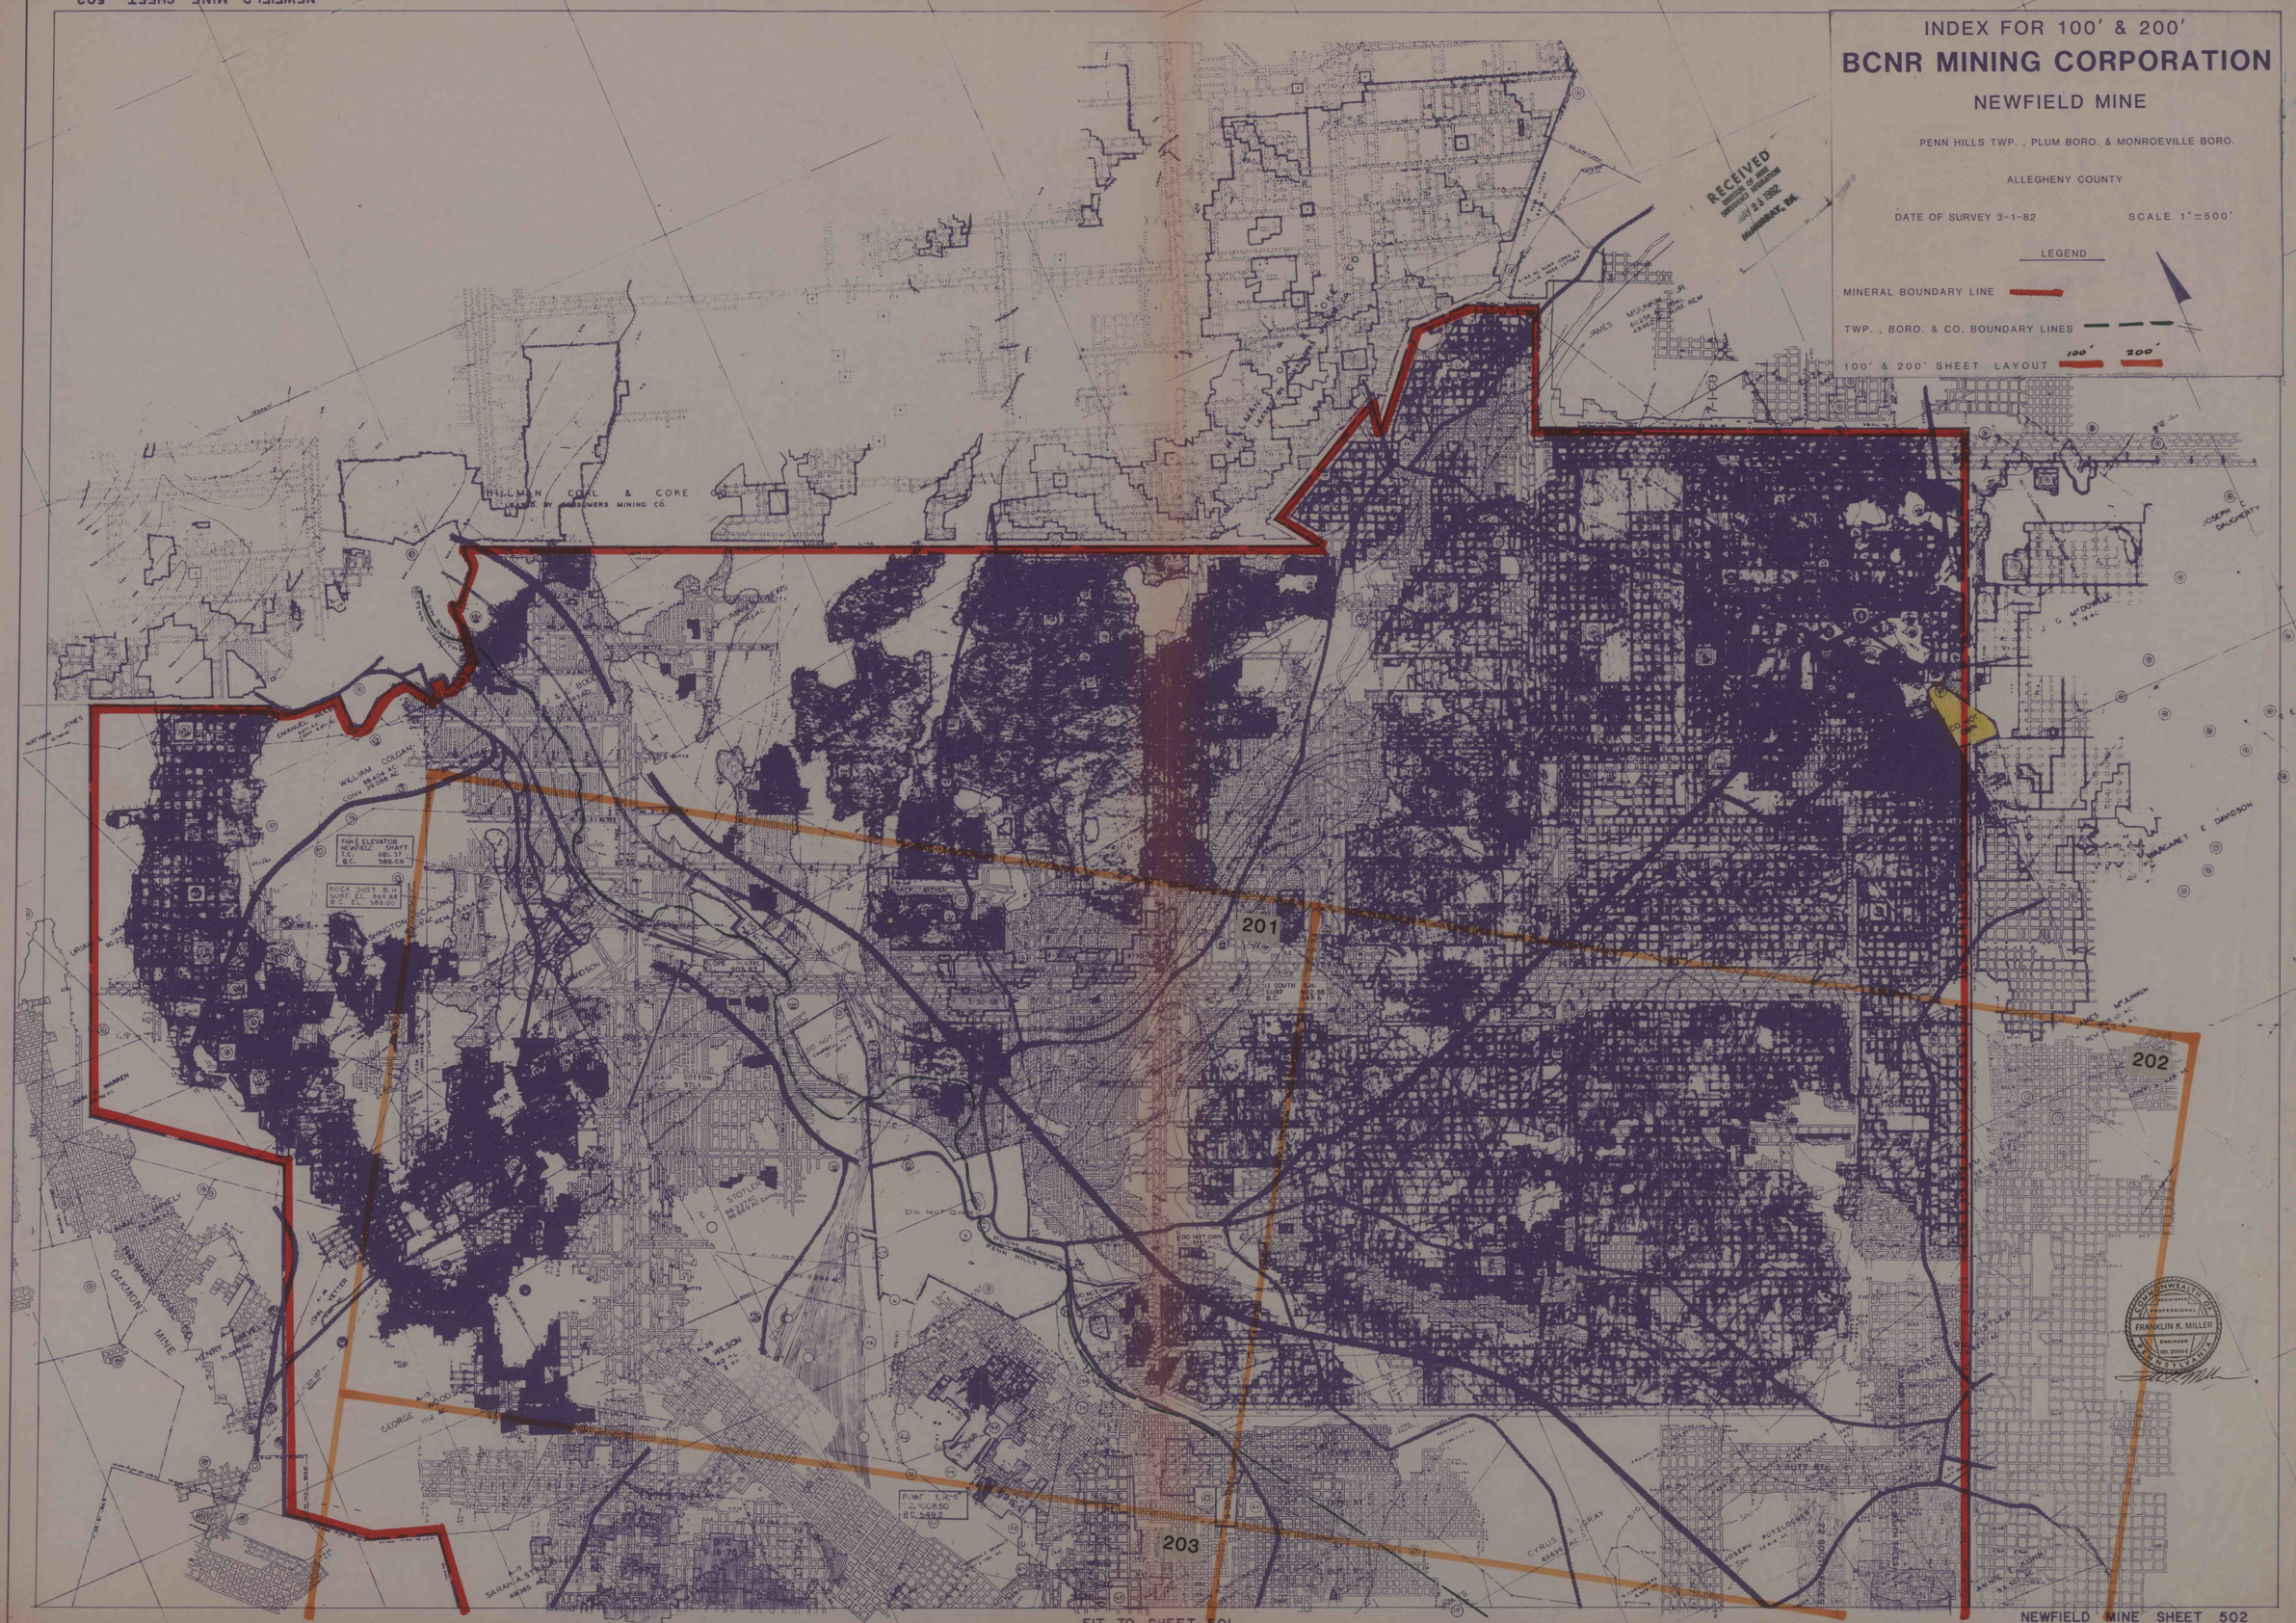
INDEX FOR 100' & 200'
BCNR MINING CORPORATION
NEWFIELD MINE
PENN HILLS TWP., PLUM BORO. & MONROEVILLE BORO.
ALLEGHENY COUNTY
DATE OF SURVEY 3-1-82
SCALE 1"=500'
LEGEND
MINERAL BOUNDARY LINE
TWP., BORO. & CO. BOUNDARY LINES
100' & 200' SHEET LAYOUT
100'
200'
RECEIVED
JUN 23 1982
McMURRAY, PA.
HILLMAN COAL & COKE CO.
LEASE BY PITTSBURGH MINING CO.
WILLIAM COLGAN
FAN & ELEVATOR
NEWFIELD SHAFT
ROCK DUST BIN
OAKMONT MINE
201
202
203
FIT TO SHEET 501
COMMONWEALTH OF PENNSYLVANIA
REGISTERED PROFESSIONAL ENGINEER
FRANKLIN K. MILLER
ENGINEER
NO. 25064