


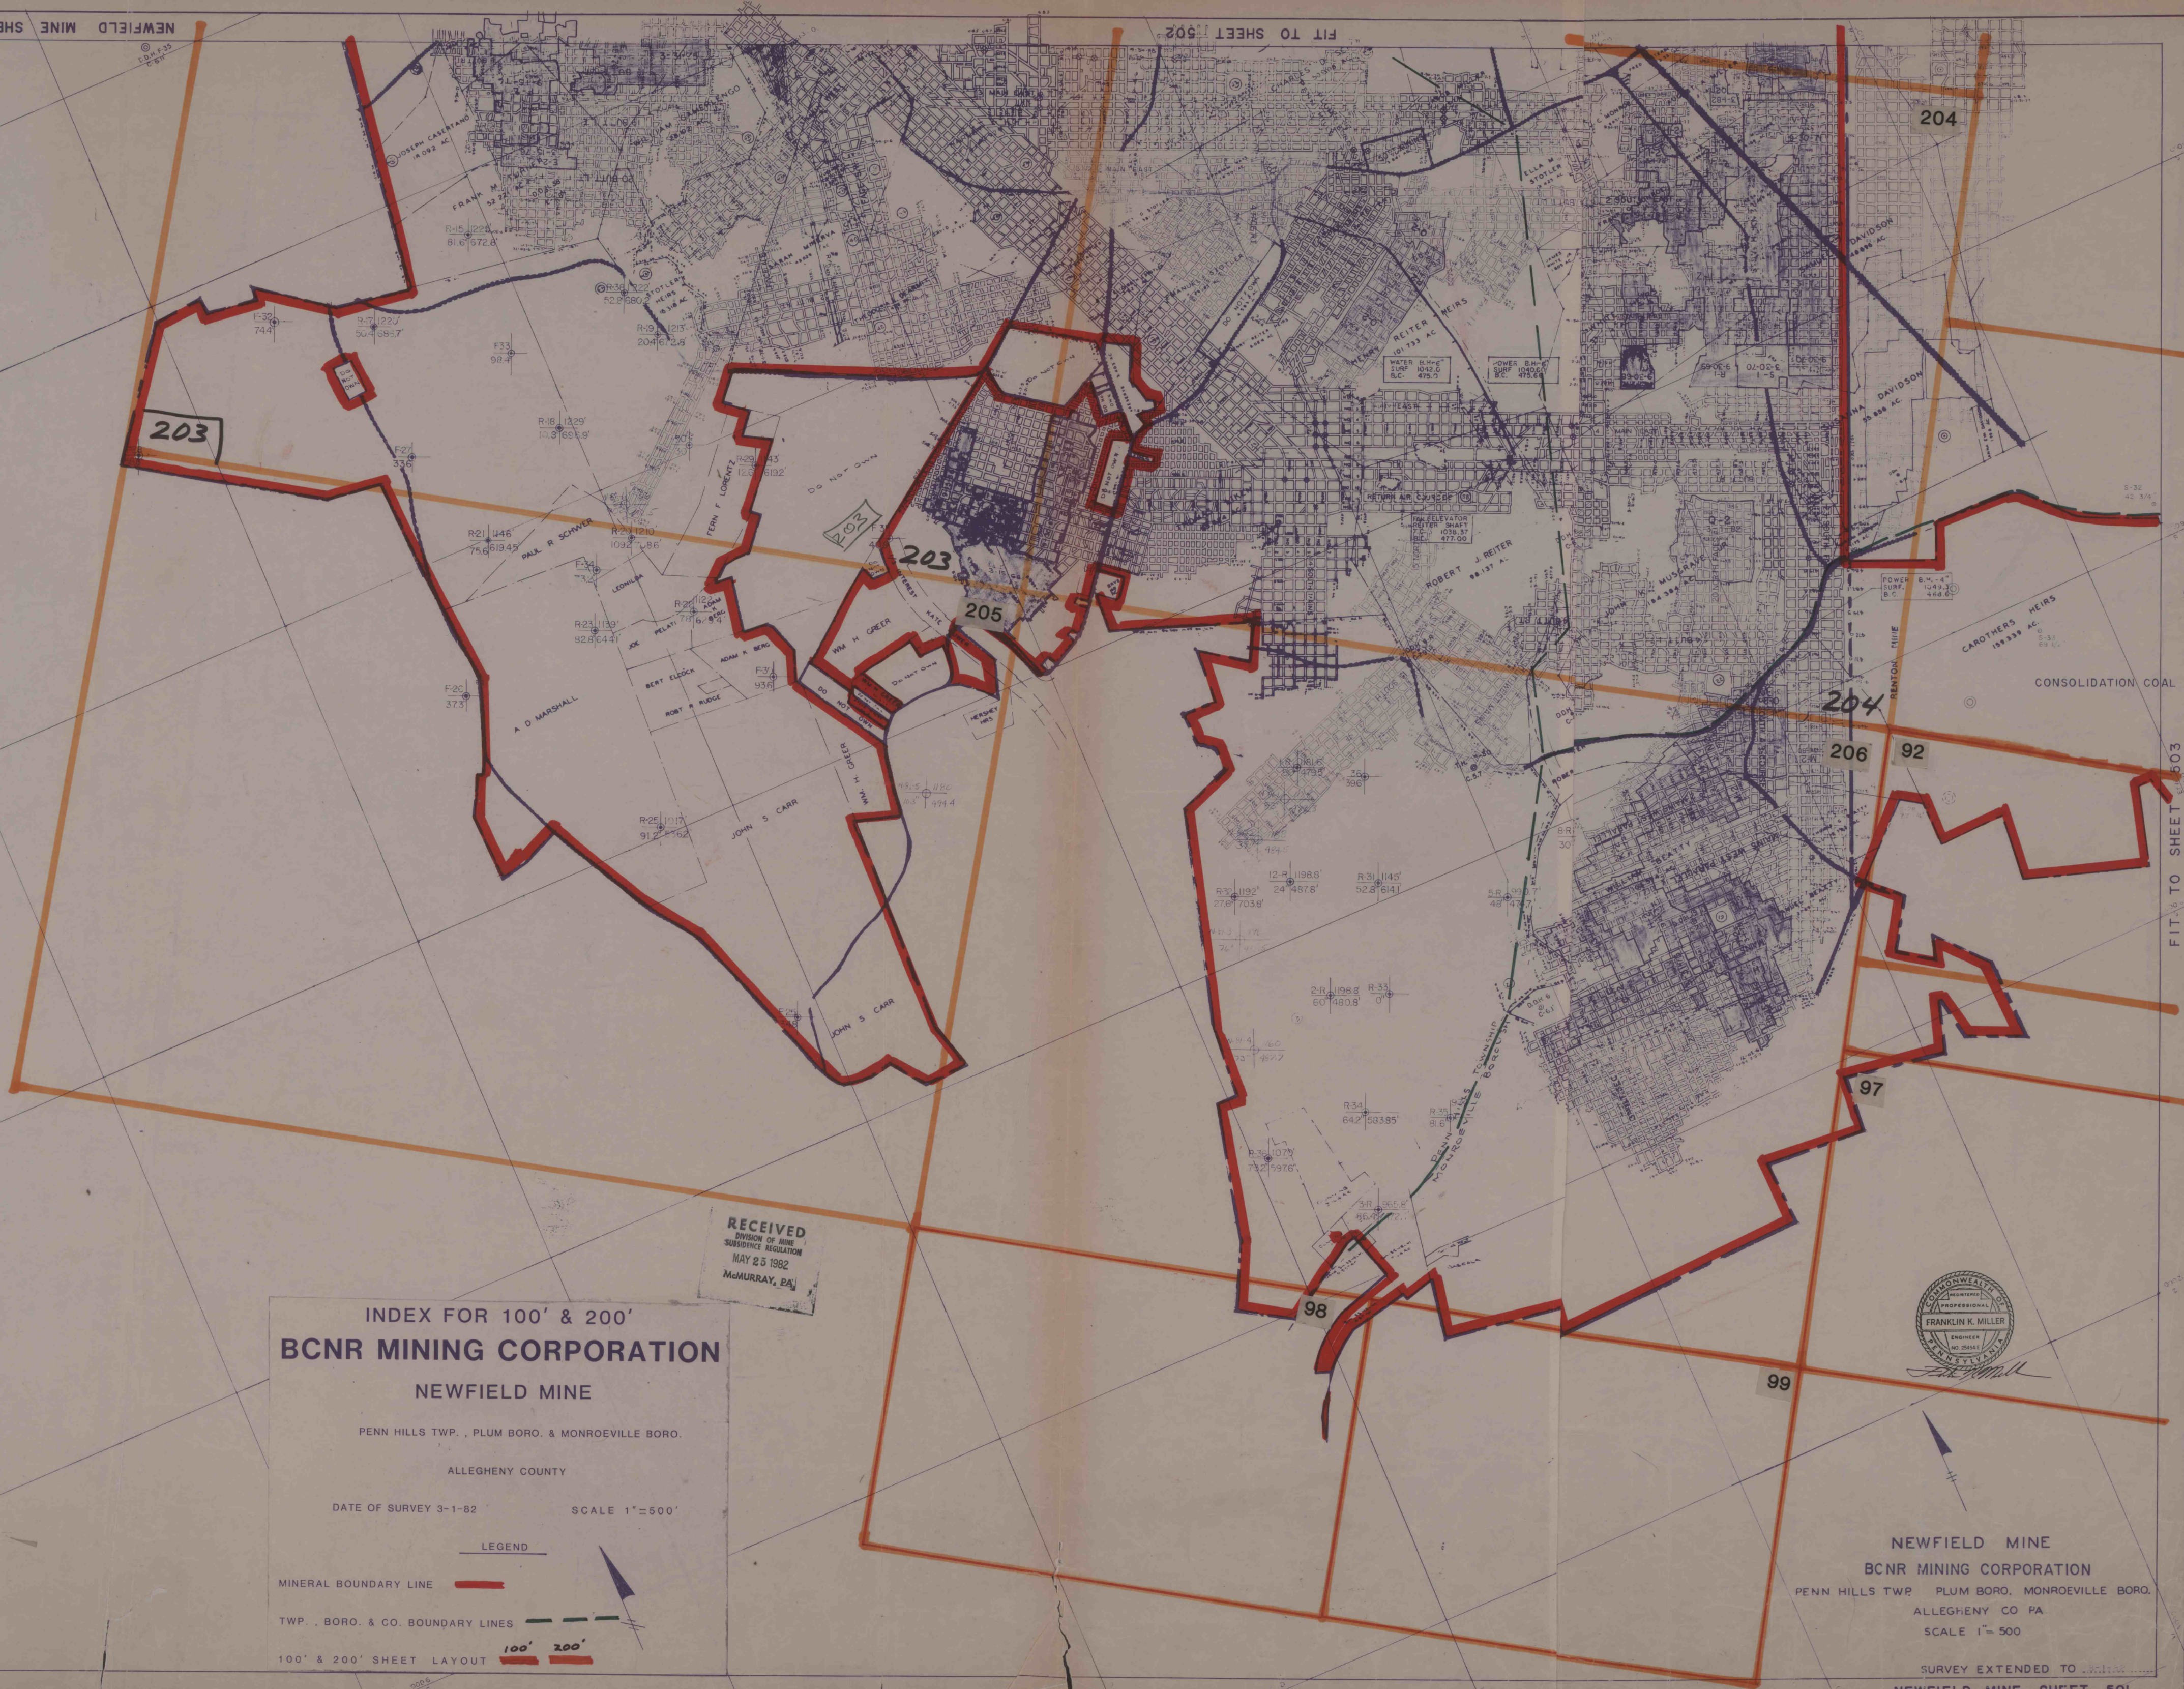

INDEX FOR 100' & 200'
BCNR MINING CORPORATION
NEWFIELD MINE

PENN HILLS TWP., PLUM BORO. & MONROEVILLE BORO.

ALLEGHENY COUNTY

DATE OF SURVEY 3-1-82


SCALE 1"=500'

LEGEND

MINERAL BOUNDARY LINE

TWP., BORO. & CO. BOUNDARY LINES

100' & 200' SHEET LAYOUT

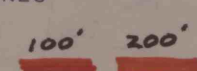

RECEIVED
DIVISION OF MINE
SUBSIDENCE REGULATION
MAY 23 1982
McMURRAY, PA.



NEWFIELD MINE
BCNR MINING CORPORATION
PENN HILLS TWP. PLUM BORO. MONROEVILLE BORO.
ALLEGHENY CO PA
SCALE 1"= 500'

SURVEY EXTENDED TO
NEWFIELD MINE SHEET 501