



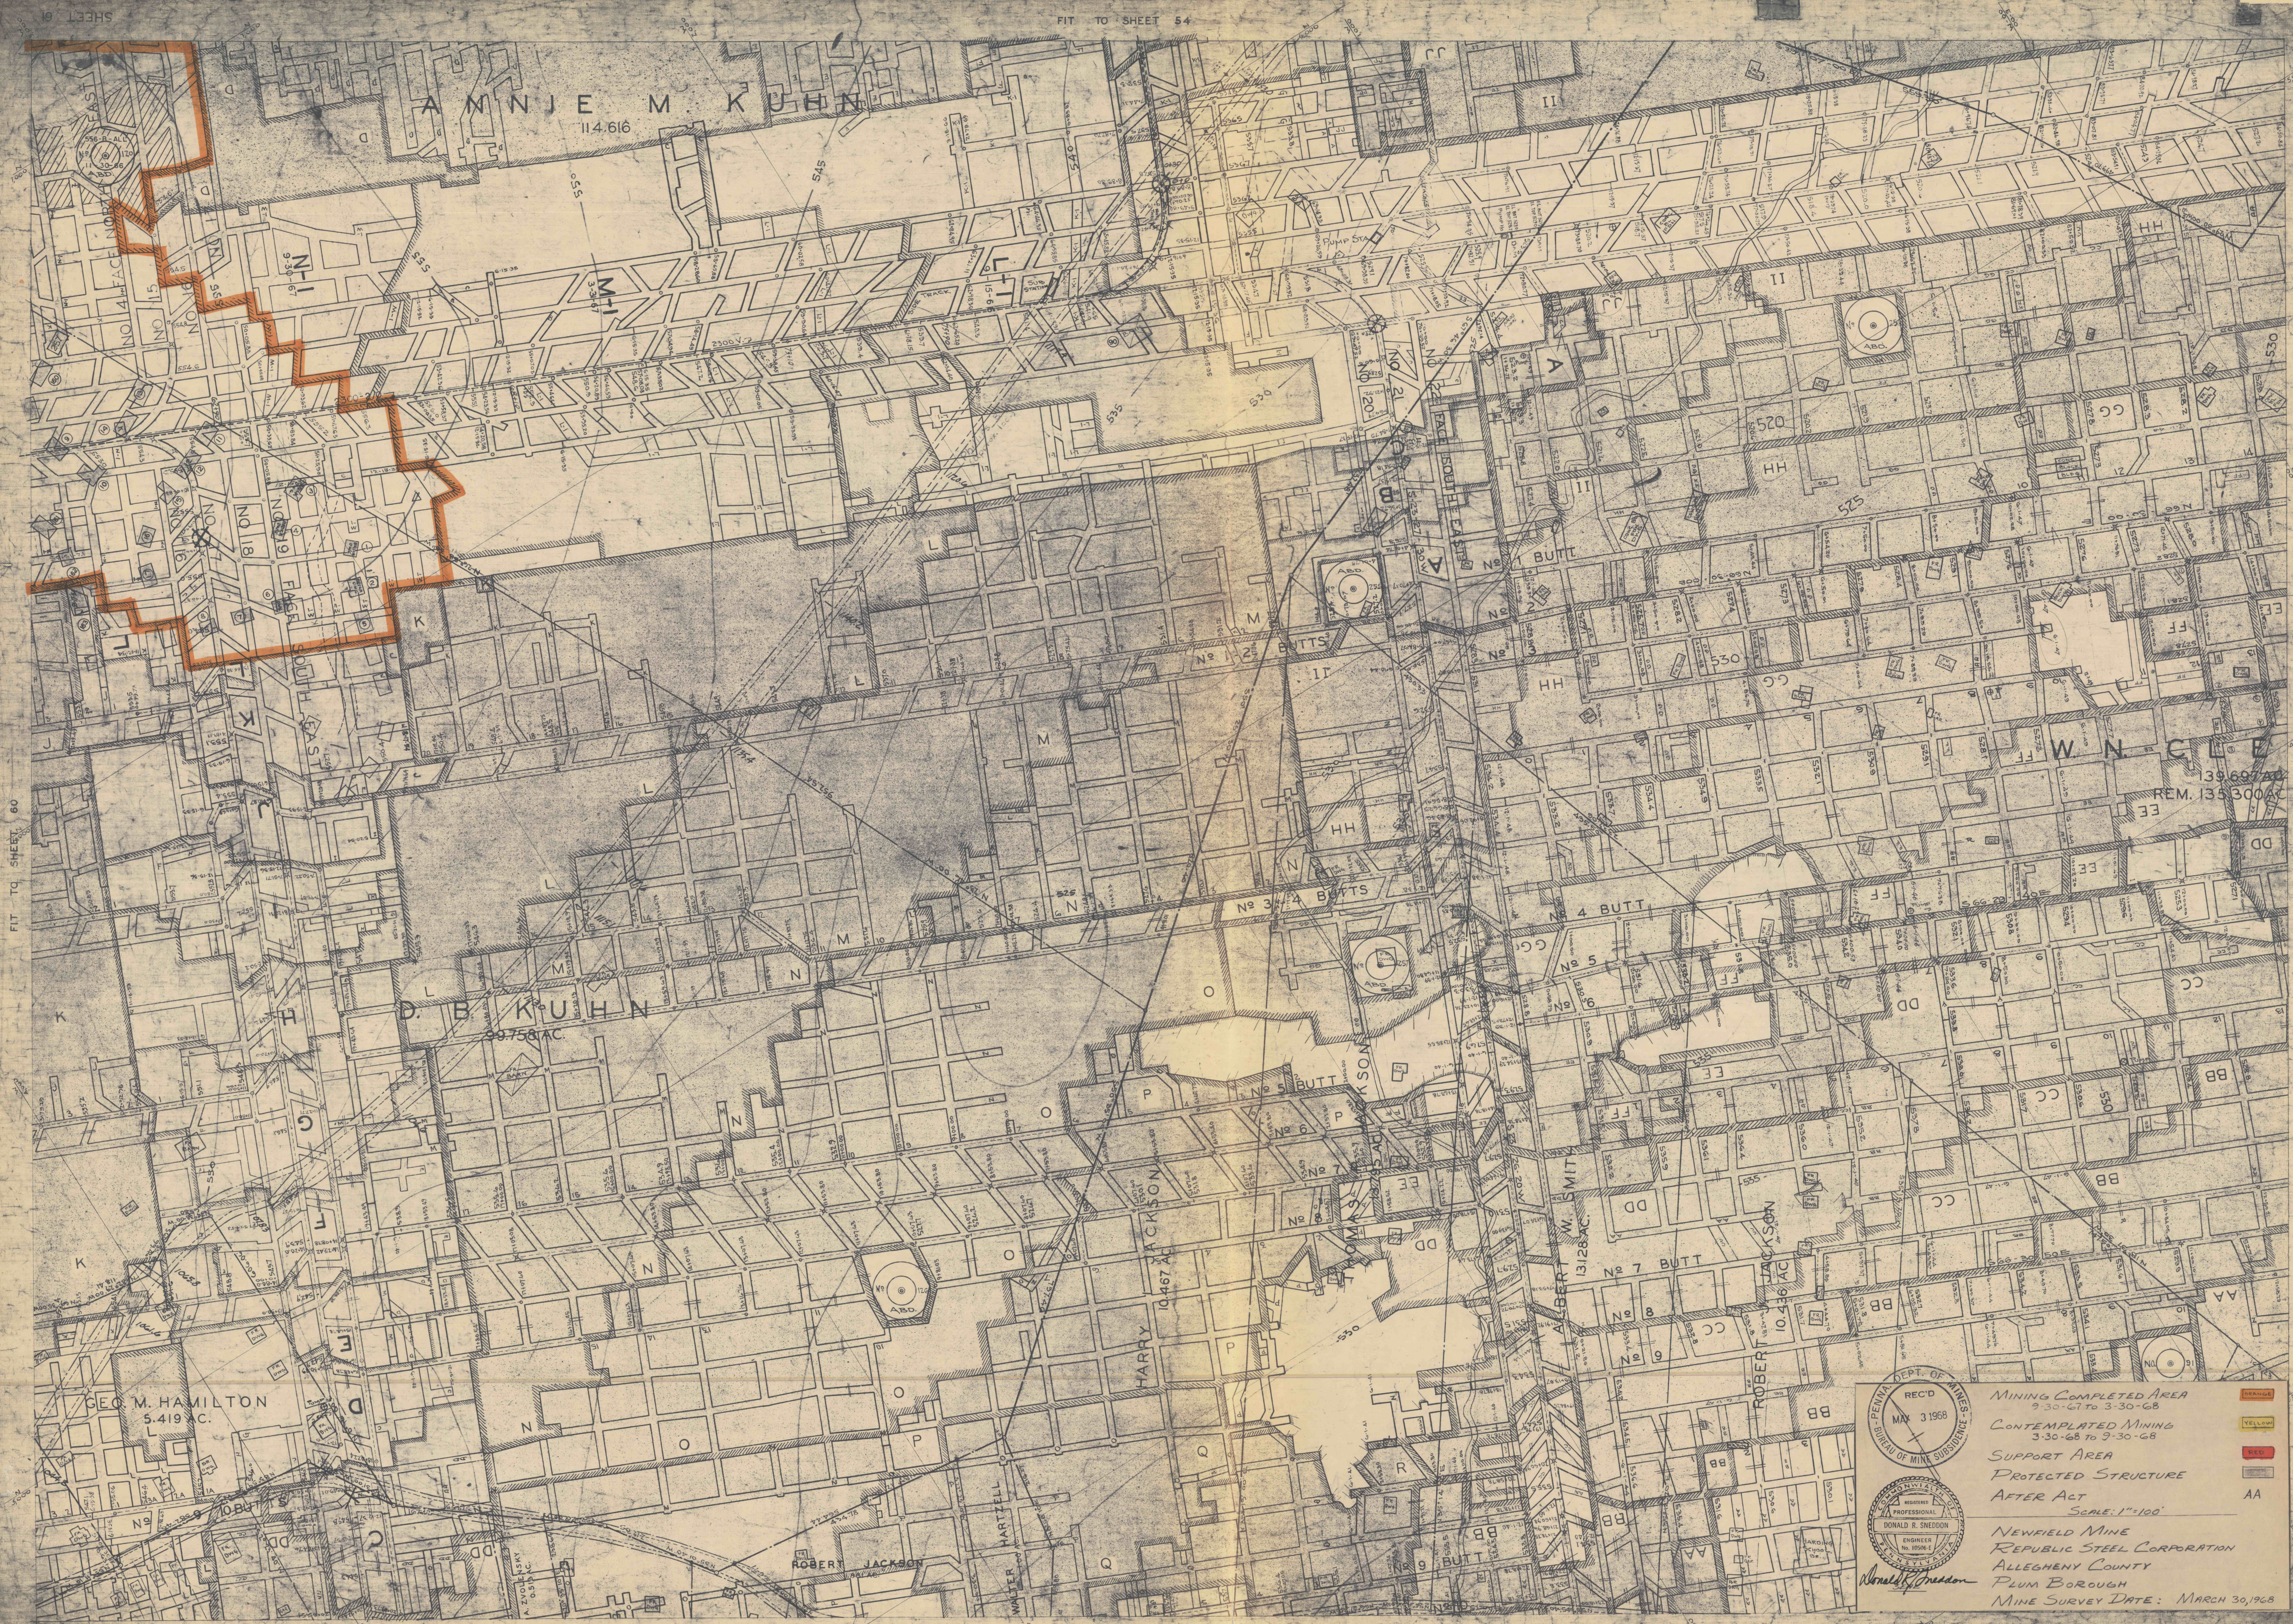

FIT TO SHEET 60

FIT TO SHEET 54

FIT TO SHEET 62

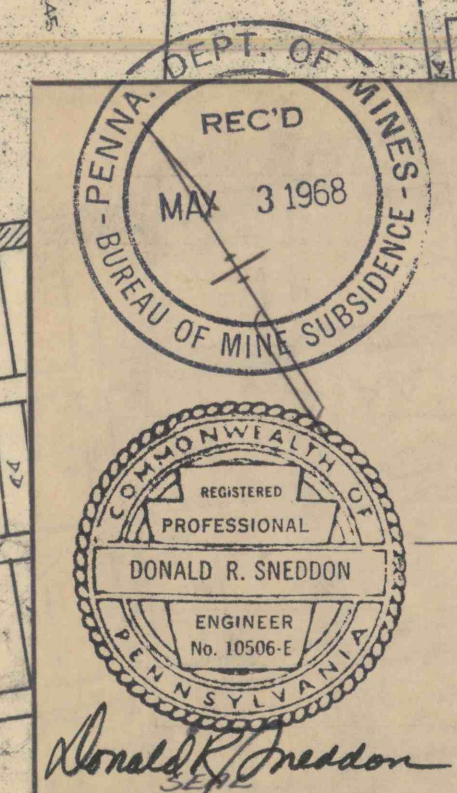

MINING COMPLETED AREA
9-30-67 to 3-30-68
CONTEMPLATED MINING
3-30-68 to 9-30-68
SUPPORT AREA
PROTECTED STRUCTURE
AFTER ACT
Scale: 1"=100'
NEWFIELD MINE
REPUBLIC STEEL CORPORATION
ALLEGHENY COUNTY
PLUM BOROUGH
MINE SURVEY DATE: MARCH 30, 1968

FIT TO SHEET 68

MINE NO 6 SHEET 61