


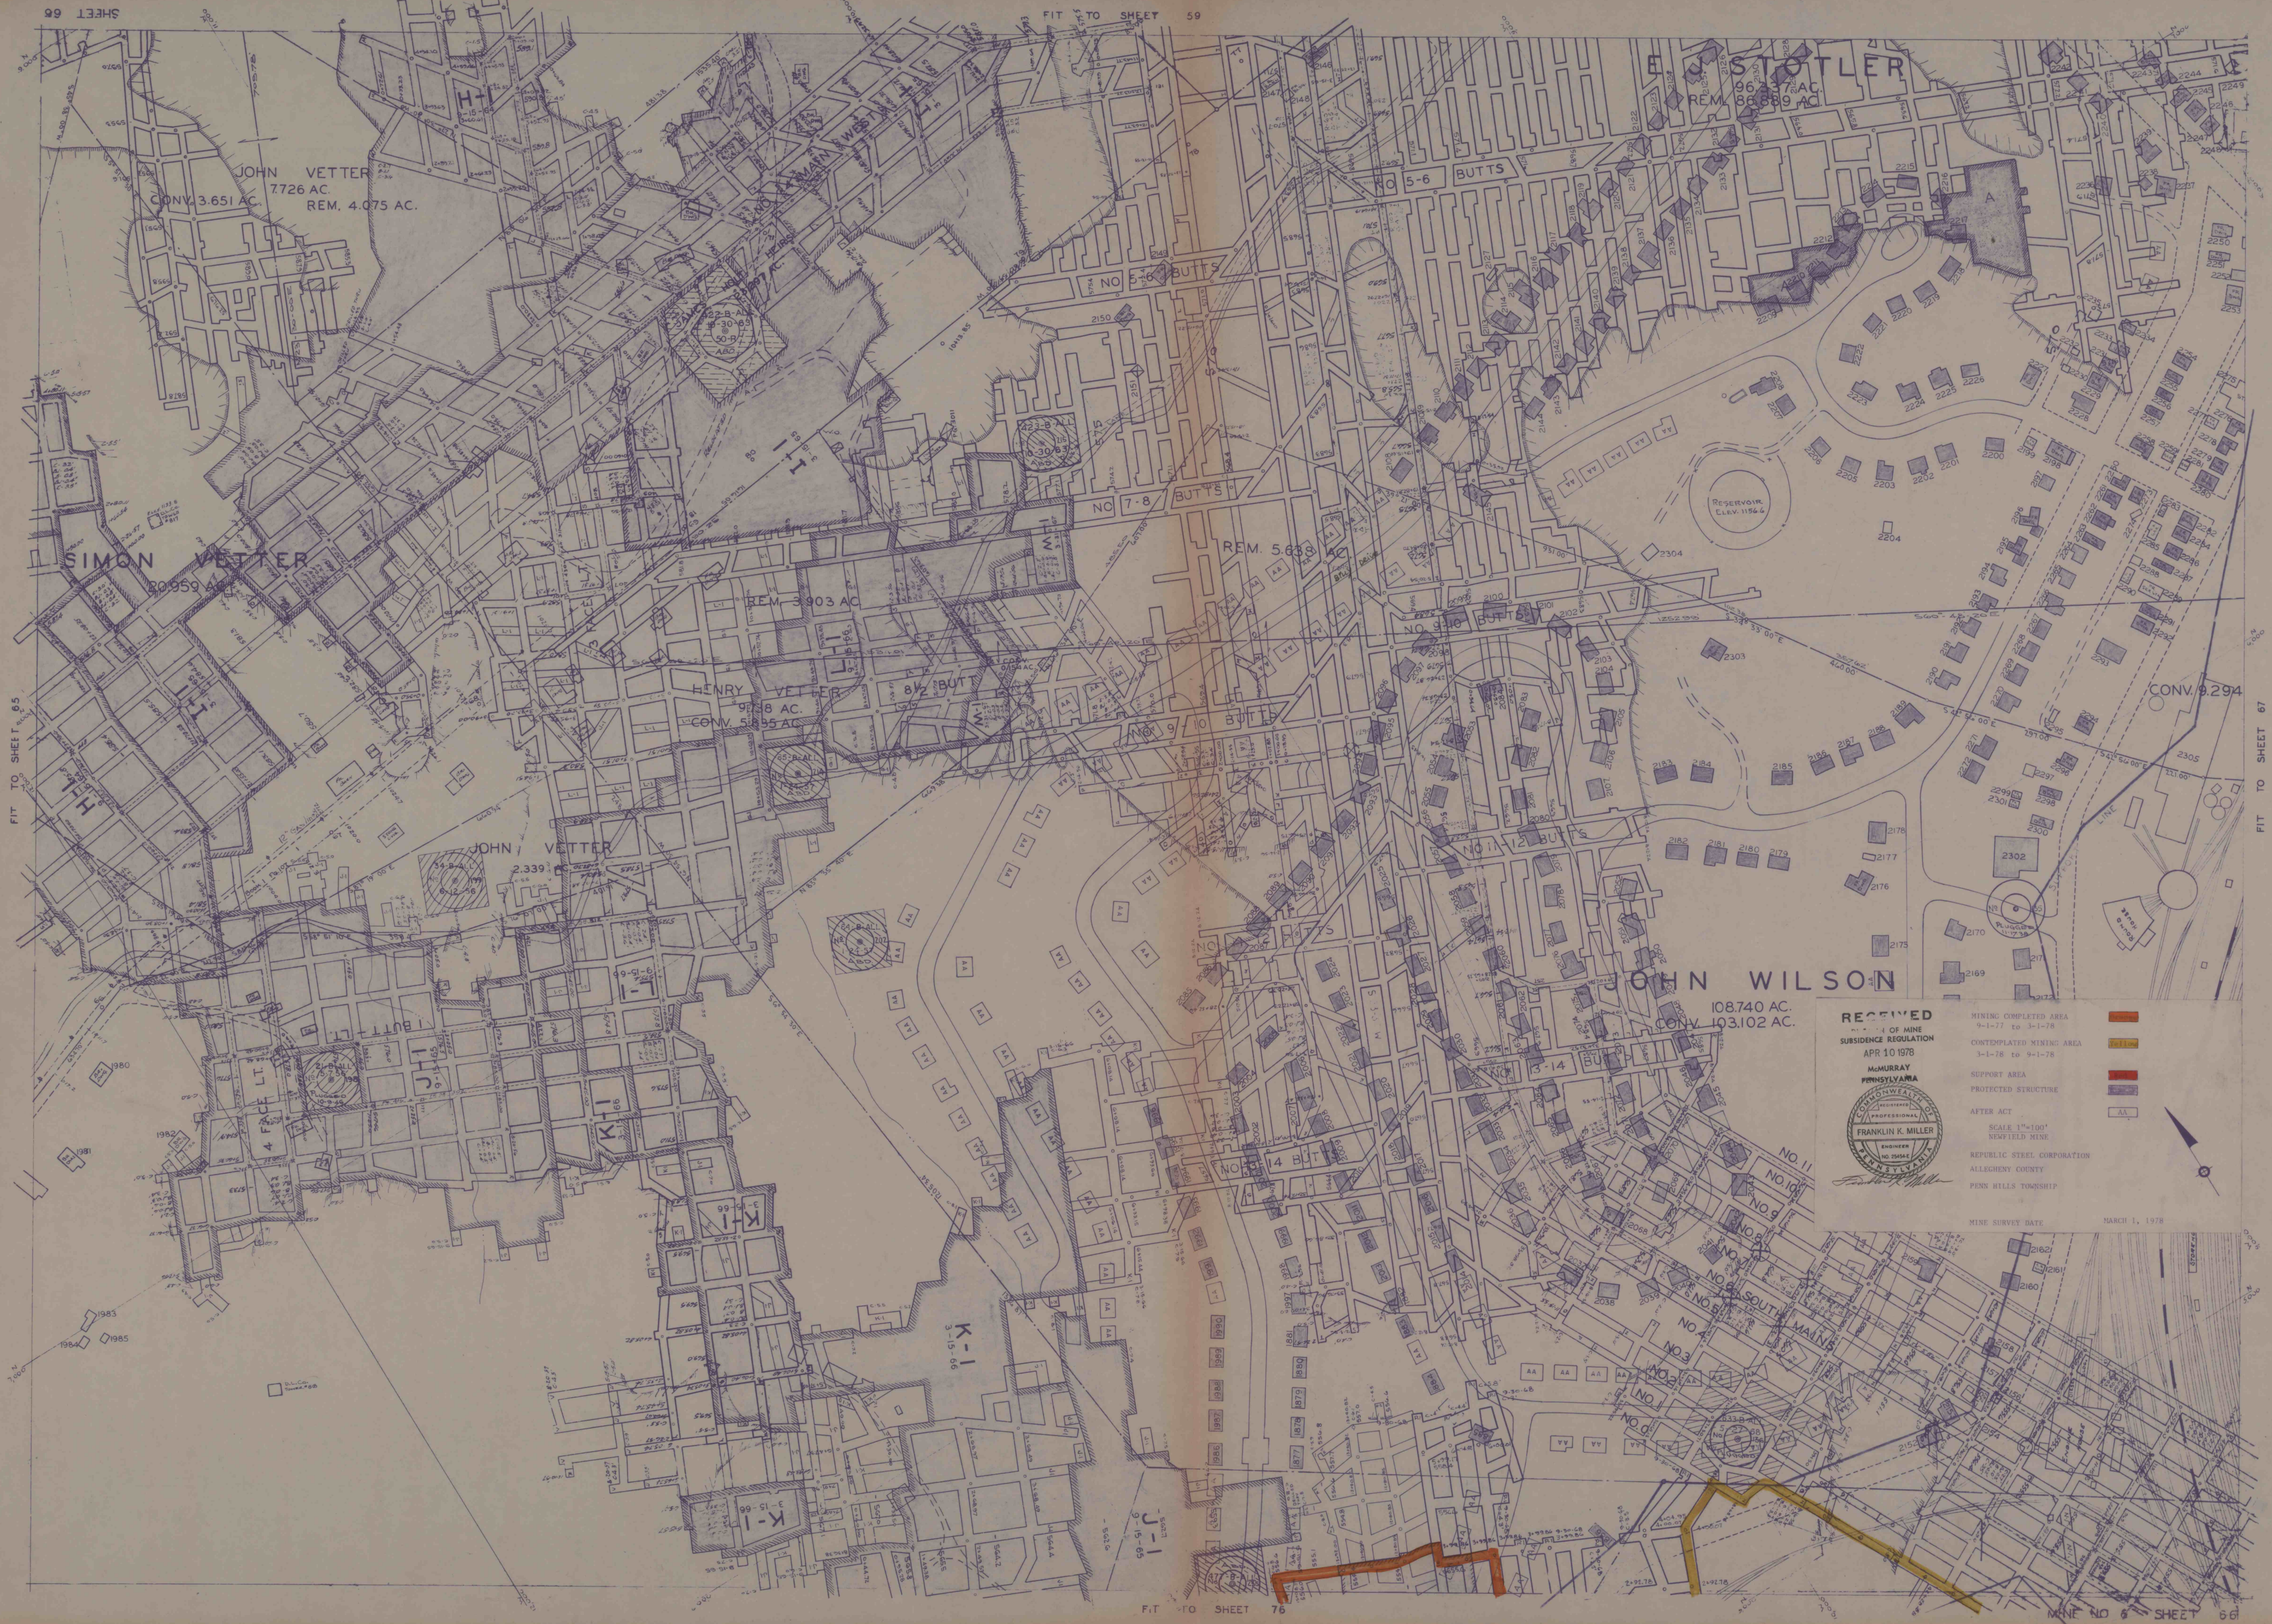

RECEIVED  
OFFICE OF MINE  
SUBSIDENCE REGULATION  
APR 10 1978  
McMURRAY  
PENNSYLVANIA  
FRANKLIN K. MILLER  
ENGINEER  
NO. 25454  
PENNSYLVANIA

- MINING COMPLETED AREA 9-1-77 to 3-1-78
- CONTEMPLATED MINING AREA 3-1-78 to 9-1-78
- SUPPORT AREA
- PROTECTED STRUCTURE
- AFTER ACT
- SCALE 1"=100'
- NEWFIELD MINE
- REPUBLIC STEEL CORPORATION
- ALLEGHENY COUNTY
- PENN HILLS TOWNSHIP

MINE SURVEY DATE MARCH 1, 1978