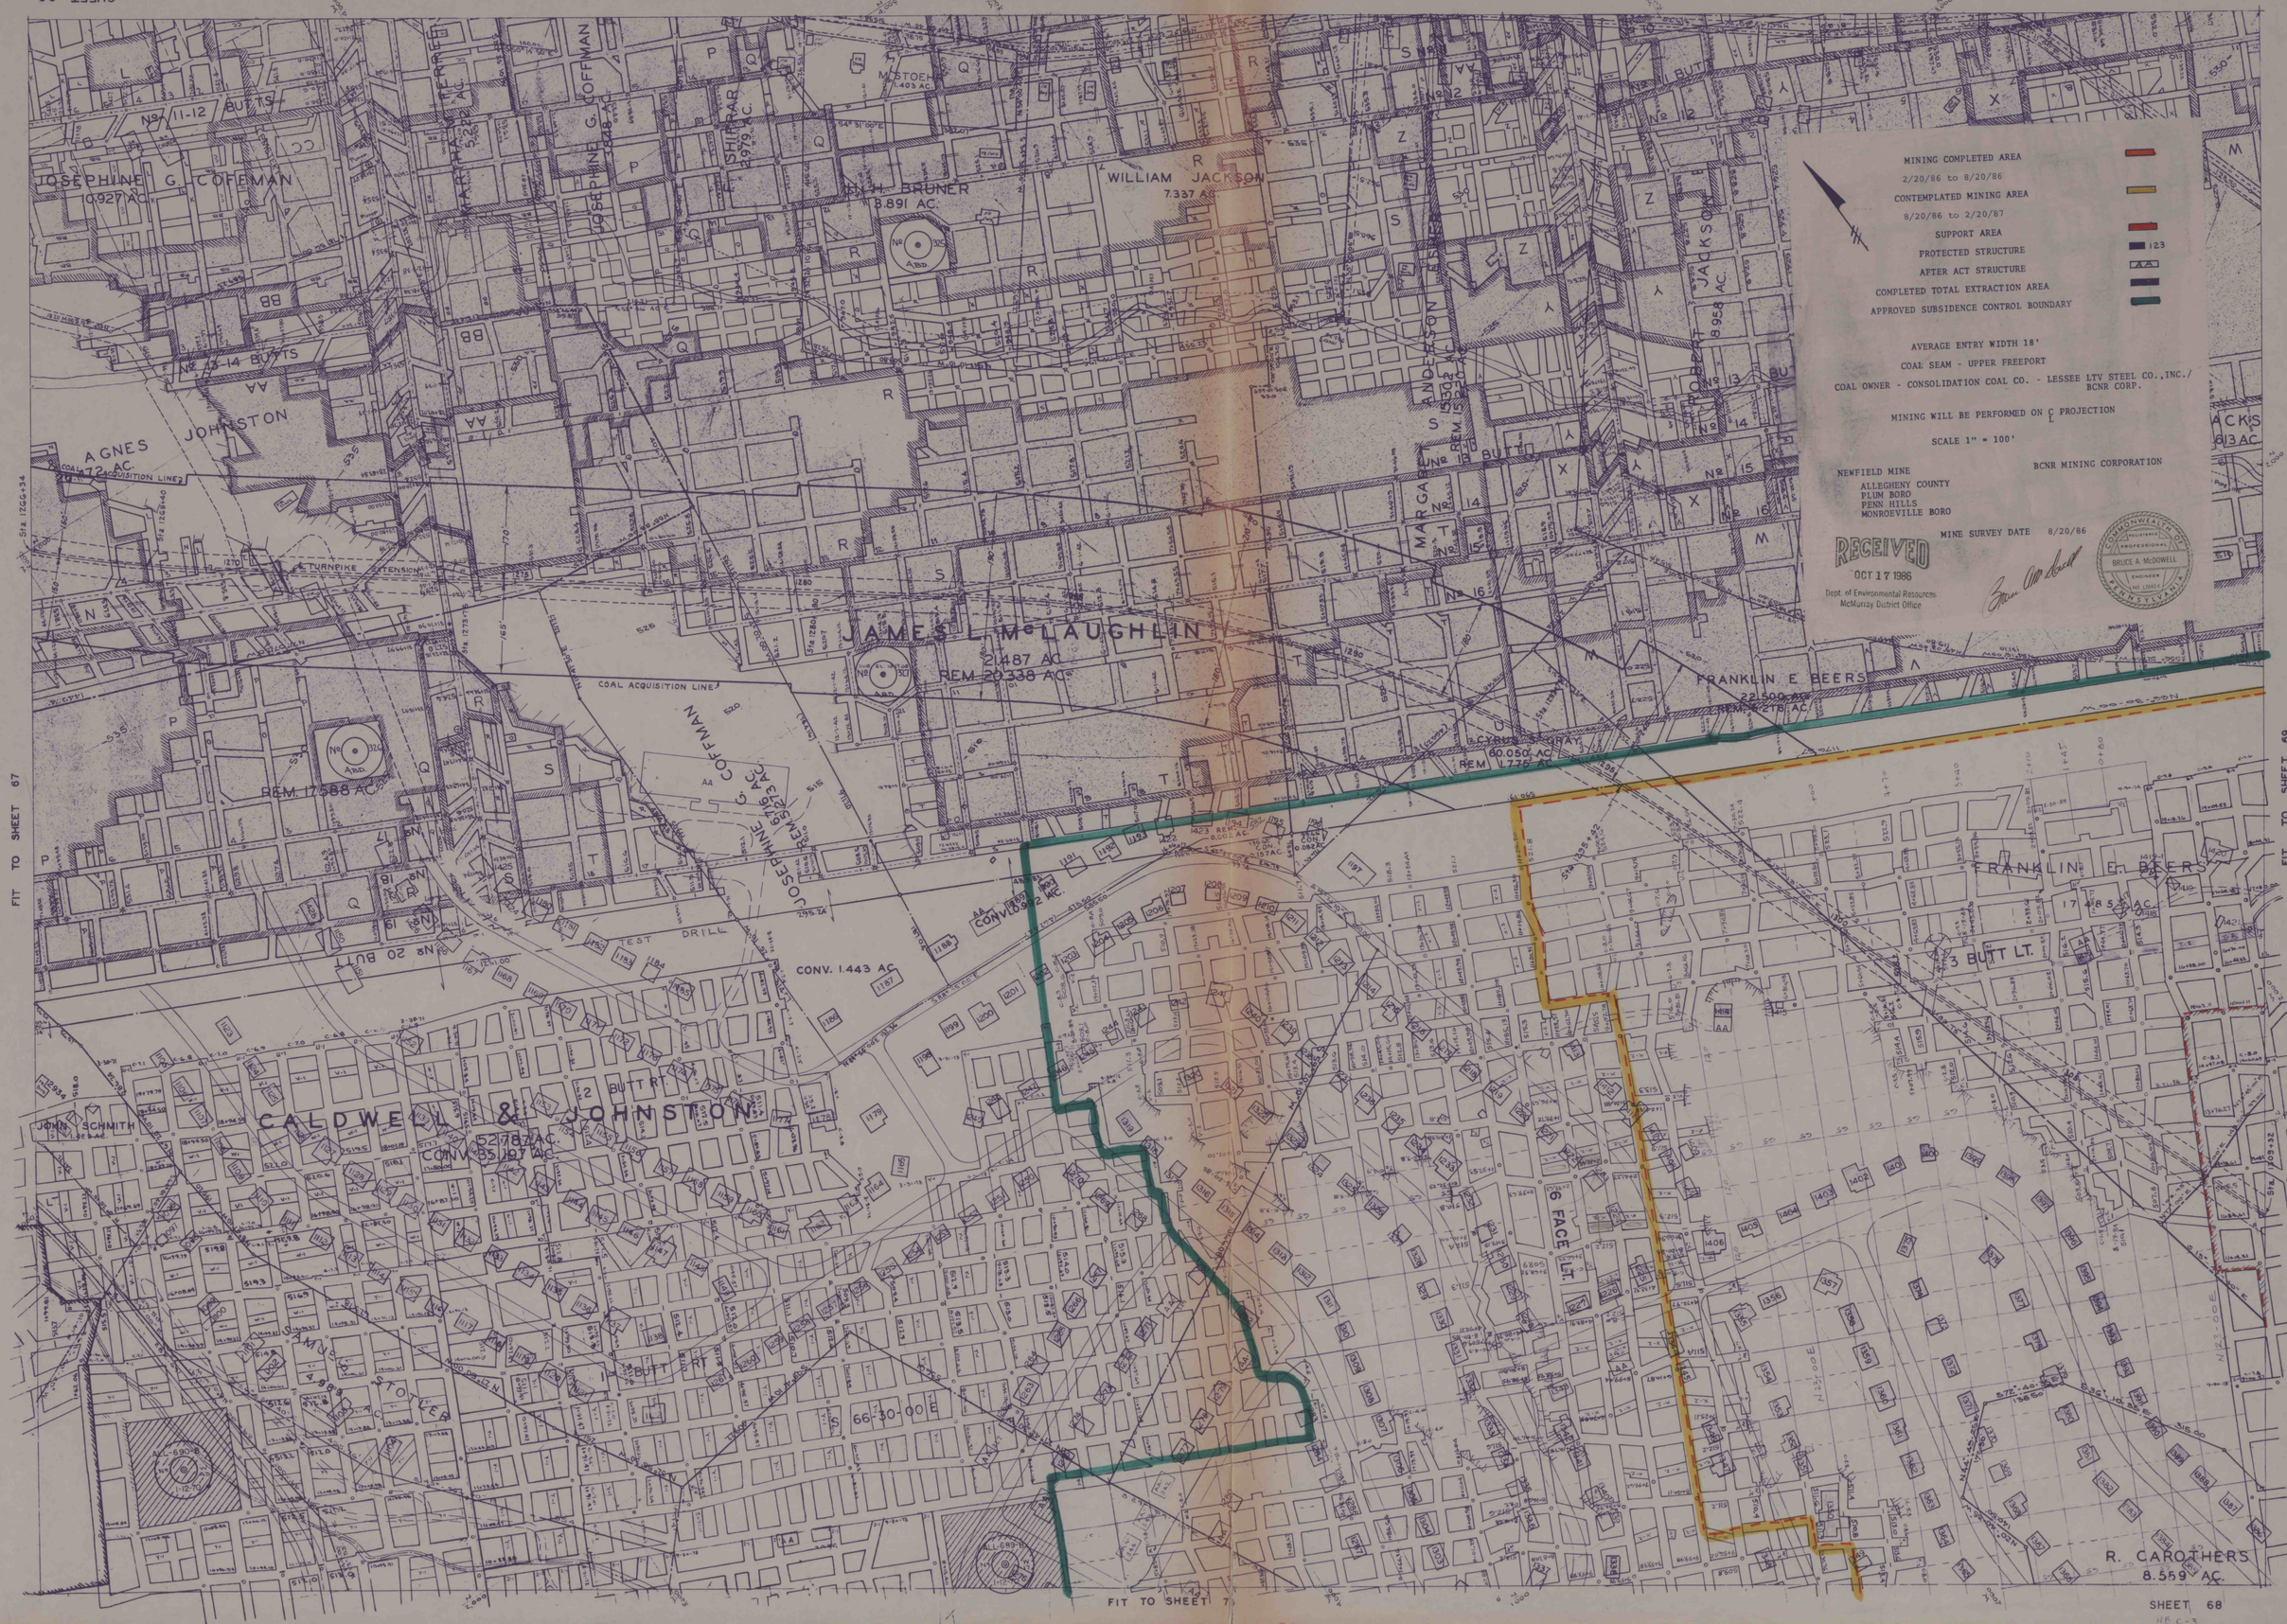
MINING COMPLETED AREA
2/20/86 to 8/20/86
CONTEMPLATED MINING AREA
8/20/86 to 2/20/87
SUPPORT AREA
PROTECTED STRUCTURE
AFTER ACT STRUCTURE
COMPLETED TOTAL EXTRACTION AREA
APPROVED SUBSIDENCE CONTROL BOUNDARY
AVERAGE ENTRY WIDTH 18'
COAL SEAM - UPPER FREEPORT
COAL OWNER - CONSOLIDATION COAL CO. - LESSEE LTV STEEL CO.,INC./ BCNR CORP.
MINING WILL BE PERFORMED ON ℄ PROJECTION
SCALE 1" = 100'
NEWFIELD MINE
ALLEGHENY COUNTY
PLUM BORO
PENN HILLS
MONROEVILLE BORO
BCNR MINING CORPORATION
MINE SURVEY DATE 8/20/86
RECEIVED
OCT 17 1986
Dept. of Environmental Resources
McMurray District Office
COMMONWEALTH OF PENNSYLVANIA
REGISTERED PROFESSIONAL ENGINEER
BRUCE A. McDOWELL
JOSEPHINE G. COFFMAN
10.927 AC.
M. H. BRUNER
3.891 AC.
WILLIAM JACKSON
7.337 AC.
AGNES
JOHNSTON
COAL ACQUISITION LINE
TURNPIKE EXTENSION
JAMES L. McLAUGHLIN
21.487 AC.
REM. 20.338 AC.
FRANKLIN E. BEERS
22.509 AC.
REM. 4.218 AC.
CYRUS STRAY
60.050 AC.
REM. 1.775 AC.
REM. 17.588 AC.
JOSEPHINE G. COFFMAN
TEST DRILL
CONV. 1.443 AC.
CONV. 0.022 AC.
FRANKLIN E. BEERS
17.485 AC.
3 BUTT LT.
JOHN SCHMITH
CALDWELL & JOHNSTON
52.787 AC.
CONV. 35.107 AC.
2 BUTT
1 BUTT
S 66°30'00" E
6 FACE LT.
R. CAROTHERS
8.559 AC.
FIT TO SHEET 67
FIT TO SHEET 69
FIT TO SHEET 7
SHEET 68