


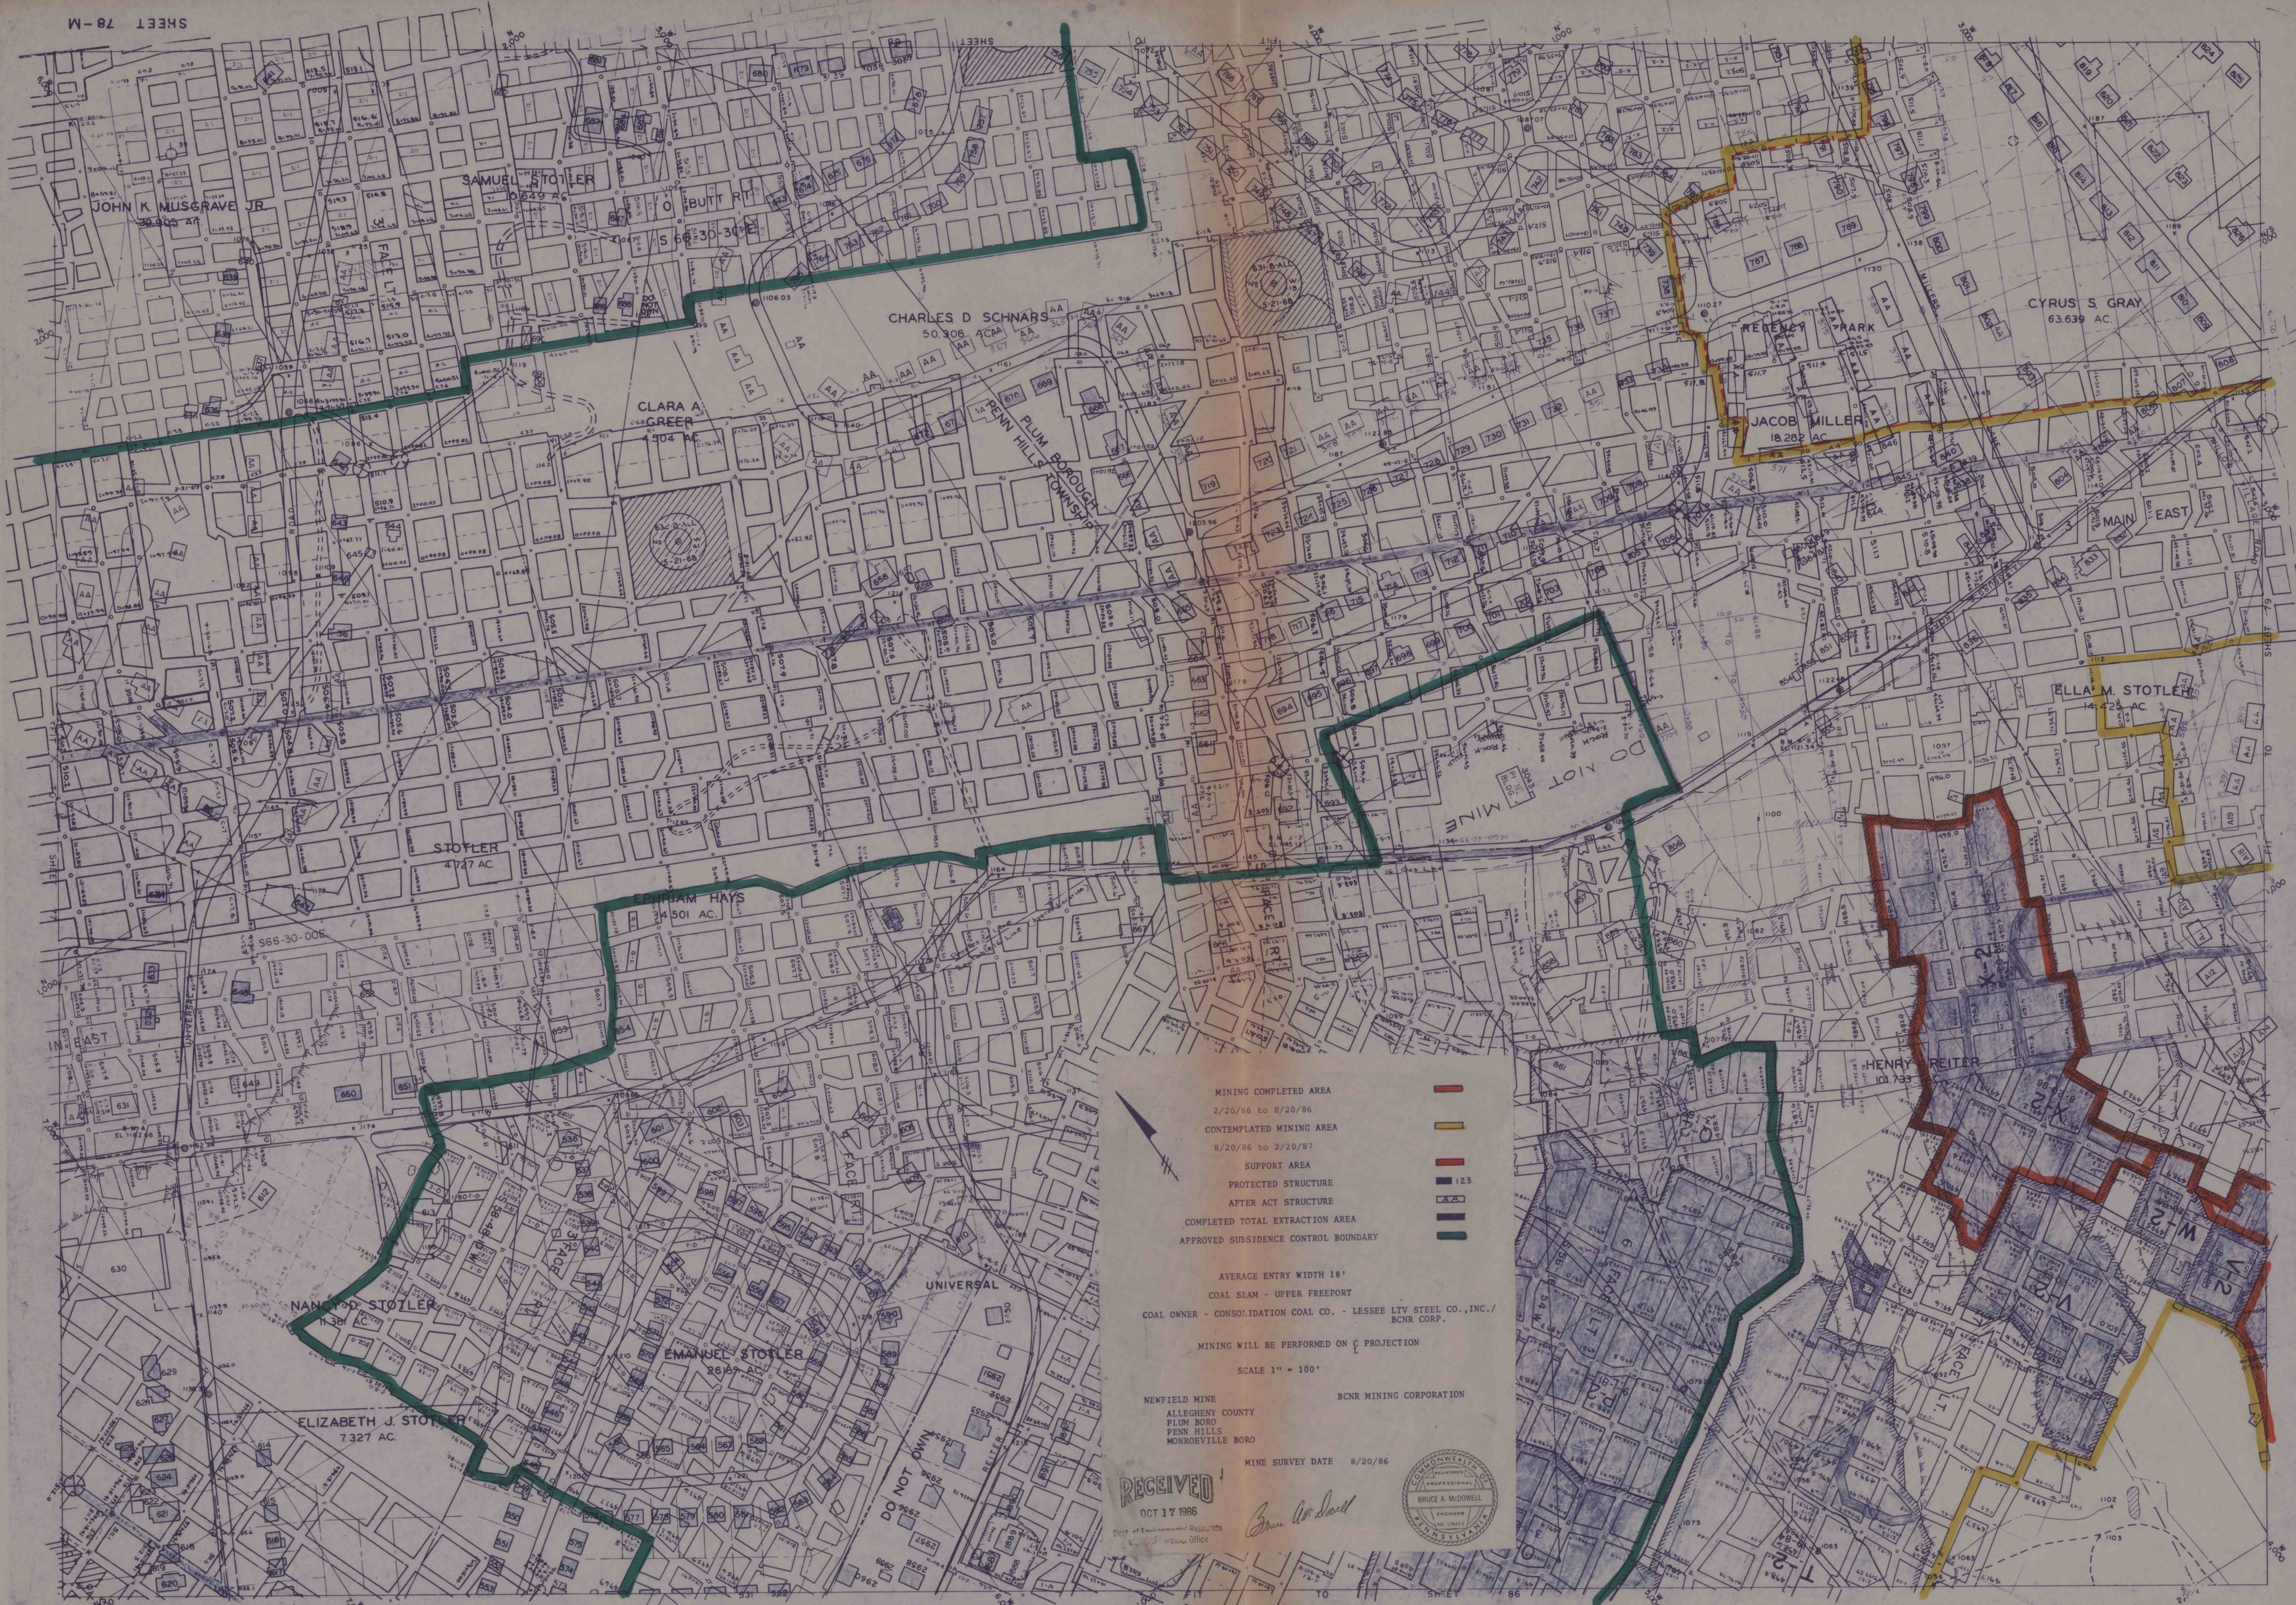

MINING COMPLETED AREA  
2/20/86 to 8/20/86  
CONTEMPLATED MINING AREA  
8/20/86 to 2/20/87  
SUPPORT AREA  
PROTECTED STRUCTURE  
AFTER ACT STRUCTURE  
COMPLETED TOTAL EXTRACTION AREA  
APPROVED SUBSIDENCE CONTROL BOUNDARY

AVERAGE ENTRY WIDTH 18'  
COAL SEAM - UPPER FREEPORT  
COAL OWNER - CONSOLIDATION COAL CO. - LESSEE LTV STEEL CO., INC./  
BCNR CORP.

MINING WILL BE PERFORMED ON C PROJECTION

SCALE 1" = 100'

NEWFIELD MINE  
ALLEGHENY COUNTY  
PLUM BORO  
PENN HILLS  
MONROEVILLE BORO

BCNR MINING CORPORATION

MINE SURVEY DATE 8/20/86

RECEIVED  
OCT 17 1986  
DEPT. OF ENVIRONMENTAL PROTECTION  
DIVISION OF MINES

BRUCE A. McDOWELL  
ENGINEER  
PROFESSIONAL  
PENN. STATE