


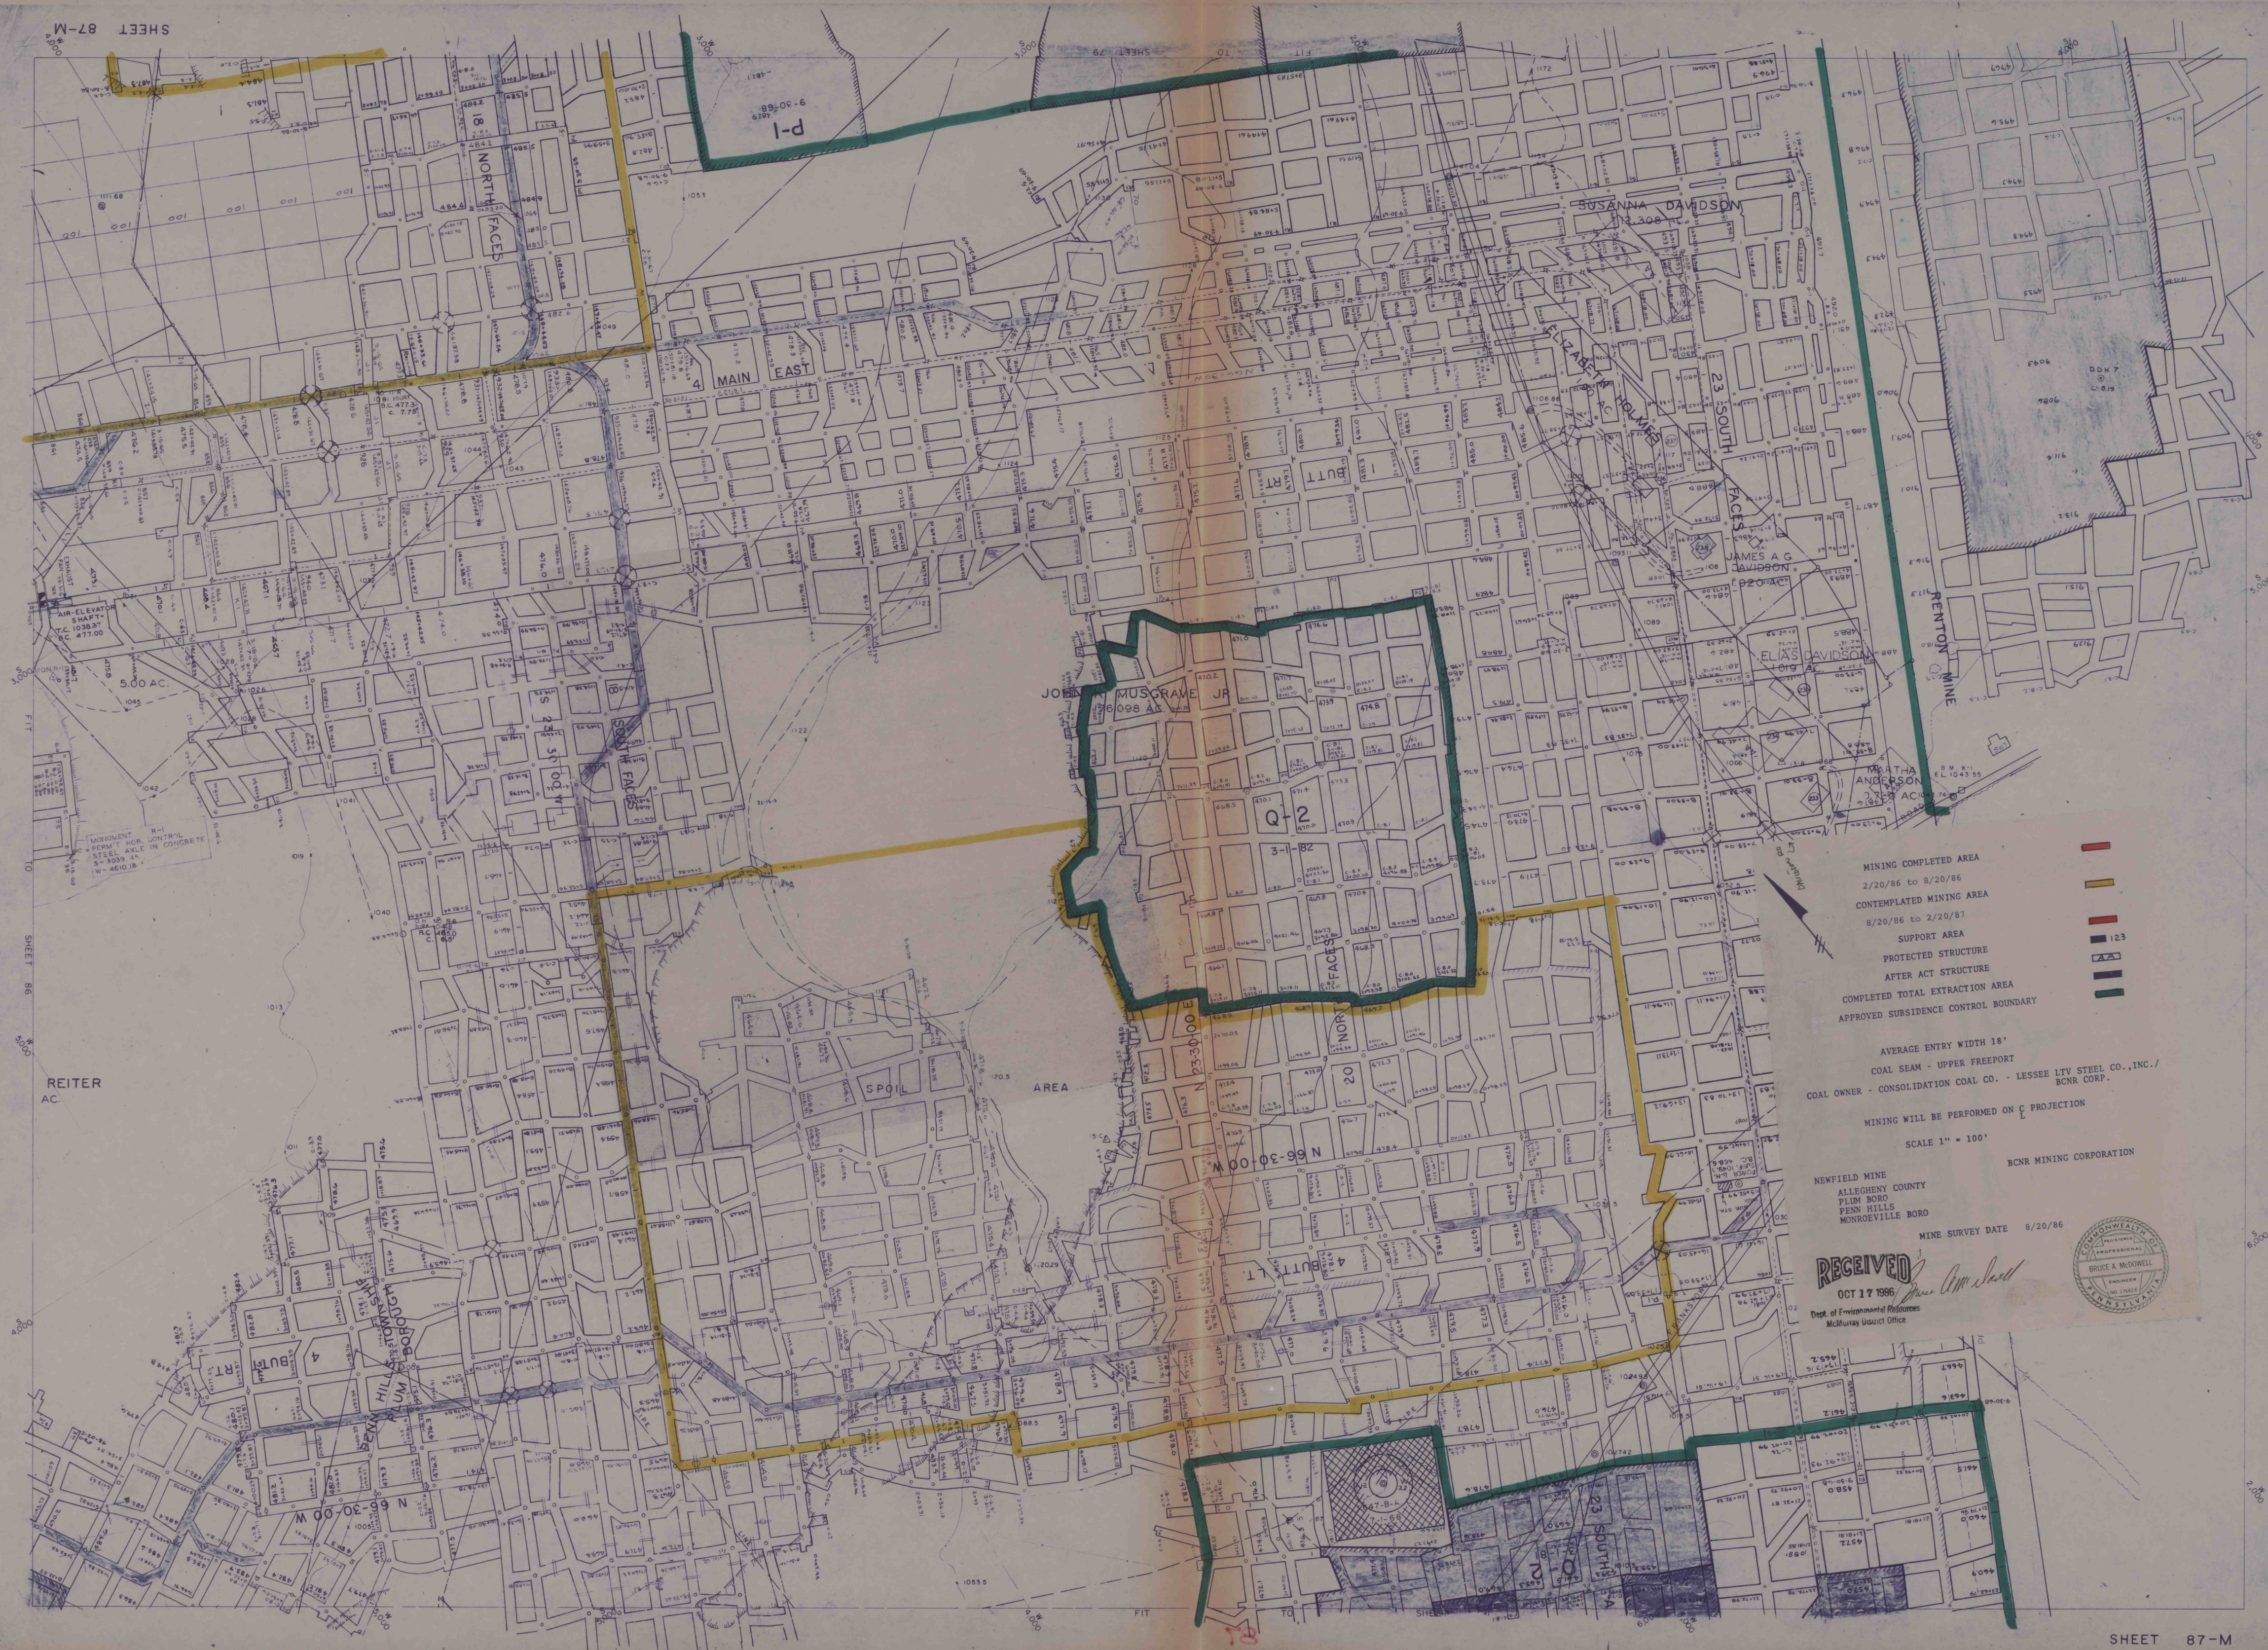

MINING COMPLETED AREA
2/20/86 to 8/20/86
CONTEMPLATED MINING AREA
8/20/86 to 2/20/87
SUPPORT AREA
PROTECTED STRUCTURE
AFTER ACT STRUCTURE
COMPLETED TOTAL EXTRACTION AREA
APPROVED SUBSIDENCE CONTROL BOUNDARY

AVERAGE ENTRY WIDTH 18'
COAL SEAM - UPPER FREEPORT
COAL OWNER - CONSOLIDATION COAL CO. - LESSEE LTV STEEL CO., INC./
BCNR CORP.
MINING WILL BE PERFORMED ON C PROJECTION
SCALE 1" = 100'

BCNR MINING CORPORATION
NEWFIELD MINE
ALLEGHENY COUNTY
PLUM BORO
PENN HILLS
MONROEVILLE BORO

MINE SURVEY DATE 8/20/86
RECEIVED
OCT 17 1986
Dept. of Environmental Resources
McMurray District Office

