


RECEIVED
DIVISION OF MINE
SURVEILLANCE
JUL 27 1929
McMURRAY
PENNSYLVANIA

DUQUESNE LIGHT CO.
COAL DEPARTMENT
WARWICK MINE NO. 2
SCALE: 1"=100'
MONONGAHELA TWP., GREENE COUNTY, PA.

John D. Staher
RPS 24308

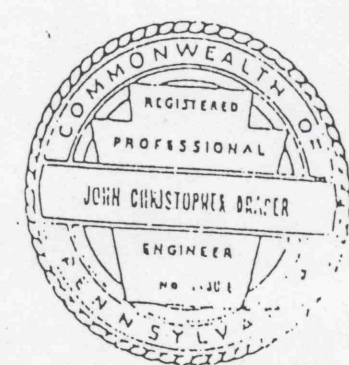

LEGEND

FINAL MAP. MINING WAS COMPLETED AT
THE END OF 6-22-79.

PROPERTY LINE
PROTECTED STRUCTURES
UNPROTECTED STRUCTURES (NEW, AFTER LAW)
STRUCTURES DEMOLISHED

1-10-25
1-10-25-A
1-10-25-B

FINAL