


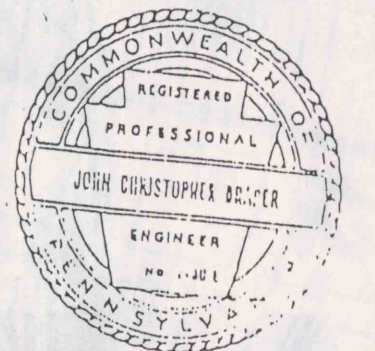

DUQUESNE LIGHT CO.
COAL DEPARTMENT
WARWICK MINE NO. 2
SCALE: 1"=100'
MONONGAHELA TWP., GREENE COUNTY, PA.

J. H. D. Dwyer
RPS 24306



RECEIVED
DIVISION OF MINE
SUBSIDENCE REGULATION
JUL 27 1979
McMURRAY
PENNSYLVANIA

LEGEND
FINAL MAP. MINING WAS COMPLETED AT
THE END OF 6-22-79.

PROPERTY LINE
PROTECTED STRUCTURES
UNPROTECTED STRUCTURES (NEW, AFTER LAW)
STRUCTURES DEMOLISHED