


No. 6

WARWICK MINE NO. 2
PITTSBURGH COAL



DUQUESNE LIGHT CO.
COAL DEPARTMENT
WARWICK MINE NO. 2
SCALE: 1"=100'
MONONGAHELA TWP., GREENE COUNTY, PA.


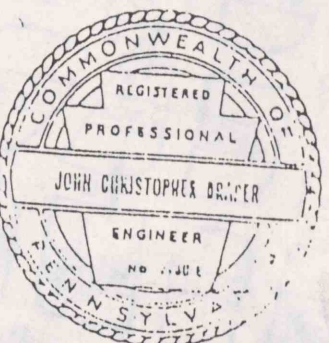

LEGEND

FINAL MAP MINING WAS COMPLETED AT
THE END OF 6-22-79.

PROPERTY LINE
PROTECTED STRUCTURES
UNPROTECTED STRUCTURES (NEW, AFTER LAW)
STRUCTURES DEMOLISHED

1-10-28
1-10-25-A
1-10-25-B

DUQUESNE LIGHT CO.
WARWICK MINE NO. 2
PITTSBURGH COAL

No. 6

FINAL

Sh 6